

SITE INSPECTION SHEET

OWNER: H. Colburn PHONE #: _____

ADDRESS: 4705 MANOR LN CONTRACTOR: N/A

WELL TAG #: None - well in house

SUBDIVISION: _____ LOT: _____ COUNTY #: _____

PROPOSAL: Support BO0150880 / NEED SEPTIC NOTES & Soil profile
STORAGE SHED / SHOP W/ NO BATHROOMS
(two bedroom)

LOCATION DIAGRAM



COMMENTS: 11-13-04 Septic tank full to grade. Need repair Well is in the basement. Tyock to call to schedule repair.

DATE: 11-13-04 INSPECTOR: Race Thomas

Neighbor property

H-4-dcl

1/21/05
BP#150880

OK

FOR
SHED/SHOP

1/19/05

SEPTIC REPAIR

DONE

OKD ON



1/19/05

- ① NEED Potable well & septic ON PLAN
- ② NEED TO UNCOVER CLEANOUTS OF S.T. & dry well to verify effluent levels @ insp. adequate



-OR-
Have septic contractor inspect system & pump tank / send department of pumping S. Tank

Neighbor Property

Neighbor Property

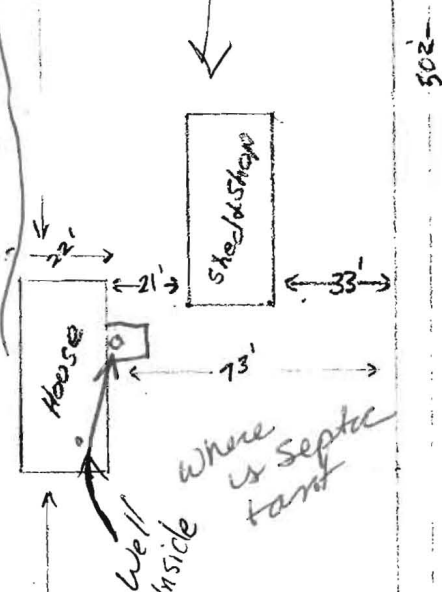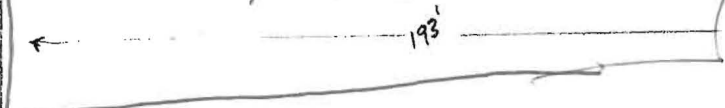

GIS - soils map = Mac
BA soils ≈ 347' from the west.

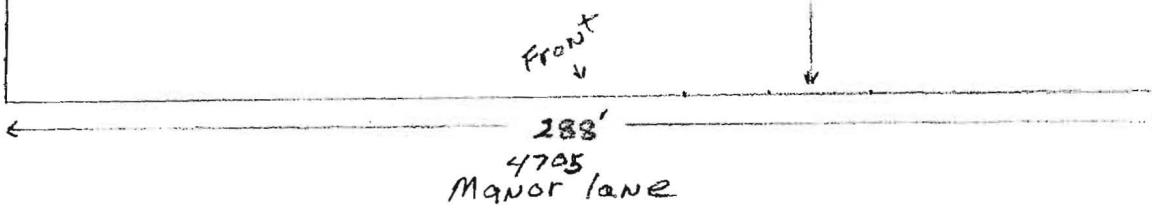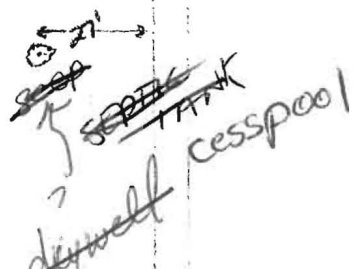

Scale 48' per 1"