

Permit

APPLICATION

SEWAGE DISPOSAL TESTING

STATE OF MARYLAND - DEPARTMENT OF HEALTH AND MENTAL HYGIENE

HOWARD COUNTY HEALTH DEPARTMENT
ENVIRONMENTAL HEALTH SERVICES

P. O. BOX 476 ELLICOTT CITY, MARYLAND 21043
TELEPHONE: 992-2330

A 33525

P _____

DISTRICT 5

DATE 1-30-84

TO: THE COUNTY HEALTH OFFICER
ELLICOTT CITY, MARYLAND

I, HEREBY, APPLY FOR THE NECESSARY TEST IN ORDER TO CONSTRUCT (OR RECONSTRUCT) A SEWAGE DISPOSAL SYSTEM.

PROPERTY OWNER ANNA Mac Carthy

ADDRESS 4400 Cathedral Ave DC 20016 PHONE 202-363-2725

PROPERTY LOCATION: BRIGHTON PINES I //

SUBDIVISION Propriet Prop LOT NO. 36

ROAD AND DESCRIPTION Nicholas Dr.

SIZE OF LOT 3A TYPE BLDG. SFD
(NUMBER OF BEDROOMS)

THE SYSTEM INSTALLED UNDER THIS APPLICATION IS ACCEPTABLE ONLY UNTIL PUBLIC FACILITIES BECOME AVAILABLE. I FULLY UNDERSTAND THE FEE CONNECTED WITH THE FILING OF THIS PERC TEST APPLICATION IS NON-REFUNDABLE UNDER ANY CIRCUMSTANCES. I ALSO AGREE TO COMPLY WITH ALL M.O.S.H.A. REQUIREMENTS IN TESTING THIS LOT.

Richard J. Demmitt 465-0842
(SIGNATURE OF APPLICANT)

APPROVED BY _____ FOR _____ DATE _____


REJECTED BY _____ FOR _____ DATE _____

HOLD PENDING FURTHER TESTS _____ DATE _____



REASONS FOR REJECTION OR HOLDING _____

THIS IS NOT A PERMIT

#1's
1-2-4
SOIL PROFILE

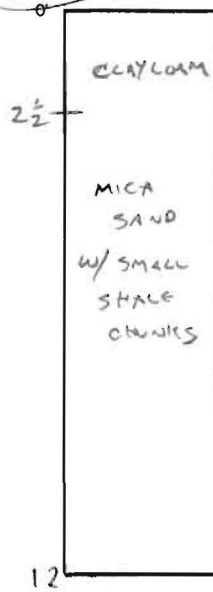

#3

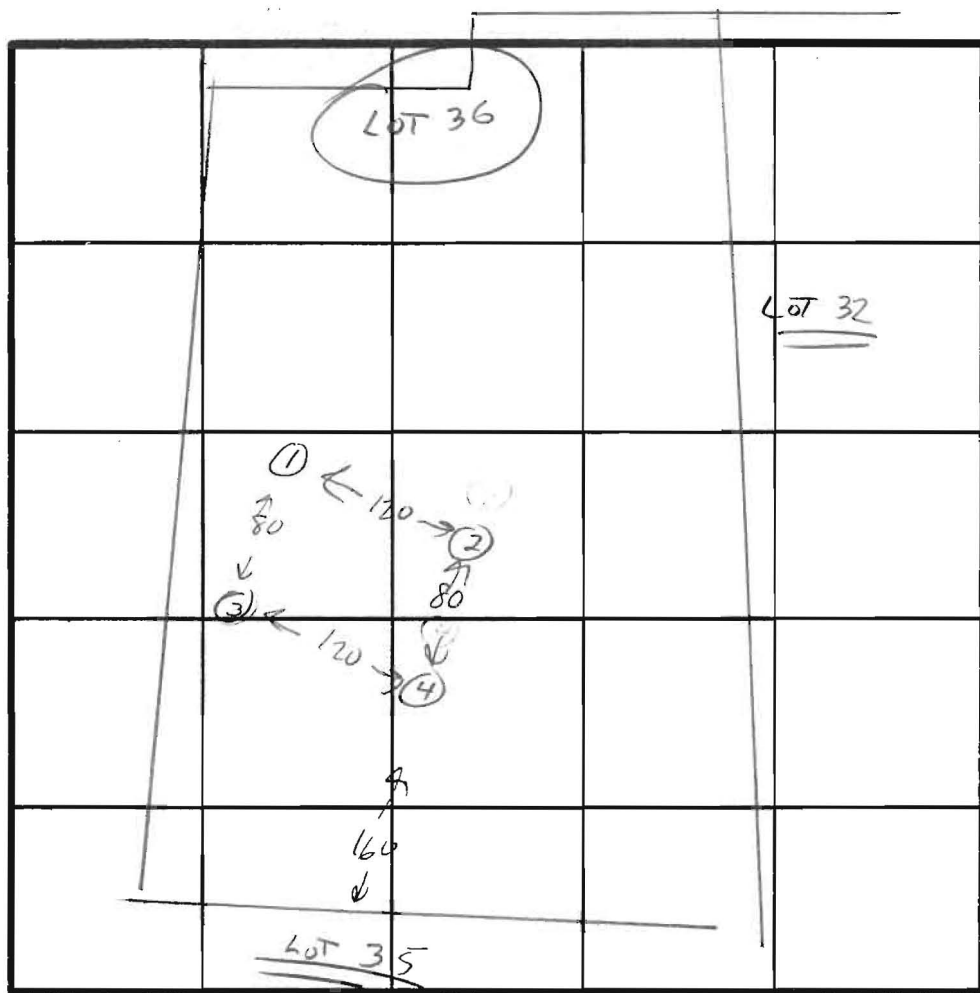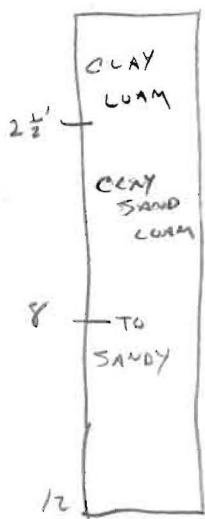

INDICATE NORTH - NAME ADJOINING ROADWAY AS BASE LINE.

DATE	TEST NO.	DEPTH	PRE-WET		TEST - 1" DROP		TIME
			START	STOP	START	STOP	
2-15-84	1	4	10:54	10:56	10:56	10:58	2 MIN
		8	10:54	10:56	10:56	10:58	
		12					
2-15-84	2	4	10:42	10:45	10:45	10:52	7 MIN
		8	10:42	10:44	10:44	10:56	
		12					
2-15-84	3	4	10:50	10:56	10:56	11:04	8 MIN
		8	10:50	10:53	10:53	10:56	
		12					
2-15-84	4	4	10:41	10:43	10:43	10:48	5 MIN
		8	10:41	10:43	10:43	10:45	
		12					

REMARKS WHERE IS ACCESS TO LOAD IN COMMOD

TYPE OF SOIL MICA SAND - FEW SMALL CHUNKS SHALE

TESTED BY C. William ALSO PRESENT DEMITT, CISSEL

EH-12-1079