

C 1 14589 SEQUENCE NO. (MDE USE ONLY)

STATE OF MARYLAND WELL COMPLETION REPORT FILL IN THIS FORM COMPLETELY PLEASE TYPE

THIS REPORT MUST BE SUBMITTED WITHIN 45 DAYS AFTER WELL IS COMPLETED.

COUNTY NUMBER 13 A 33525

ST/CO USE ONLY DATE Received MM DD YY 8 13

DATE WELL COMPLETED MM DD YY 9 26 02

Depth of Well 240 (TO NEAREST FOOT)

PERMIT NO. FROM "PERMIT TO DRILL WELL" 110-99-3507

OWNER SELECT HOMES last name first name STREET OR RFD LAKESIDE DRIVE TOWN CHARLESVILLE SUBDIVISION BRIGHTON PINES SECTION LOT 11

WELL LOG Not required for driven wells STATE THE KIND OF FORMATIONS PENETRATED, THEIR COLOR, DEPTH, THICKNESS AND IF WATER BEARING

GROUTING RECORD WELL HAS BEEN GROUTED (Circle Appropriate Box) YES Y NO N TYPE OF GROUTING MATERIAL (Circle one) CEMENT CM BENTONITE CLAY BC NO. OF BAGS 14 NO. OF POUNDS 1316 GALLONS OF WATER 84 DEPTH OF GROUT SEAL (to nearest foot) from 0 ft. to 64 ft.

CASING RECORD casing types insert appropriate code below MAIN CASING TYPE ST Nominal diameter top (main) casing (nearest inch)! 6 Total depth of main casing (nearest foot) 64

OTHER CASING (if used) diameter inch depth (feet) from to

SCREEN RECORD screen type or open hole insert appropriate code below ST BR HO PL OT

NUMBER OF UNSUCCESSFUL WELLS: 0

WELL HYDROFRACTURED YES Y NO N

CIRCLE APPROPRIATE LETTER A A WELL WAS ABANDONED AND SEALED WHEN THIS WELL WAS COMPLETED E ELECTRIC LOG OBTAINED P TEST WELL CONVERTED TO PRODUCTION WELL

I HEREBY CERTIFY THAT THIS WELL HAS BEEN CONSTRUCTED IN ACCORDANCE WITH COMAR 26.04.04 "WELL CONSTRUCTION" AND IN CONFORMANCE WITH ALL CONDITIONS STATED IN THE ABOVE CAPTIONED PERMIT, AND THAT THE INFORMATION PRESENTED HEREIN IS ACCURATE AND COMPLETE TO THE BEST OF MY KNOWLEDGE.

DRILLERS LIC. NO. 1 MWD 523 DRILLERS SIGNATURE (MUST MATCH SIGNATURE ON APPLICATION)

LIC. NO. 1 JWD 346

SITE SUPERVISOR (sign. of driller or journeyman responsible for sitework if different from permittee)


DEPTH (nearest ft.) 1 2 3 76

GRAVEL PACK IF WELL DRILLED WAS FLOWING WELL INSERT F IN BOX 68

MDE USE ONLY (NOT TO BE FILLED IN BY DRILLER) T (E.R.O.S.) W Q TELESCOPE CASING LOG INDICATOR OTHER DATA

PUMPING TEST HOURS PUMPED (nearest hour) 3 PUMPING RATE (gal. per min.) 9 METHOD USED TO MEASURE PUMPING RATE bucket WATER LEVEL (distance from land surface) BEFORE PUMPING 50 ft. WHEN PUMPING 108 ft. TYPE OF PUMP USED (for test) S submersible

PUMP INSTALLED DRILLER INSTALLED PUMP (CIRCLE) (YES or NO) YES (NO) IF DRILLER INSTALLS PUMP, THIS SECTION MUST BE COMPLETED FOR ALL WELLS. TYPE OF PUMP INSTALLED PLACE (A,C,J,P,R,S,T,O) IN BOX 29. CAPACITY: GALLONS PER MINUTE (to nearest gallon) 31 35 PUMP HORSE POWER 37 41 PUMP COLUMN LENGTH (nearest ft.) 43 47 CASING HEIGHT (circle appropriate box and enter casing height) + above LAND SURFACE - below (nearest foot) 50 51

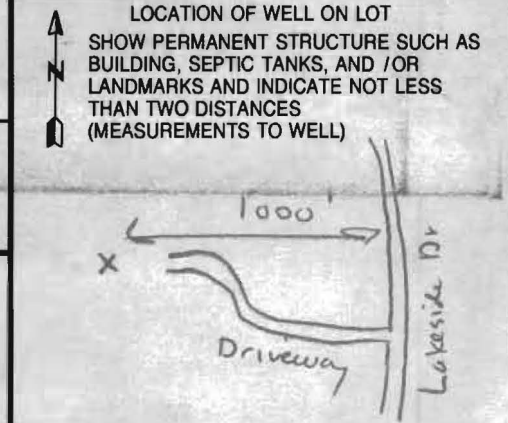

B 1 3597

SEQUENCE NO. (MDE USE ONLY)

STATE OF MARYLAND APPLICATION FOR PERMIT TO DRILL WELL

STATE PERMIT NUMBER

HD - 94 - 3507

517915 please type

fill in this form completely

Date Received (APA)

10 10 02

OWNER INFORMATION

Select Homes

48411 Surfside Drive

Lexington Park MD 20653

LOCATION OF WELL

Howard

Brighton Pines

SECTION 44 46 LOT 48 50

Clarksville

MILES FROM TOWN (enter 0 if in town) 3

DRILLER INFORMATION


Gregg Myers MWD 523

B L Myers Bros

5112 Pegasus Ct Suite V Frederick MD 21704

Signature Date 9/13/02

DIRECTION OF WELL FROM TOWN (CIRCLE BOX)

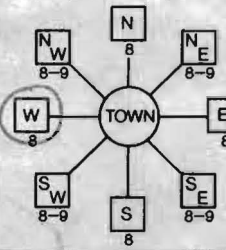

Lakeside Drive

ON WHICH SIDE OF ROAD (CIRCLE APPROPRIATE BOX)

34 1600 37 DISTANCE FROM ROAD

ENTER FT OR MI 38 39

TAX MAP: 34 BLK: 7 PARCEL 396

WELL INFORMATION

APPROX. PUMPING RATE (GAL. PER MIN.) 5

AVERAGE DAILY QUANTITY NEEDED (GAL. PER DAY) 500

USE FOR WATER (CIRCLE APPROPRIATE BOX)

- Domestic Potable Supply & Residential Irrigation (circled)
Farming (Livestock Watering & Agricultural Irrigation)
Industrial, Commercial, Dewatering
Public Water Supply Well
Test, Observation, Monitoring
Geo-Thermal

NOT TO BE FILLED IN BY DRILLER HEALTH DEPARTMENT APPROVAL

Howard A33525

COUNTY NAME COUNTY NO. STATE SIGNATURE INSERT S

DATE ISSUED 9/17/02

CO SIGNATURE EXP. DATE 9/17/03

APPROXIMATE DEPTH OF WELL 250 FEET

APPROXIMATE DIAMETER OF WELL 6 INCH

METHOD OF DRILLING (circle one)

- Bored (or Augered)
Jetted
Jetted & Driven
Air-Rotary
Air-PerCussion
Rotary (Hydraulic Rotary)
Cable
Reverse-Rotary
Drive-Point

REPLACEMENT OR DEEPEMED WELLS (CIRCLE APPROPRIATE BOX)

- This well will not replace an existing well (circled)
This well will replace a well that will be abandoned and sealed
This well will replace a well that will be used as a standby-contact local approving authority for policy on standby wells
This well will deepen an existing well

PERMIT NUMBER OF WELL TO BE REPLACED OR DEEPEMED (IF AVAILABLE)

Not to be filled in by driller (MDE OR COUNTY USE ONLY)

APPROP. PERMIT NUMBER PERMIT No. HD - 94 - 3507

SHOW MAJOR FEATURES OF BOX & LOCATE WELL WITH AN X

- SOURCES OF DRILLING WATER
1. Frederick Municipal
2.
3.

WRITE THE BOX NUMBER FROM THE MAP HERE

E 8002 N 5002

10/3/02 3:30



DRAW A SKETCH BELOW SHOWING LOCATION OF WELL IN RELATION TO NEARBY TOWNS AND ROADS AND GIVE DISTANCE FROM WELL TO NEAREST ROAD JUNCTION

SPECIAL CONDITIONS

NOTE - APPROVING AUTHORITIES SHOULD USE SEPARATE SHEET IF NEEDED



WLBO16866  
Lot 11, BRIGHTON PINES

HOWARD COUNTY HEALTH DEPARTMENT  
BUREAU OF ENVIRONMENTAL HEALTH  
WATER AND SEWERAGE PROGRAM  
TEL: (410)313-2640 FAX: (410)313-2648

Information Form for the Installation of the Well Pump, Pitless Adapter, and Supply Piping

NOTE: The installer is responsible for requesting an inspection prior to 9 am on the day of the desired inspection. No work is to be covered until approved by the Health Department. All installations must comply with the National Standard Plumbing Code (NSPC, as amended locally) and COMAR 26.84.04 (MD Well Construction Regulations). Submission of a complete form is required prior to Use and Occupancy approval.

Company Name: CHARLES A. KLEIN & SON, INC Telephone #: (410) 549-6960  
Address: 5220 KLEIN MILL ROAD  
SPRINGVILLE, MD 21784

(Must circle one) Licensed Plumber Licensed Well Driller Licensed Well Pump Installer  
License # and name of individual responsible for the field installation:  
Name (Print): MICHAEL F. KLEIN License # 6522

\*A licensed individual must perform the actual installation. Apprentices must be under the direct supervision of a licensed journeyman or master plumber, pump installer or well driller. Licenses may be subjected to field verification.

Name of Property Owner: WILLIAMSBURG GROUP Telephone #: (410) 997-8800  
Subdivision: BRIGHTON PINES Lot #: 11 Well Tag #: HO-92-3007  
Site Address: 13773 LAKESIDE DRIVE  
CLARKSVILLE MD 21029

Submersible Pump Data Pitless Adapter Well Cap and Electric Conduit  
Make: JACUZZI Make: HARVARD Two piece watertight cap:   
Model #: 3345-13P-52 Model #: PT-800 Screened, vented well cap:   
Pump Capacity: 5 GPM Depth: 42" (36" min) Cap secured to casing:   
Well Yield: 9 GPM NSF approved: Conduit min 18" R.G.:   
Depth of well encountered at time of pump installation: 240 (feet) Conduit secured to well cap:   
If pump capacity exceeds well yield, a low water cut off switch is required by NSPC 1990 Section 17.8.4  
Torque arrestors or Cable glands are required - Must circle one  
Safety rope, if used, attached to inside of well casing with eye bolt

Piping to house House Connection  
Type: POLYETHYLENE PVC sleeved to undisturbed soil at wall penetration: Yes  
PSI: 11 (150 psi min) Approximate length of sleeve: \_\_\_\_\_  
Depth of supply line: \_\_\_\_\_ (36" min) Sleeve caulked and sealed properly:

The water supply line is required to be at least ten feet from the septic tank, pump chamber, sewage piping, distribution box, drainfields, and sewage reserve area. If this cannot be accomplished, contact this office for approval prior to installation.


Signature of company representative responsible for installation: MICHAEL F. KLEIN date: 12/22/04

For Health Department Use Only - Not to be completed by Installer

Date Insp. Requested: \_\_\_\_\_ Date Insp. Approved: 7/10/05-50  
Inspection Data: Pitless adapter and water supply line at least 36" below grade   
Two piece cap installed and attached to casing securely   
Elec. conduit extends at least 18" below grade/attached to cap properly   
Safety rope installed inside of well casing   
Correct well tag attached properly and casing 8" above finished grade   
Water supply line sleeved adequately at house connection   
Adequate grout observed below pitless adapter

Cap installed per  
Suzanne Davis of Williamsburg  
Group

1247/416

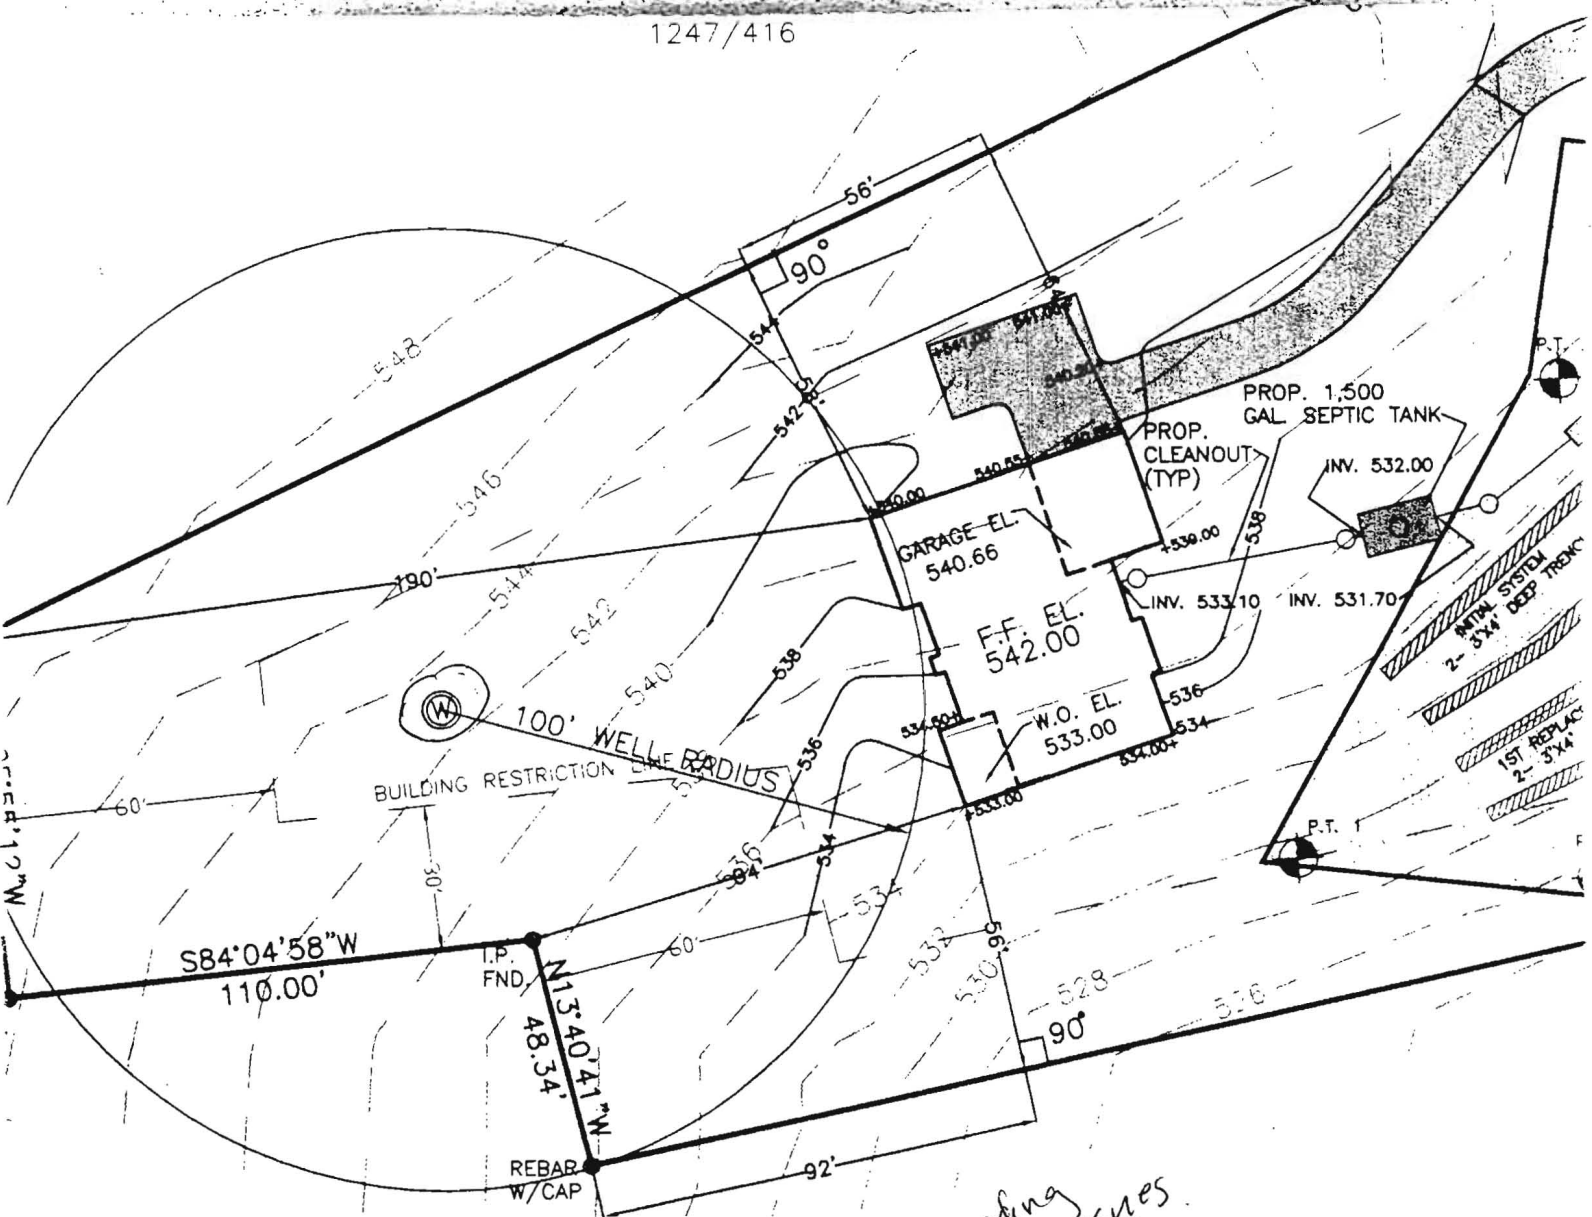

n/f  
W.S.S.C.  
207/415

9/17/02  
Well location  
okay. No site insp.  
(KN)

checked surrounding  
properties and issues

MICHAEL L. & ELIZABETH G. WILLIAMS  
3507/551  
TAX MAP 34, GRID 7, PARCEL 396  
LOT 16 BRIGHTON PINES

**FOUNTAIN VALLEY ANALYTICAL LABORATORY, INC.**

1413 Old Taneytown Rd. Westminster, MD (410) 848-1014 (410) 876-4554 FAX (410) 848-0298

**REPORT OF ANALYSIS**

Laboratory ID #: 55511 Account #: 4470  
Reference: Brighton Pines Lot 11 Company: Williamsburg Group LLC  
Location: 13773 Lakeside Drive Requested By: Chip Lundy/ Bob Corbett  
Clarksville, MD 21029 Source: Well Water  
Date/ Time Collected: 07/12/05 1212 Site: Laundry Tray  
Date/Time Rec'd: 07/12/05 1331 Treatment: None  
Chlorine ppm: Free: ND Total: ND pH: 6.7  
Collected By: J. Yeager 6176JY Well #: HO-94-3507


PARAMETERS	RESULTS	UNITS	REFERENCE	METHOD	DATE/TIME/ANALYST
Bacteria, Coliform, Total, MPN	<1.0	MPN/ 100 ml	<1.0	SM18 9223 B.	07/13/05 / 1000 / B. Dutterer
Bacteria, E. coli, MPN	<1.0	MPN/ 100 ml	<1.0	SM18 9223 B.	07/13/05 / 1000 / B. Dutterer
Nitrate	<1.0	mg/L	10	601	07/12/05 / 1530 / B. Dutterer
Turbidity	0.94	NTU	<10	SM18 2130B	07/12/05 / 1525 / B. Dutterer
Sand	NS	mg/L	5	Visual/Gravimetric	07/12/05 / 1525 / B. Dutterer

**NOTES:**

- 1 mg/L = milligrams per liter (also, parts per million)
- 2 MPN/ 100 ml = Most Probable Number [of viable bacteria] per 100 ml of sample.
- 3 NS = None Seen (NS indicates less than 5 mg/L)
- 4 NTU = Nephelometric Turbidity Units
- 5 Results less than or within the reference range are considered satisfactory and within potable water limits at the time of sampling.
- 6 ND: None Detected
- 7 Visual well check: Sealed, vented cap
- 8 pH tested on-site

Reason for Test : Use & Occupancy  
Building Permit # : 139847

Date Reported: 07/13/05

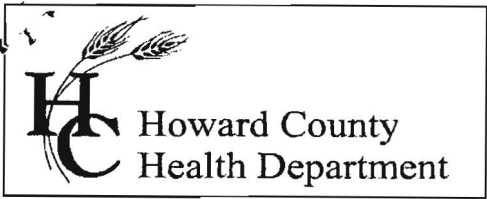

3525 H Ellicott Mills Drive, Ellicott City, MD 21043  
(410) 313-1771 Fax (410) 313-2648  
TDD (410) 313-2323 Toll Free 1-866-313-6300  
website: www.hchealth.org

**Pennv E. Borenstein. M.D.. M.P.H.. Health Officer**

July 18, 2005

Byron Simms  
11705 Lone Tree Court  
Columbia, MD 21044

**SENT VIA FACSIMILE 410-897-0556**

RE: 13773 Lakeside Drive  
Clarksville, MD 21029  
BP #: B00139847  
Well Permit # HO-94-3507

Dear Sirs:

This is to advise you that the septic system for the above referenced property has been installed and inspected. **Final approval of the septic system was granted on 07/18/2005. Final approval of the well line connection to the dwelling was approved on 07/18/2005.**

The water sample results indicate that the water samples submitted for testing were free of coliform and fecal coliform bacteria at the time of sampling and are bacteriologically safe for drinking. The water sample results were found to be in compliance with COMAR water quality standards.

**INTERIM CERTIFICATE OF POTABILITY**

This certifies that the initial sampling requirements of COMAR 26.04.04 "Well Regulations" have been met for the water supply system installed under well permit #HO-94-3507. Although the submitted sample results are in compliance with COMAR standards, the Health Department does not guarantee water supplies. Based upon satisfactory investigation and evaluation, the Howard County Health Department as authorized by the Maryland Department of the Environment accepts this well system as required by COMAR 26.04.04.

This certificate may become final upon completion of the second bacteriological test, which is to be taken by the county health department within six months of receipt of this letter. **Please contact (410) 313-1773 to schedule a final water sample appointment. Currently, there is no charge for this final sampling.**

Date of Water Sample(s): 07/12/2005  
Date of Well Completion: 09/26/2002

Approving Authority  
  
Stuart Oster, R. S.  
Well & Septic Program

cc: Building Inspector's Office  
Community Health Services  
File