

COUNTY #

SOIL PROFILE

606

Red br loam with
pockets of
~50% Rock
Starting at 2'

Med Br
Sa Loam

2 Large
Pockets
of >50%
Rock

One from
6'-9' and
one from
8'-11.5'
~40% Rock
Average

2000

Red Br
Loam

Pockets
of 40-50%
Rock starting
at below 3'

Pockets of
30-70%
Rock
Below 5.5'
~50%
Avg.
Rock

2001

Red Br
Cl Loam

Or Br
Sa Loam

~15-20%
Rock

SOIL PROFILE


2002

Red Br
Heavy Loam

Or Red
Br Loam

Or and
Red Br
Sa Loams
Slight Amount
of Clay
10-15%
Rock

Beige
Sa Loam
15-20%
Rock

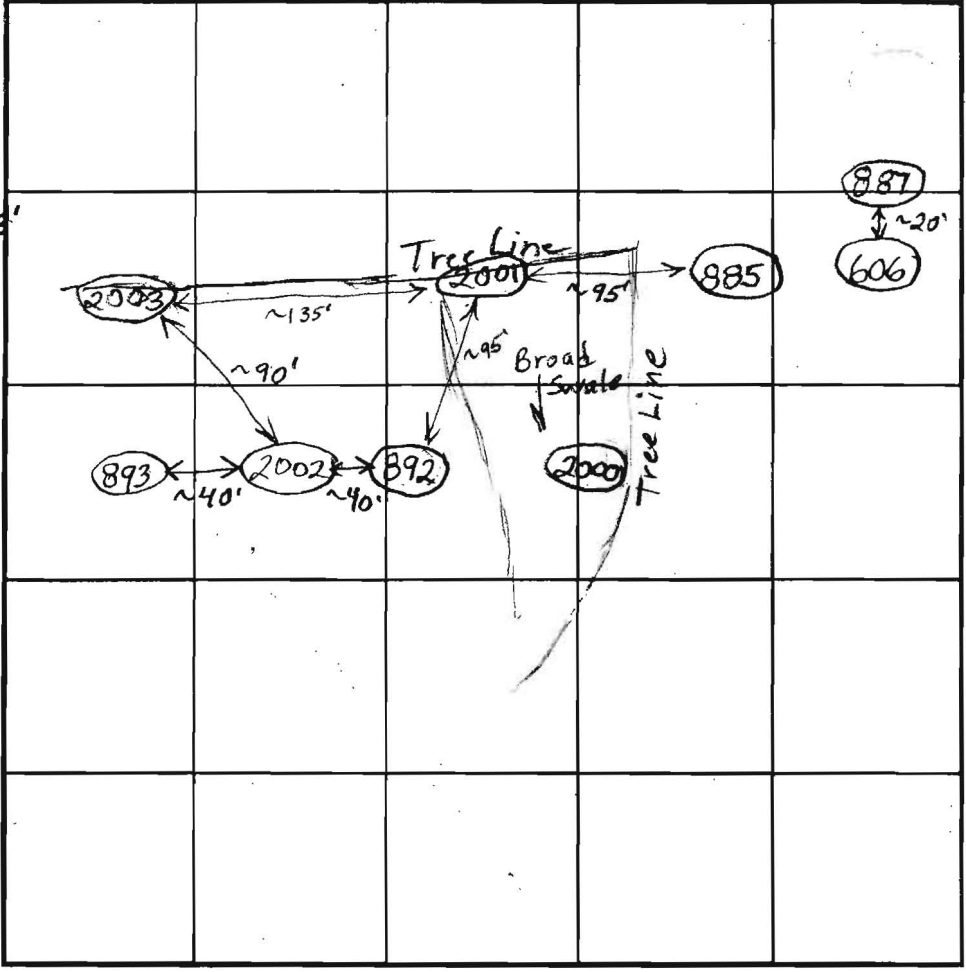

INDICATE NORTH - NAME ADJOINING ROADWAY AS BASE LINE.

DATE	TEST NO.	DEPTH	PRE-WET		TEST - 1" DROP		TIME	
			START	STOP	START	STOP		
4/30/02	606	4' / 12.5' V	12:38	12:41:30	12:41:30	12:48:30	7(F)	
	2000	11.5' V					(F)	
	2001	4' / 13' V	2:18	2:20:30	2:20:30	2:24	3 1/2	OK
	2002	5.5' / 13' V	2:33:30	2:43:30	2:43:30	3:03:15	~20	OK
	2003	12.5' V	- Similar to 2001					OK

REMARKS _____

TYPE OF SOIL _____

TESTED BY _____ ALSO PRESENT _____

TRENCH DESIGN DATA: AVERAGE PERCOLATION TIME _____ TRENCH WIDTH _____

INLET DEPTH _____ MAXIMUM BOTTOM DEPTH _____ SQ FT/BEDROOM _____

13'

