

COUNTY #

SOIL PROFILE

892

0' dark red Sic1Lm

3.0 lgt pink to orange SSL

893

3.5 or brn Sic1Lm 40-50% Rx

lgt orange

1.5 refusal


899 900

bright orange Sic1Lm


3.0 lgt tan yellow SSL

15% Saprolite

14.0

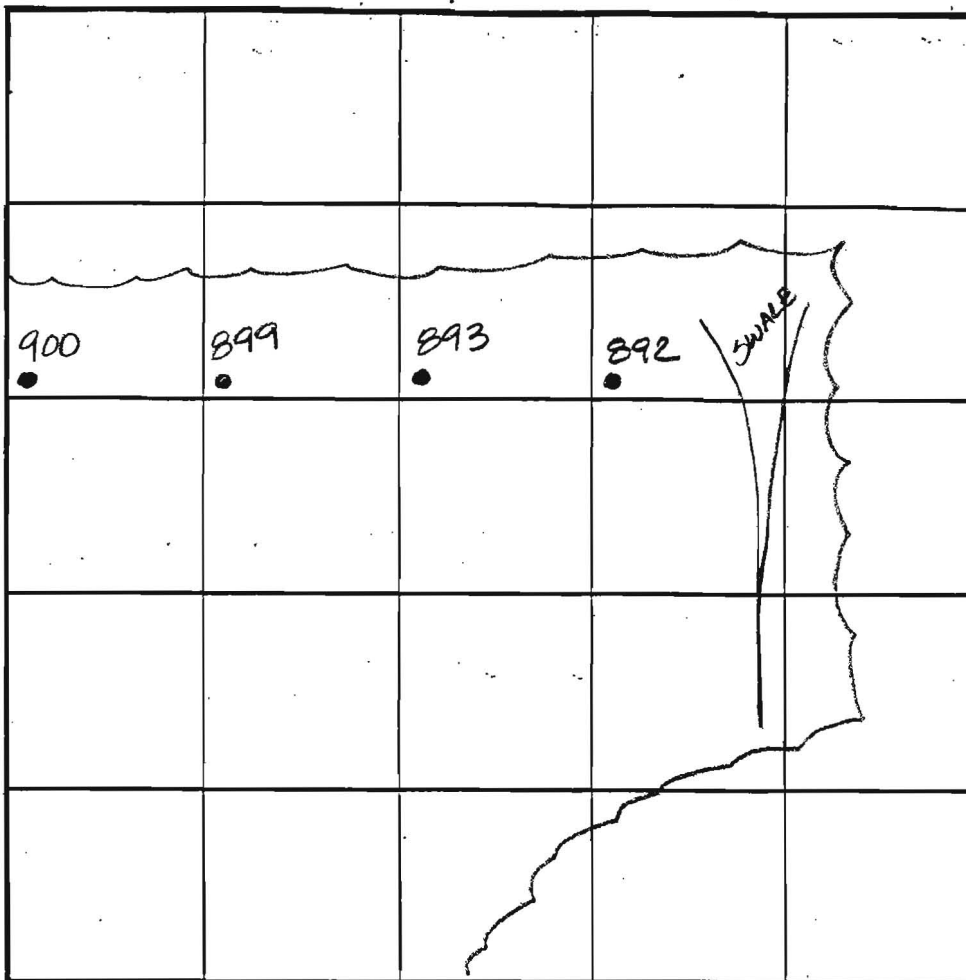

SOIL PROFILE

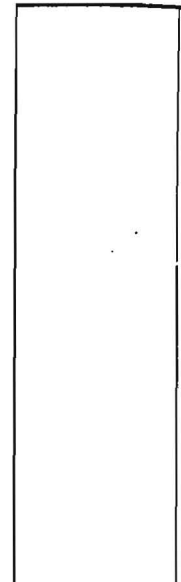

INDICATE NORTH - NAME ADJOINING ROADWAY AS BASE LINE.

DATE	TEST NO.	DEPTH	PRE-WET		TEST - 1" DROP		TIME
			START	STOP	START	STOP	
5-31-01	892	3.0 / V14.0	3:26	3:28	3:28	3:30	2min
	893	6.0 / V11.5	3:34	3:41	3:41	nommt @ 4:10	Fail
	899	Visual to 14.0'	- see profile -				OK
	900	4.5 / V14.0	3:38	3:40	3:40	3:43	3min

deep clay & shallow depth to bedrock 893

REMARKS _____

TYPE OF SOIL _____

TESTED BY Amy McMullen / Dave Kerr ALSO PRESENT _____

TRENCH DESIGN DATA: AVERAGE PERCOLATION TIME _____ TRENCH WIDTH _____

INLET DEPTH _____ MAXIMUM BOTTOM DEPTH _____ SQ. FT./BEDROOM _____