


N 70° 06' 35" E 249.00

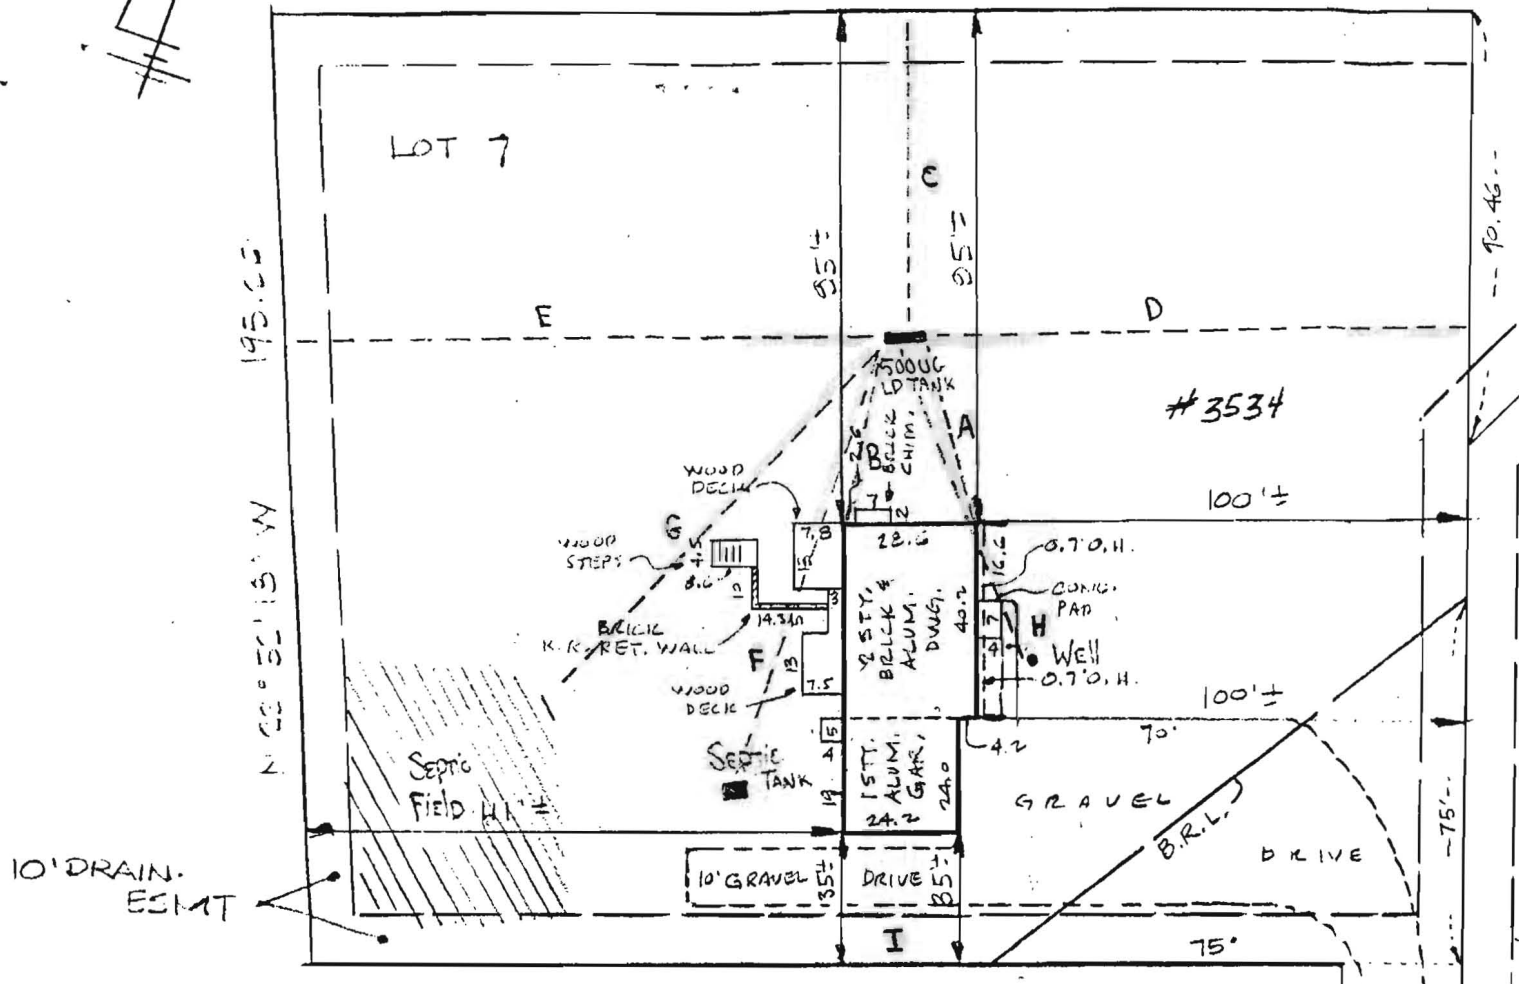

S 70° 15' 55" W 213.53

Scale 1" = 40'

DISTANCE FROM TANK TO:

- (A) FRONT CORNER HOUSE 38'
- (B) REAR CORNER HOUSE 38'
- (C) REAR PROPERTY LINE 55'
- (D) RIGHT PROPERTY LINE 118'
- (E) LEFT PROPERTY LINE 115'
- (F) SEPTIC TANK 93'
- (G) SEPTIC FIELD 98'
- (H) WELL 70'
- (I) FRONT PROP LINE 128'

12/21/04 B00157587

Proposed ~~LP tank~~ LP tank
 location OK

KTB



S 19° 46' 01" E 192.75'

12' GRAVEL DRIVE

KINGSTON

SR=5
 L=2