

4/26/62  
4:00

# PERMIT

Approved 4-27-62  
L.M.

P 04776

A ~~04630~~ 522068-J

SEWAGE DISPOSAL SYSTEM

MARYLAND STATE DEPARTMENT OF HEALTH

HOWARD COUNTY

ELLICOTT CITY

DISTRICT 4

DATE 2/6/62

INDEXED

INDEXED

Howard Pickett IS PERMITTED TO INSTALL  ALTER

ADDRESS \_\_\_\_\_ PHONE \_\_\_\_\_

A SEWAGE DISPOSAL SYSTEM LOCATED 725 MI on Long Corner Rd.  $\frac{1}{4}$  of a mile back. between Haines! Peach Orchard and the new house beside it.

SUBDIVISION \_\_\_\_\_ ROAD \_\_\_\_\_ LOT \_\_\_\_\_

PROPERTY OWNER FAVA, Harry & Dorothy

ADDRESS 2002 Oak Drive Baltimore 7 WI 4-1671

### SPECIFICATIONS

DRAIN FIELD \_\_\_\_\_ DEPTH \_\_\_\_\_ FEET. BOTTOM AREA \_\_\_\_\_ SQ. FT.

SEEPAGE PITS  ABSORBENT SIDE-WALL AREA 456 SQ. FT. to begin below the inlet pipe.

SEPTIC TANK CAPACITY 750 GALLONS

FOR GARBAGE GRINDER, INCREASE DISPOSAL AREA 22% & TANK CAPACITY 50%.

OTHER Inlet pipe to be  $4\frac{1}{2}$  feet below original grade. 2 dry wells can be used- each being 10 feet in diameter and 8 feet deep below the inlet pipe.

Place the dry well about 40 feet from front of lot (Long Corner rd.)


and about 30 feet from right side of lot as you face from Long Corner Rd.

PLANS APPROVED BY D. W. Monaghan DATE 1/15/61

FILL SEPTIC TANK AND DISTRIBUTION BOX WITH WATER BEFORE CALLING FOR AN INSPECTION. COVER NO WORK UNTIL INSPECTED AND APPROVED.

NEITHER THE HOWARD COUNTY COMMISSIONERS NOR THE HEALTH DEPARTMENT IS RESPONSIBLE FOR THE SUCCESSFUL OPERATION OF ANY SYSTEM.

A  
522068-J

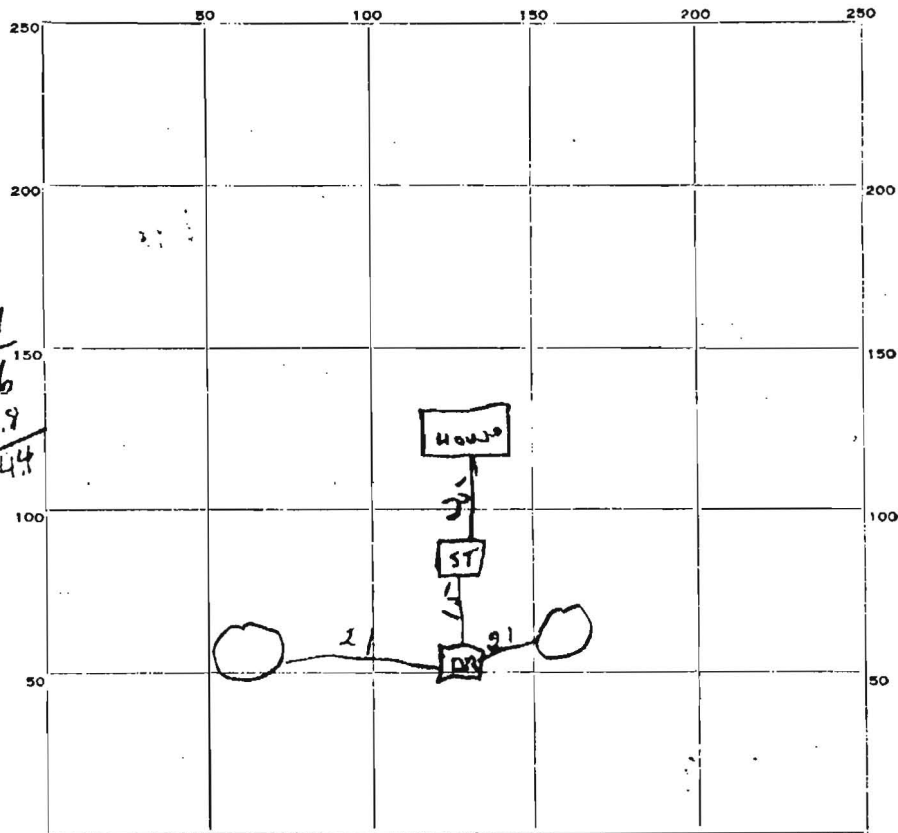

$$\begin{array}{r} 3.14 \\ \times 12 \\ \hline 628 \\ 314 \\ \hline 3778 \\ 314 \\ \hline 2198 \end{array}$$

$$\begin{array}{r} 57.8 \\ \times 7 \\ \hline 264.6 \\ 219.8 \\ \hline 484.4 \end{array}$$

PERMIT CARD OK  
 SEPTIC TANK, LEVEL OK CLEANOUTS OK  
 DISTRIBUTION BOX, LEVEL OK  
 TILE FIELD, DEPTH \_\_\_\_\_ FT. TRENCH WIDTH \_\_\_\_\_ FT.  
 GRAVEL DEPTH \_\_\_\_\_ IN. TOTAL LENGTH \_\_\_\_\_ FT.  
 NUMBER OF TRENCHES \_\_\_\_\_ TOTAL BOTTOM AREA \_\_\_\_\_  
 SEEPAGE PITS, INSIDE DIAMETER 12ft + 10ft FT. DEPTH BELOW INLET 7 FT.  
 ABSORBENT AREA 484.4 SQ. FT.

REMARKS \_\_\_\_\_

\_\_\_\_\_

\_\_\_\_\_

\_\_\_\_\_

\_\_\_\_\_

DATE SYSTEM APPROVED 4-27-62 INSPECTOR W. M. ...