

# APPLICATION

PERCOLATION TESTING

A 36991

P \_\_\_\_\_

HOWARD COUNTY HEALTH DEPARTMENT  
BUREAU OF ENVIRONMENTAL HEALTH  
P.O. BOX 476 ELLICOTT CITY, MARYLAND 21043  
TELEPHONE: 461-9933

DISTRICT 5

DATE 5/15/86

TO: THE COUNTY HEALTH OFFICER  
ELLICOTT CITY, MARYLAND

I, HEREBY, APPLY FOR THE NECESSARY TEST IN ORDER TO CONSTRUCT (OR RECONSTRUCT) A SEWAGE DISPOSAL SYSTEM.

PROPERTY OWNER Wayback Corporation

ADDRESS P.O. Box 1018, Columbia, MD, 21044 PHONE 997-8800

PROSPECTIVE BUYER NONE

ADDRESS \_\_\_\_\_ PHONE \_\_\_\_\_

PROPERTY LOCATION:  
SUBDIVISION The Chase - formerly The Paddock LOT NO. 15

*Common Buy.  
New Prelim.  
#15*

ROAD AND DESCRIPTION Homewood Road

TAX MAP 29 PARCEL # 24

SIZE OF LOT 3 acres TYPE BLDG. S.F.D.  
(SINGLE FAMILY DWELLING OR COMMERCIAL)

THE SYSTEM INSTALLED UNDER THIS APPLICATION IS ACCEPTABLE ONLY UNTIL PUBLIC FACILITIES BECOME AVAILABLE. I FULLY UNDERSTAND THE FEE CONNECTED WITH THE FILING OF THIS PERC TEST APPLICATION IS NON-REFUNDABLE UNDER ANY CIRCUMSTANCES. I ALSO AGREE TO COMPLY WITH ALL M.O.S.H.A. REQUIREMENTS IN TESTING THIS LOT.

*[Signature]*  
SIGNATURE OF APPLICANT

APPROVED BY Simey Abel FOR Shallow tile fields DATE 1-6-87

REJECTED BY \_\_\_\_\_ FOR \_\_\_\_\_ DATE \_\_\_\_\_


HOLD PENDING FURTHER TESTS \_\_\_\_\_ DATE \_\_\_\_\_

REASONS FOR REJECTION OR HOLDING 6/26/86 Perc Satisfactory; Hold for Subdivision plat; Shallow Syst. only. S. Abel 6/27/86 wet season com. (loc. visual) - S. Abel  
3/3/87 Perc Satisfactory - Hold for re-subdivision plat. S. Abel

# THIS IS NOT A PERMIT

① ②  
 All Holes ③ ④  
 SOIL PROFILE

4" A-1-S  
 Brown  
 Gravelly  
 SAND LOAM  
 10-15%  
 Fragments  
 3.5" Brown  
 SAND LOAM  
 <10%  
 Fragments

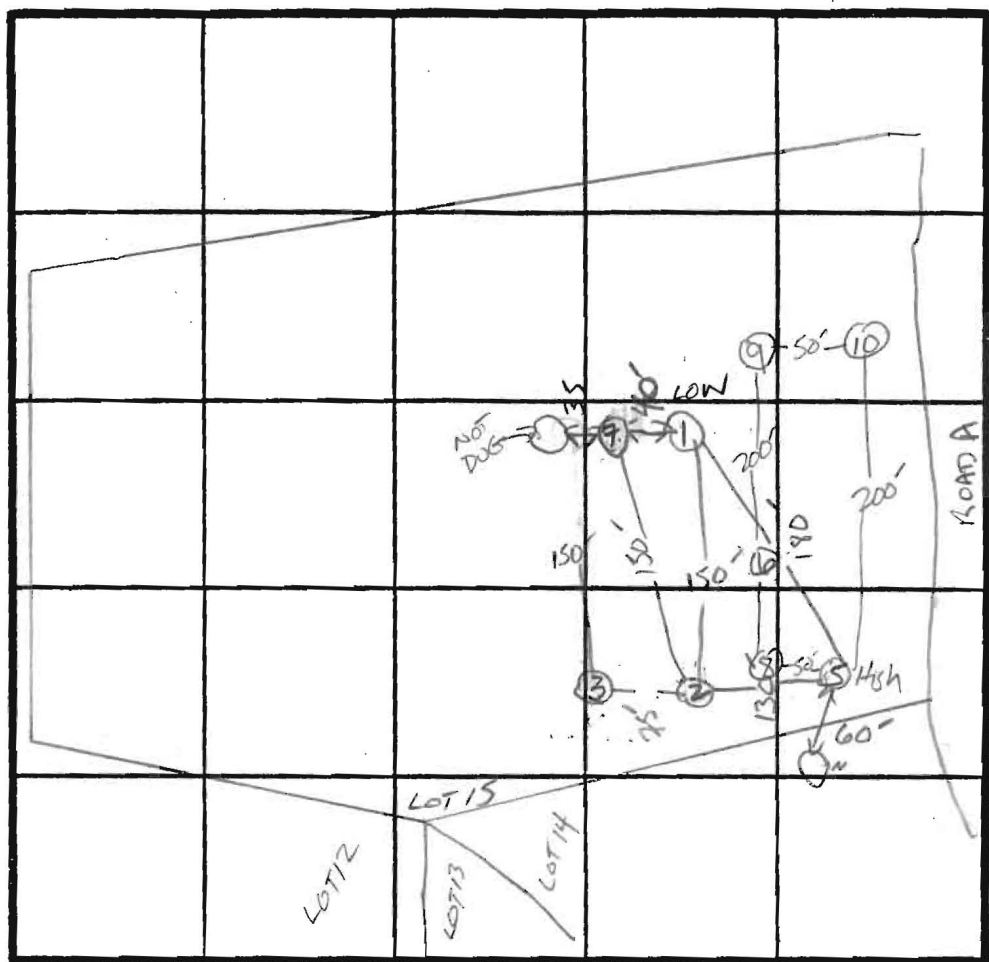

X PERC  
 6 MIN  
 INLET  
 3.5"  
 BOTTOM  
 5.0"  
 180 φ / BR

INDICATE NORTH - NAME ADJOINING ROADWAY AS BASE LINE.

Homewood Rd.

DATE	TEST NO.	DEPTH	PRE-WET		TEST - 1" DROP		TIME
			START	STOP	START	STOP	
6/24/86	5 S ✓	4" 13"	11:32 uniform	11:34 below 3.5"	11:34	11:39	5 min ✓
	6 V ✓	12.5"	Uniform	soil below 3"			
	2 S	3.5" 9"	11:41 11:42	11:42 11:43	11:42	11:43 11:45	1 min 2 min
	2 V	12.5"	same as hole #5				
	3 V	WATER AT 8 FT					
	1 S	3.5"	11:53	NO MOVEMENT			
	1 V	13"	ALONG W/ HOLE #5 CLAY				DEEPER TO 5"
	7 V	SOLID ROCK AT 10'		ABANDONED			
	5 S	5"	12:01	12:03	12:03	12:06	3 min ✓
7/4/86	8 S ✓	3" 13"	11:59 uniform	12:02 soil below	12:02	12:12	10 min ✓
	9 S ✓	3.5" 12"	11:45 uniform	11:46 soil below	11:46	11:49	3 min ✓

REMARKS HOLES DIFF THAN PLAT; Shallow Syst. only

TYPE OF SOIL MANOR Gravelly LOAM  
 S. Abel

JEFF + MATT, BOB, WADE

EH-12-1079

# APPLICATION

PERCOLATION TESTING

HOWARD COUNTY HEALTH DEPARTMENT  
BUREAU OF ENVIRONMENTAL HEALTH  
P.O. BOX 476 ELLICOTT CITY, MARYLAND 21043  
TELEPHONE: 461-9933

A 36991

P \_\_\_\_\_

DISTRICT 5

DATE 5/15/86

TO: THE COUNTY HEALTH OFFICER  
ELLICOTT CITY, MARYLAND

I, HEREBY, APPLY FOR THE NECESSARY TEST IN ORDER TO CONSTRUCT (OR RECONSTRUCT) A SEWAGE DISPOSAL SYSTEM.

PROPERTY OWNER Wayback Corporation

ADDRESS P.O. Box 1018, Columbia, MD. 21044 PHONE 997-8800

PROSPECTIVE BUYER NONE

ADDRESS \_\_\_\_\_ PHONE \_\_\_\_\_

PROPERTY LOCATION:


SUBDIVISION The Chase - formerly The Paddock LOT NO. 14

ROAD AND DESCRIPTION Homewood Road

TAX MAP 29 PARCEL # 24

SIZE OF LOT 3 acres TYPE BLDG. S.F.D.  
(SINGLE FAMILY DWELLING OR COMMERCIAL)

THE SYSTEM INSTALLED UNDER THIS APPLICATION IS ACCEPTABLE ONLY UNTIL PUBLIC FACILITIES BECOME AVAILABLE. I FULLY UNDERSTAND THE FEE CONNECTED WITH THE FILING OF THIS PERC TEST APPLICATION IS NON-REFUNDABLE UNDER ANY CIRCUMSTANCES. I ALSO AGREE TO COMPLY WITH ALL M.O.S.H.A. REQUIREMENTS IN TESTING THIS LOT.

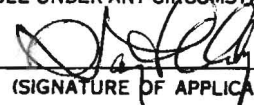  
(SIGNATURE OF APPLICANT)

APPROVED BY \_\_\_\_\_ FOR \_\_\_\_\_ DATE \_\_\_\_\_

REJECTED BY \_\_\_\_\_ FOR \_\_\_\_\_ DATE \_\_\_\_\_

HOLD PENDING FURTHER TESTS \_\_\_\_\_ DATE \_\_\_\_\_

REASONS FOR REJECTION OR HOLDING \_\_\_\_\_

# THIS IS NOT A PERMIT



MATCH LINE SEE SH

VIKENS PATH

WATERS

RUN

13

12

14

124,402  $\phi$  or  
2.8559 Ac.

15

125,012  $\phi$  or  
2.8699 Acres

16

119,801  $\phi$  or  
2.7503 Acres

17

127,94  
or  
2.937

3

2  $\phi$  or  
Acres

N83°43'13"E  
30' B.R.L.

(79) N68°07'53"E  
30' B.R.L. 119.08'

(78)

(NR)

300.00'

60' B.R.L.

533004.44"E  
31798.9'  
306.46'

356.46'

30' B.R.L.

75' B.R.L.

30' B.R.L.  
N86°00'00"E

30' B.R.L.  
N06°00'00"W  
28.00'

558.07'

50.00'  
60' B.R.L.

(31)

(30)

R=50.00'  
A=75.58'

1500.00'  
N58°00'00"W  
161.21'

235.61'  
R=1355.00'  
A=475.67'

265.77'  
A=898.34'

A=875.00'  
A=193.12'

30' B.R.L.  
N79°00'00"E

30' B.R.L.

534.23'

449.83'

75' B.R.L.

30' B.R.L.

30' B.R.L.

531.84'

20' Drainage &  
Utility Easement

N71°00'00"E  
210.04'

75' B.R.L.

A=2206.21'

202.23'

S84°09'07"W  
30' B.R.L.

30' B.R.L.

510.7'  
50.00'  
N00°35'00"  
500°35'00"  
84.57'

(38)

(45)

75' B.R.L.

30' B.R.L.

