

LAYOUT \_\_\_\_\_

INSP 1 \_\_\_\_\_ INSP 3 \_\_\_\_\_

INSP 2 \_\_\_\_\_ INSP 5 \_\_\_\_\_

ISSUE DATE: 7/15/05

APPROVAL DATE: 8/30/06

# PERMIT SHARED SEPTIC SYSTEM

INDEXED  
04-369297

P 522940-T

A 524193

## HOUSE SEWER LINE CONNECTION

### HOWARD COUNTY HEALTH DEPARTMENT BUREAU OF ENVIRONMENTAL HEALTH

Fogles Septic Clean, Inc IS PERMITTED TO INSTALL  ALTER

ADDRESS: 580 Obrecht Rd., Sykesville 21784 PHONE NUMBER: 410-795-5670

SUBDIVISION Triadelphia Crossing LOT NUMBER: 22

ADDRESS: 14210 Meadow Lake Drive TollMD LP

NUMBER OF BEDROOMS: 4

HOUSE SERVED BY PUBLIC WATER? **NO**

LOCATION:	Install 4" house sewer line connection per the approved site plan.
NOTES:	This permit is limited to the installation of the individual house sewer line connection and installation of the grinder pump, if applicable. The Howard County Bureau of Utilities must be contacted for scheduling of inspection of these items, as well at 410-313-4900.

PLANS APPROVED: Michael Davis DATE: 4/18/06


### PERMIT VOID AFTER 2 YEARS

1. CONTRACTOR IS RESPONSIBLE FOR SCHEDULING A PRE-CONSTRUCTION INSPECTION FOR ALL INSTALLATIONS.
2. ALL PARTS OF SEPTIC SYSTEM SHALL BE 100 FEET FROM ANY WATER WELL UNLESS SPECIFICALLY AUTHORIZED.
3. MANHOLE RISERS REQUIRED ON ALL SEPTIC TANKS AND PUMP CHAMBERS UNLESS SPECIFICALLY AUTHORIZED.
4. CONTRACTOR RESPONSIBLE FOR COMPLIANCE WITH APPLICABLE REGULATIONS, GUIDELINES AND THE TERMS OF THIS PERMIT.
5. NEITHER THE HOWARD COUNTY COUNCIL OR THE HEALTH DEPARTMENT IS RESPONSIBLE FOR THE SUCCESSFUL OPERATION OF ANY SYSTEM.
6. PERMITTEE RESPONSIBLE FOR OBTAINING FINAL APPROVAL ON THIS PERMIT.

**CALL 410-313-1771 FOR INSPECTION HOUSE CONNECTION**

P522940-T

NOT TO SCALE

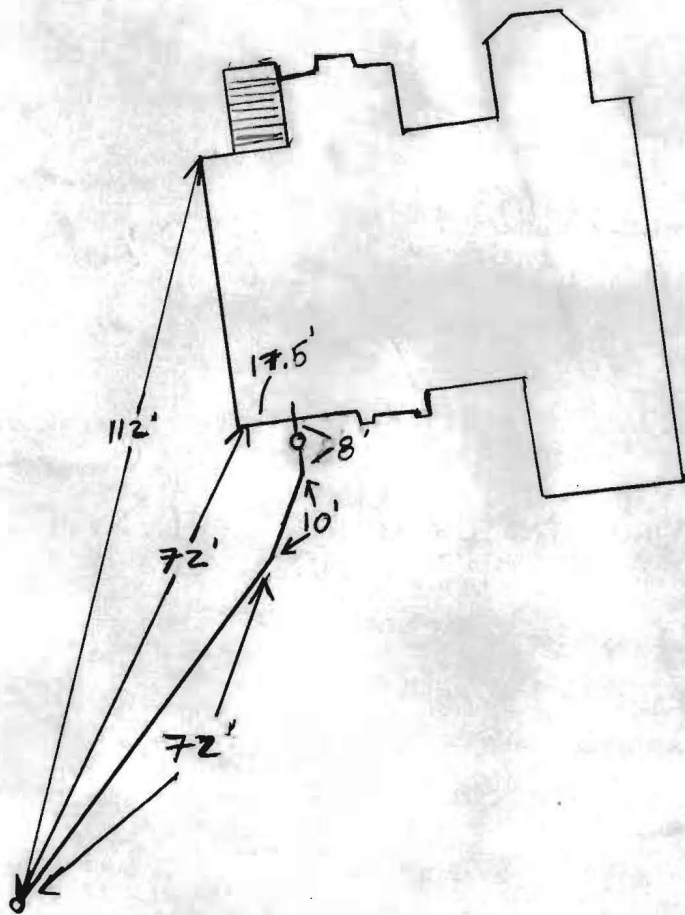

ROAD

**TRENCH/DRAINFIELD DATA**

WIDTH	INLET	BOTTOM
_____	_____	_____
NUMBER OF TRENCHES _____		
TOTAL LENGTH _____		
ABSORPTION AREA _____		
DISTRIBUTION BOX LEVEL _____		
DISTRIBUTION BOX BAFFLE _____		
DISTRIBUTION BOX PORT _____		

**SEPTIC TANK DATA**

SEPTIC TANK 1 LEVEL \_\_\_\_\_

CAPACITY \_\_\_\_\_ GAL

SEAM LOC \_\_\_\_\_

TANK LID DEPTH \_\_\_\_\_

BAFFLES \_\_\_\_\_

BAFFLE FILTER \_\_\_\_\_

MANHOLE LOC \_\_\_\_\_

6" PORT LOC \_\_\_\_\_

WATERTIGHT TEST \_\_\_\_\_

SEPTIC TANK 2 LEVEL \_\_\_\_\_

CAPACITY \_\_\_\_\_ GAL

SEAM LOC \_\_\_\_\_

TANK LID DEPTH \_\_\_\_\_

BAFFLES \_\_\_\_\_

BAFFLE FILTER \_\_\_\_\_

MANHOLE LOC \_\_\_\_\_

6" PORT LOC \_\_\_\_\_

WATERTIGHT TEST \_\_\_\_\_

PRE-CONSTRUCTION 4" House Sewer Line Connection

INSTALLATION 8/30/06 System installed per plan. looks O.K. O.K. to Backfill. (KW)

FINAL INSPECTOR [Signature] DATE OF APPROVAL 8/30/06

DATE

Circuit Court for  
HOWARD COUNTY  
Clerk of the Court,  
MARGARET D. RAPPAPORT  
8360 COURT AVENUE  
ELLCOTT CITY, MD 21043-  
(410) 313-2111

Transaction Block:	3392
Ref: 110	
MISC	AMOUNT
IMP FD SURE \$5	20.00
RECORDING FEE \$20.00	20.00
SUBTOTAL:	40.00
TOTAL CHARGES:	40.00
PAYMENTS	
CASH	40.00
TOTAL TENDERED:	40.00

Cashier: TLR Reg # H002  
Rcpt # 22830  
Date: Oct 27, 2006 Time: 02:10 pm



Bureau of Environmental Health  
7178 Columbia Gateway Drive, Columbia MD 21046  
(410) 313-2640 Fax (410) 313-2648  
TDD (410) 313-2323 Toll Free 1-866-313-6300  
website: www.hchealth.org

---

Penny E. Borenstein, M.D., M.P.H., Health Officer

October 6, 2006

Mr. Brett Roberts  
Assistant Project Manager  
Toll Brothers  
7164 Columbia Gateway Drive, Suite 230  
Columbia, MD 21046


RE: **Revised Variance Approval**  
Lot 22, Tridelphia Crossing

Dear Mr. Roberts,

The Department of Health has received your variance request dated October 2, 2006 for the above referenced property. This agency will grant **approval** of the variance provided that a document is recorded with land records noting that a variance to the one hundred foot setback from the well to the grinder pump has been granted by the Department of Health. At the point in time when a new well needs to be installed, it shall be located a minimum of one hundred feet from the grinder pump.

Any questions regarding this decision may be directed to the Well and Septic Program of the Howard County Health Department.

Respectfully,

  
Michael J. Davis, R.S.  
Director, Well and Septic Programs

cc: File