


2/21

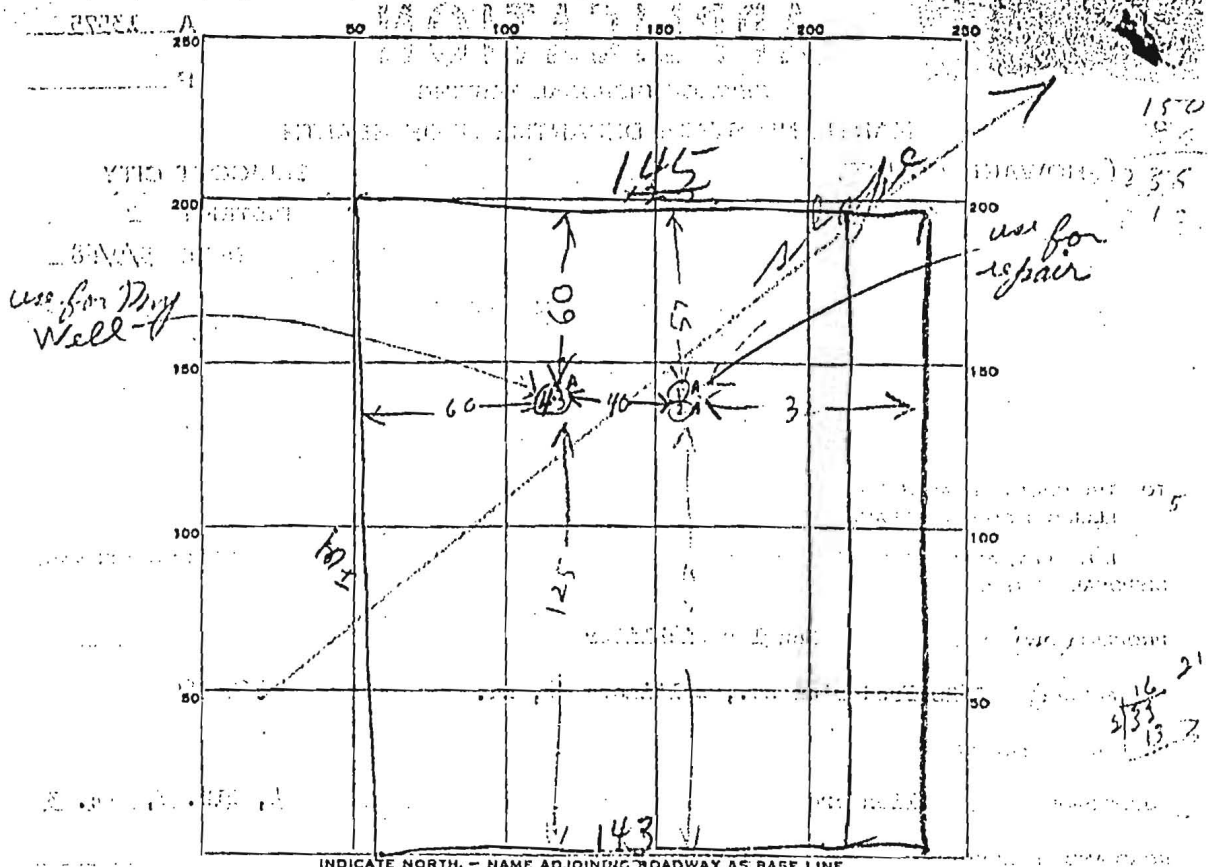


INDICATE NORTH. - NAME ADJOINING ROADWAY AS BASE LINE.

Magwood Dr.

10' of clay
 Sample place
 as (1) (2)
 Sample place
 as (3)
 (3)'

DATE	TEST NO.	DEPTH	PRE-WET		TEST - 1" DROP		TIME
			START	STOP	START	STOP	
2/4/68	1	9 1/2	313	314	314	317	3
" "	2	5 1/2	314	328	328	343	17
" "	3	5 1/2	316	328	not fast enough		
4/5/68	1-A	11'	1134	1136	1136	1141	4
" "	2-A	6 1/2	1135	1152	1153	1221	29
" "	4-A	8 1/2	1145	1142	1147	1148	1
" "	3-A	5 1/2	1147	1152	1152	1201	9

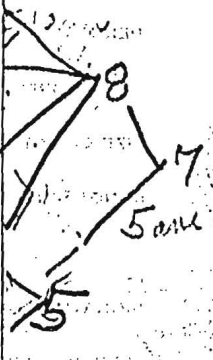


8
 4 3.3

SOIL AUGER FINDING

TESTED BY *B.H. & J.W.*

REMARKS *One hole only, 7 1/2' deep & must be dug to 9 ft located down as (3) 4' sec*

LOT 4, BLK E, SFC 3
26, 015-8

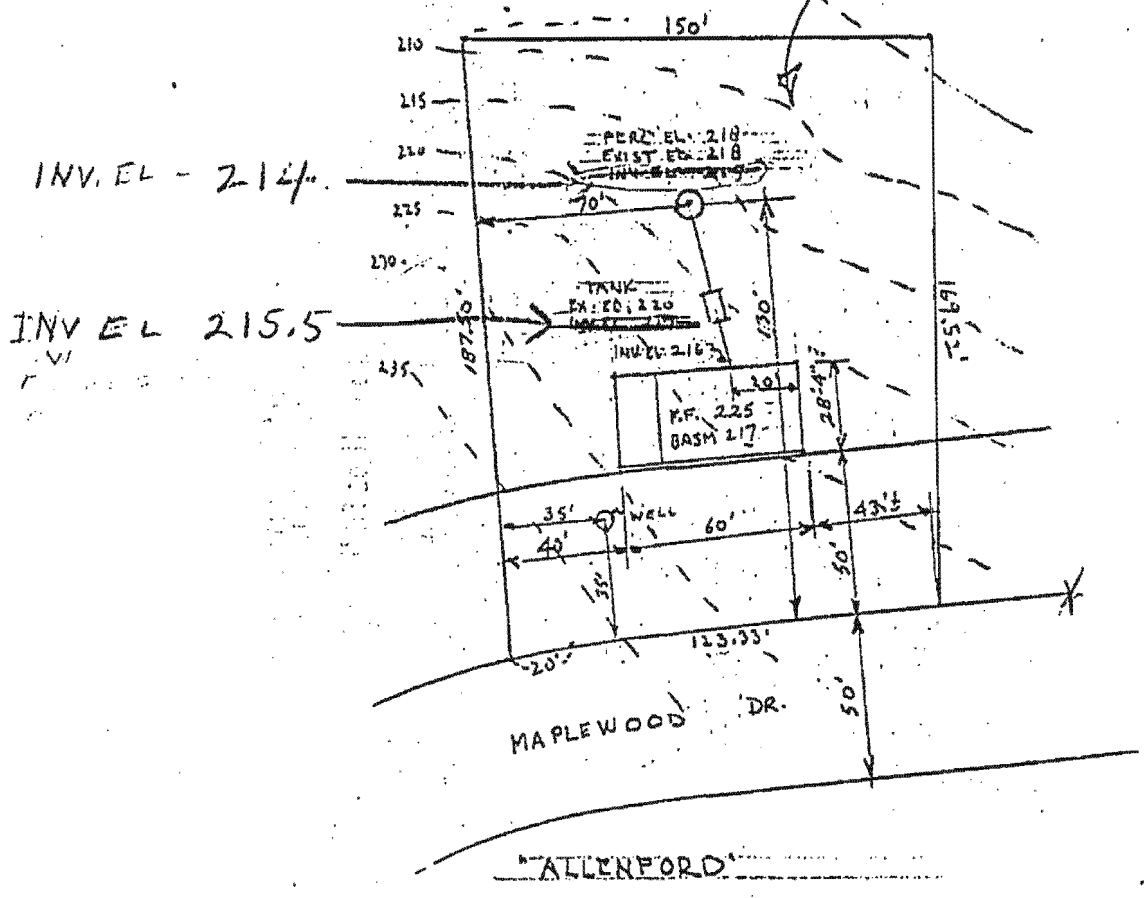

SCALE 1" = 50'

3-28-69

4/3/69 - Talked to Norwood Burgess, H 050238,
who prepared plat and made above correction. B.H.
H 050239

COUGHLIN RES.