


GARAGE ADDITION & CARPORT ENCLOSURE

10080 MAPLEWOOD DRIVE - T.B. COUGHLIN

3-7-75

APPROVED
WALK-THRU BUILDING PERMIT
BP# BOOK 54 269A# 13575
APP. SAN 1/11/66 DATE: 6/7/05
DESC. OF WORK: 22' 8" x 14' 6"
Addition to rear of house

1" = 40'

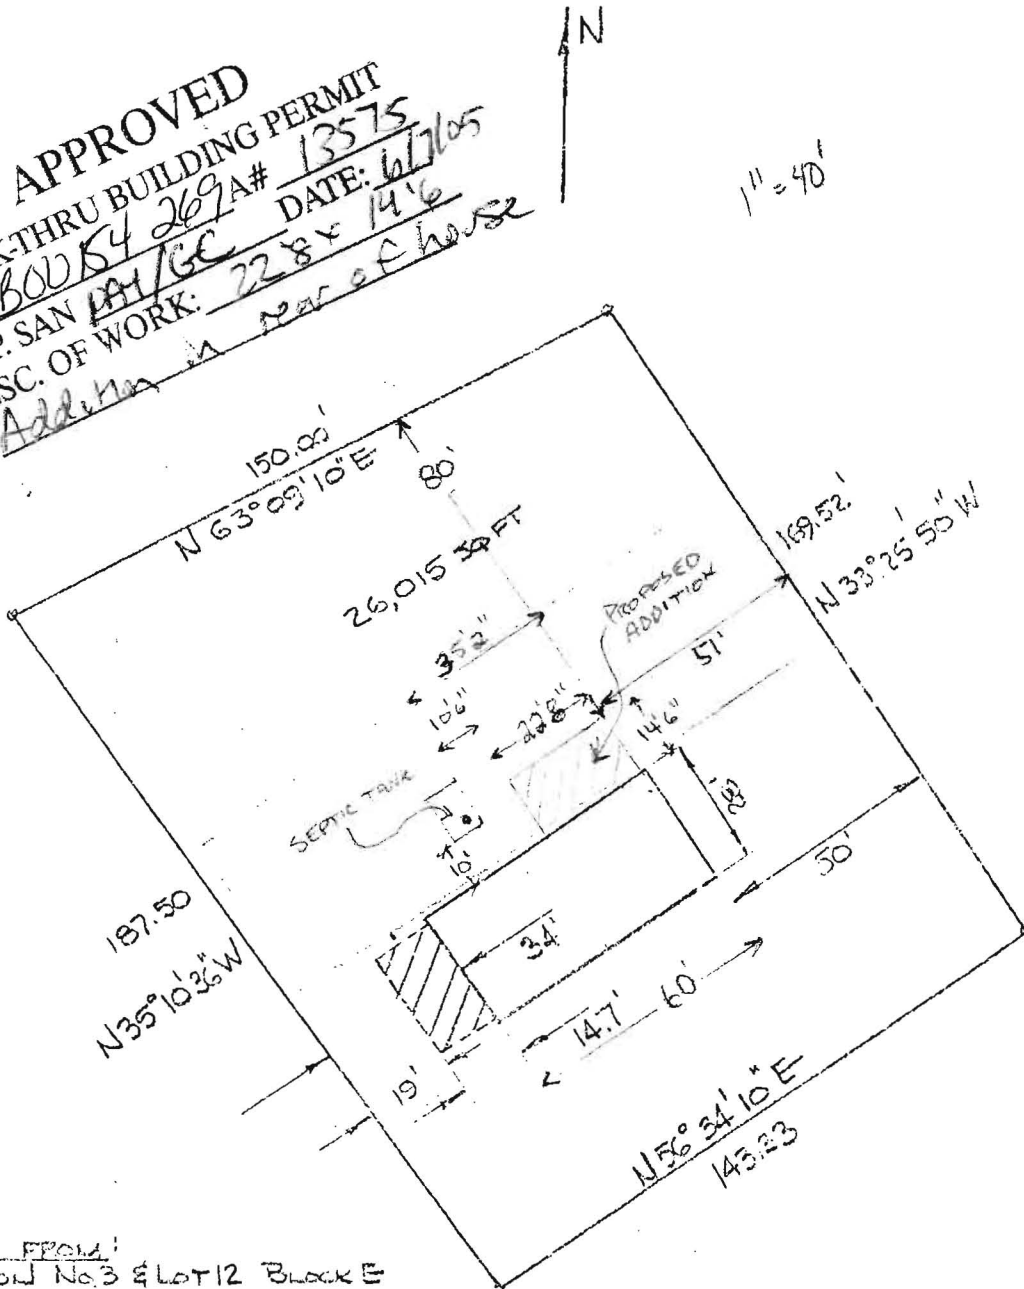

COPIED FROM:
SECTION No. 3 & LOT 12 BLOCK E
- SECTION 12 - ALLENFORD

RECORDED PLAT BOOK 15
FOLIO 57


T.B. COUGHLIN
10080 MAPLEWOOD DR.
ELICOTT CITY, MD.

SITE INSPECTION SHEET

OWNER: Tom Coughlin PHONE #: _____
ADDRESS: 10080 Maplewood Dr CONTRACTOR: Ted Maerton
Elliptott City MD WELL TAG #: N/A Public Water
SUBDIVISION: Allenford LOT: 4 COUNTY #: Howard
PROPOSAL: Addition

TAX ID # 02-202514

LOCATION DIAGRAM

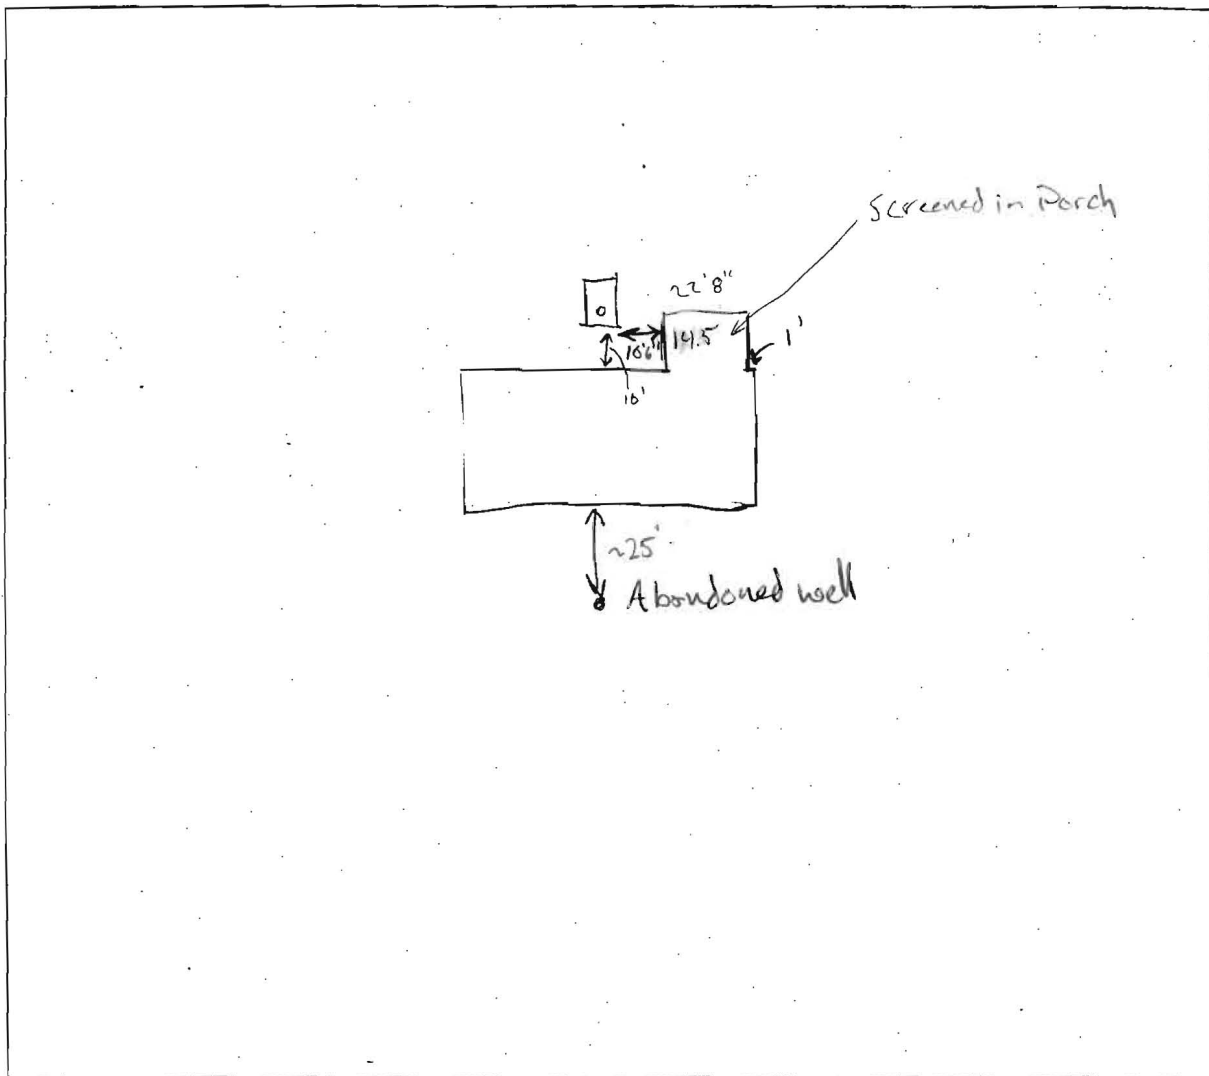

COMMENTS: Tank appears to be working good.
Contractor dug down and exposed corner of septic tank closest to screened porch and measured 10.5' to tank corner. Tank is exactly 10' off house. Told contractor to bring scale drawing of addition. Addition will occupy exact space of screened in porch shown on
DATE: 6/6/05 INSPECTOR: GAC