

LAYOUT _____

INSP 1 _____ INSP 3 _____

INSP 2 _____ INSP 4 _____

ISSUE DATE: 9/8/2005

P 523288-C

APPROVAL DATE: 8/4/05

PERMIT INDEXED

A _____

COMMUNITY SEPTIC SYSTEM HOUSE SEWER LINE CONNECTION

HOWARD COUNTY HEALTH DEPARTMENT
BUREAU OF ENVIRONMENTAL HEALTH

NVR, Inc IS PERMITTED TO INSTALL ALTER

ADDRESS: 6085 Marshalee Drive, Elkridge PHONE NUMBER: 410-379-5956

SUBDIVISION Homeland Unit # 60

ADDRESS: 12005 Grayton Run PROPERTY OWNER: NVR Inc. t/a Ryan Homes

NUMBER OF BEDROOMS: 2

HOUSE SERVED BY PUBLIC WATER

LOCATION:	Install 4" house sewer line connection per the approved site plan. Final acceptance of the sewer system will be subject to the approval of the Maryland Dept. of the Environment.
NOTES:	This permit is limited to the installation of the individual house sewer line connection.

PLANS APPROVED: Kevin J. Bell DATE: 5/25/05


PERMIT VOID AFTER 2 YEARS

1. CONTRACTOR IS RESPONSIBLE FOR SCHEDULING A PRE-CONSTRUCTION INSPECTION FOR ALL INSTALLATIONS.
2. ALL PARTS OF SEPTIC SYSTEM SHALL BE 100 FEET FROM ANY WATER WELL UNLESS SPECIFICALLY AUTHORIZED.
3. CONTRACTOR RESPONSIBLE FOR COMPLIANCE WITH APPLICABLE REGULATIONS, GUIDELINES AND THE TERMS OF THIS PERMIT.
4. NEITHER THE HOWARD COUNTY COUNCIL OR THE HEALTH DEPARTMENT IS RESPONSIBLE FOR THE SUCCESSFUL OPERATION OF ANY SYSTEM.
5. PERMITTEE RESPONSIBLE FOR OBTAINING FINAL APPROVAL ON THIS PERMIT.

CALL 410-313-1771 FOR INSPECTION OF SEPTIC CONNECTION

P 523288-C

NOT TO SCALE

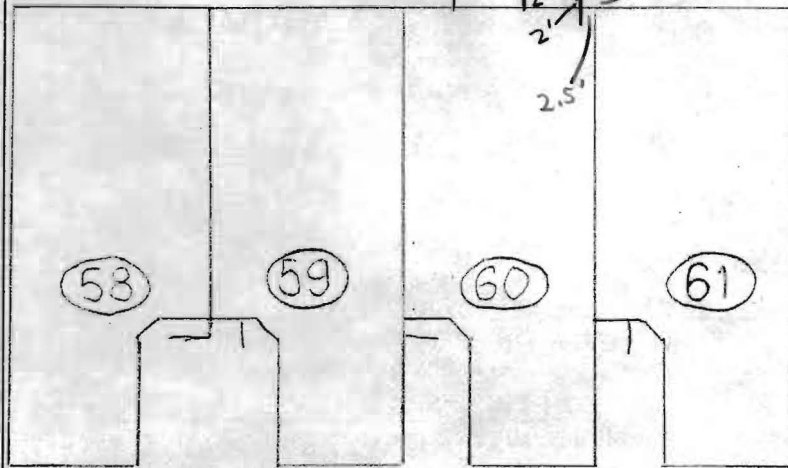

~~TRENCH/DRAINFIELD DATA~~

WIDTH	INLET	BOTTOM
_____	_____	_____
NUMBER OF TRENCHES _____		
TOTAL LENGTH _____		
ABSORPTION AREA _____		
DISTRIBUTION BOX LEVEL _____		
DISTRIBUTION BOX BAFFLE _____		
DISTRIBUTION BOX PORT _____		

~~SEPTIC TANK DATA~~

SEPTIC TANK 1 LEVEL _____

CAPACITY _____ GAL

SEAM LOC _____

TANK LID DEPTH _____

BAFFLES _____

BAFFLE FILTER _____

MANHOLE LOC _____

6" PORT LOC _____

WATERTIGHT TEST _____

SEPTIC TANK 2 LEVEL _____

CAPACITY _____ GAL

SEAM LOC _____

TANK LID DEPTH _____

BAFFLES _____

BAFFLE FILTER _____

MANHOLE LOC _____

6" PORT LOC _____


WATERTIGHT TEST _____

PRE-CONSTRUCTION House connection to shared septic system

public water connections in front of units

INSTALLATION 8/4/05 House connection visually OK. OK to cover

connection sweep y in from above trap

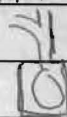

Hold V&O for payment GAC

FINAL INSPECTOR Richard A. Crayton DATE OF APPROVAL 8/4/05



HOWARD COUNTY HEALTH DEPARTMENT

15 23288

DATE
9 / 8 / 2005

Received From NVR

PHONE # 410-379-5956

6085 Marshalee Lane, Ste 130, Ellicott City MD 21075

For Septic Permits

- CASH
 CHECK


Homeland - Lots 58 thru 61 on Grayson Run

NO.
259331

One thousand ^{and} five ~~hundred~~ hundred eighty-four ⁰⁰/₁₀₀ Dollars

\$ 1584 ⁰⁰/₁₀₀

Received By Mary L Briggs

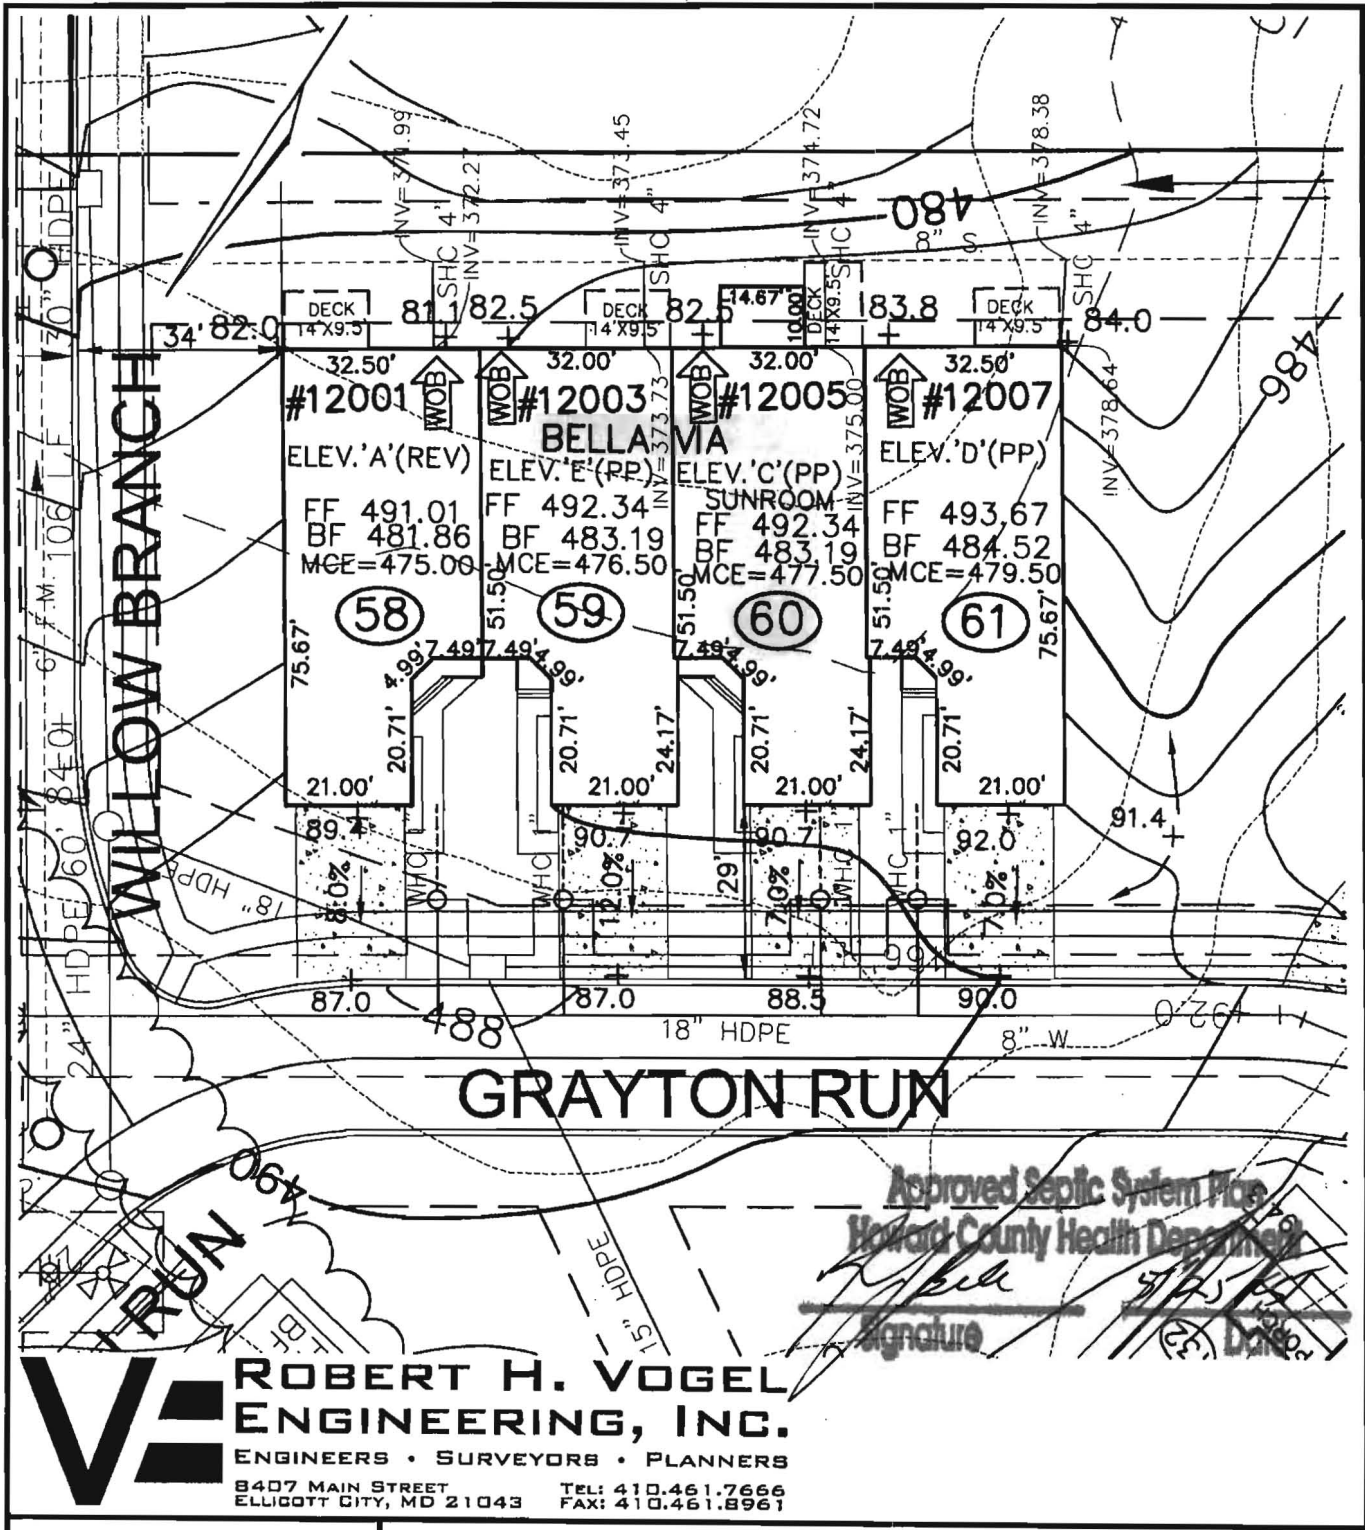

**ROBERT H. VOGEL
ENGINEERING, INC.**

ENGINEERS • SURVEYORS • PLANNERS
8407 MAIN STREET TEL: 410.461.7666
ELLCOTT CITY, MD 21043 FAX: 410.461.8961

SCALE 1"=30'
DRAWN BY JCO
CHECKED BY RHV
DATE MAY, 2005
W. O. # 04-87.00
SHEET# 1 OF 1

**NV HOMES
ELLCOTT MEADOWS
UNITS 58-61**

HOMELAND SDP-03-30
TAX MAP 16
3RD ELECTION DISTRICT

PARCEL 53,96,165&204
HOWARD COUNTY, MARYLAND

B 00153800