

LAYOUT \_\_\_\_\_  
INSP 1 6/23/05 INSP 3 \_\_\_\_\_  
INSP 2 \_\_\_\_\_ INSP 4 \_\_\_\_\_

ISSUE DATE: 9/8/2005

APPROVAL DATE: 6/23/05

**PERMIT**  
**INDEXED**

P 523289

A \_\_\_\_\_

**COMMUNITY SEPTIC SYSTEM  
HOUSE SEWER LINE CONNECTION**

**HOWARD COUNTY HEALTH DEPARTMENT  
BUREAU OF ENVIRONMENTAL HEALTH**

NVR IS PERMITTED TO INSTALL  ALTER

ADDRESS: 6085 Marshalee Drive, Ste 130, Elkridge PHONE NUMBER: 410-379-5956

SUBDIVISION Homeland Unit # 65

ADDRESS: 12021 Grayton Run PROPERTY OWNER: NVR Inc. t/a Ryan Homes

NUMBER OF BEDROOMS: 2

**HOUSE SERVED BY PUBLIC WATER**

LOCATION:	Install 4" house sewer line connection per the approved site plan. Final acceptance of the sewer system will be subject to the approval of the Maryland Dept. of the Environment.
NOTES:	This permit is limited to the installation of the individual house sewer line connection.

PLANS APPROVED: Kevin J. Bell DATE: 5/25/05


**PERMIT VOID AFTER 2 YEARS**

1. CONTRACTOR IS RESPONSIBLE FOR SCHEDULING A PRE-CONSTRUCTION INSPECTION FOR ALL INSTALLATIONS.
2. ALL PARTS OF SEPTIC SYSTEM SHALL BE 100 FEET FROM ANY WATER WELL UNLESS SPECIFICALLY AUTHORIZED.
3. CONTRACTOR RESPONSIBLE FOR COMPLIANCE WITH APPLICABLE REGULATIONS, GUIDELINES AND THE TERMS OF THIS PERMIT.
4. NEITHER THE HOWARD COUNTY COUNCIL OR THE HEALTH DEPARTMENT IS RESPONSIBLE FOR THE SUCCESSFUL OPERATION OF ANY SYSTEM.
5. PERMITTEE RESPONSIBLE FOR OBTAINING FINAL APPROVAL ON THIS PERMIT.

**CALL 410-313-1771 FOR INSPECTION OF SEPTIC CONNECTION**

P523289

NOT TO SCALE

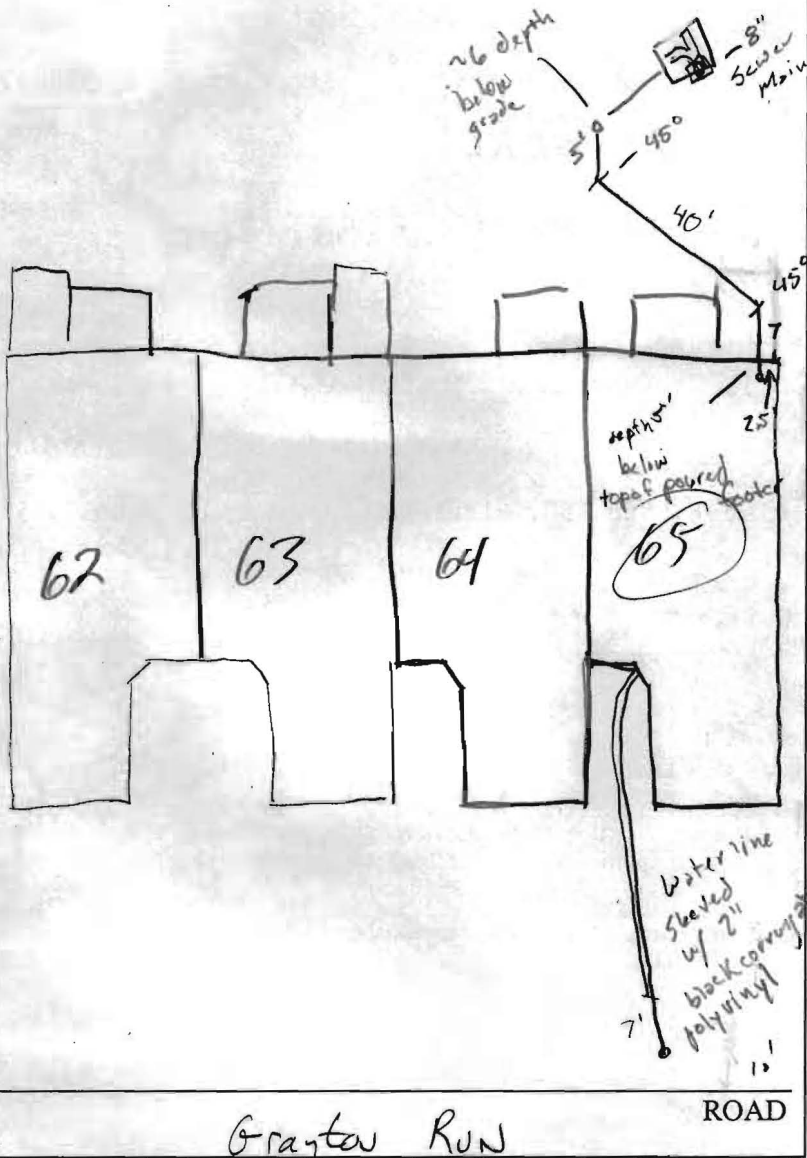

TRENCH/DRAINFIELD DATA		
WIDTH	INLET	BOTTOM

SEPTIC TANK DATA	
SEPTIC TANK 1 LEVEL	
CAPACITY	GAL
SEAM LOC	
TANK LID DEPTH	
BAFFLES	
BAFFLE FILTER	
MANHOLE LOC	
6" PORT LOC	
WATERTIGHT TEST	
SEPTIC TANK 2 LEVEL	
CAPACITY	GAL
SEAM LOC	
TANK LID DEPTH	
BAFFLES	
BAFFLE FILTER	
MANHOLE LOC	
6" PORT LOC	
WATERTIGHT TEST	

PRE-CONSTRUCTION

INSTALLATION House Connection made without payment for permit.  
Connection is good & OK to cover. No more connections to  
be made until payment is received. No approval until payment.  
(GAC) Payment 9/8/05

FINAL INSPECTOR Gabriel A. Reigle DATE OF APPROVAL 9/23/05



# HOWARD COUNTY HEALTH DEPARTMENT

15 23289

DATE  
7 / 1 / 2009

Received From

NJR

PHONE # 410-379-5956

6085 Marshalee Dr, Ste 130, Elridge MD 21075

For Septic Permits

CASH

CHECK

Homeland - Lots 102-65 on Grayton Run

NO.

259357

One thousand five hundred eighty-four and 00/100 Dollars

\$

1584 00

Received By

Mary R. Briggs