

LAYOUT N/A
INSP 1 6/23/05 INSP 3 _____
INSP 2 _____ INSP 4 _____

ISSUE DATE: 9/8/2005

APPROVAL DATE: 6/23/05

**PERMIT
INDEXED**

P 523289-A

A _____

**COMMUNITY SEPTIC SYSTEM
HOUSE SEWER LINE CONNECTION**

**HOWARD COUNTY HEALTH DEPARTMENT
BUREAU OF ENVIRONMENTAL HEALTH**

NVR Inc. T/A Ryan/Nv Homes IS PERMITTED TO INSTALL ALTER

ADDRESS: 6085 Marshalee Dr., Suite 140 PHONE NUMBER: 410-796-0980

SUBDIVISION Homeland Unit # 62

ADDRESS: 12015 Grayton Run PROPERTY OWNER: NVR Inc. t/a Ryan Homes

NUMBER OF BEDROOMS: 2

HOUSE SERVED BY PUBLIC WATER

LOCATION:	Install 4" house sewer line connection per the approved site plan. Final acceptance of the sewer system will be subject to the approval of the Maryland Dept. of the Environment.
NOTES:	This permit is limited to the installation of the individual house sewer line connection.

PLANS APPROVED: Kevin J. Bell DATE: 6/02/05

PERMIT VOID AFTER 2 YEARS


1. CONTRACTOR IS RESPONSIBLE FOR SCHEDULING A PRE-CONSTRUCTION INSPECTION FOR ALL INSTALLATIONS.
2. ALL PARTS OF SEPTIC SYSTEM SHALL BE 100 FEET FROM ANY WATER WELL UNLESS SPECIFICALLY AUTHORIZED.
3. CONTRACTOR RESPONSIBLE FOR COMPLIANCE WITH APPLICABLE REGULATIONS, GUIDELINES AND THE TERMS OF THIS PERMIT.
4. NEITHER THE HOWARD COUNTY COUNCIL OR THE HEALTH DEPARTMENT IS RESPONSIBLE FOR THE SUCCESSFUL OPERATION OF ANY SYSTEM.
5. PERMITTEE RESPONSIBLE FOR OBTAINING FINAL APPROVAL ON THIS PERMIT.

CALL 410-313-1771 FOR INSPECTION OF SEPTIC CONNECTION

P523287-1

NOT TO SCALE

Taps currently 4 1/2 - 5' below grade

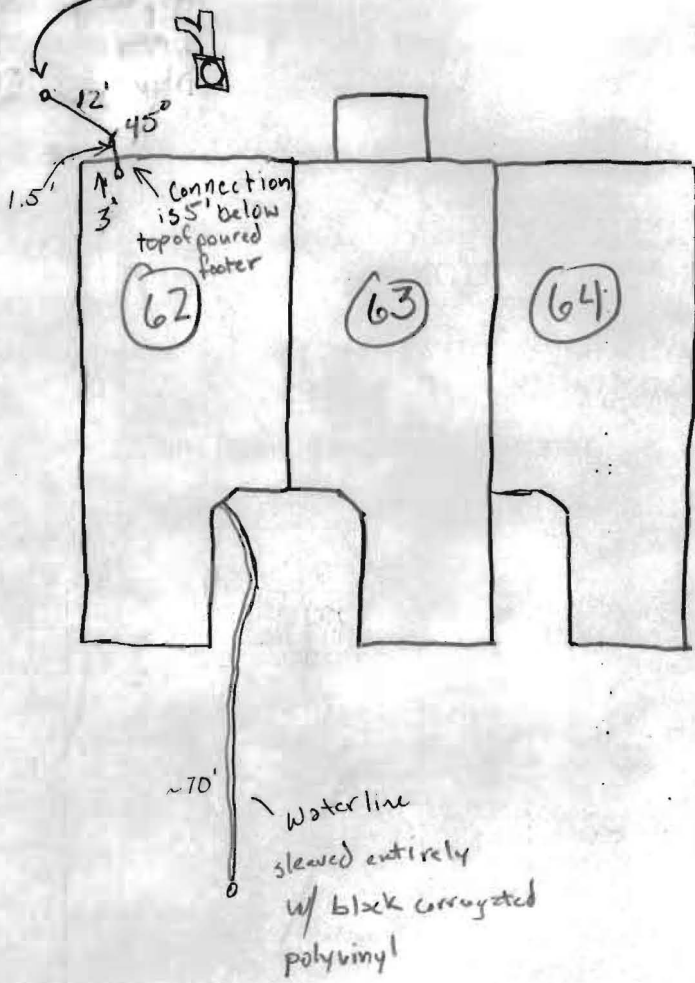

Grayton Run

ROAD

TRENCH/DRAINFIELD DATA		
WIDTH	INLET	BOTTOM


SEPTIC TANK DATA	
SEPTIC TANK 1 LEVEL	
CAPACITY	_____ GAL
SEAM LOC	_____
TANK LID DEPTH	_____
BAFFLES	_____
BAFFLE FILTER	_____
MANHOLE LOC	_____
6" PORT LOC	_____
WATERTIGHT TEST	_____
SEPTIC TANK 2 LEVEL	
CAPACITY	_____ GAL
SEAM LOC	_____
TANK LID DEPTH	_____
BAFFLES	_____
BAFFLE FILTER	_____
MANHOLE LOC	_____
6" PORT LOC	_____
WATERTIGHT TEST	_____

PRE-CONSTRUCTION _____

INSTALLATION 6/23/05 Connection made without payment from builder for permit. Connection is good & OK to cover. No more connections to be made until payment is made. (GAC) No approval until payment (GAC) Payment made 9/8/05

FINAL INSPECTOR Galid A. [Signature]

DATE OF APPROVAL 6/23/05

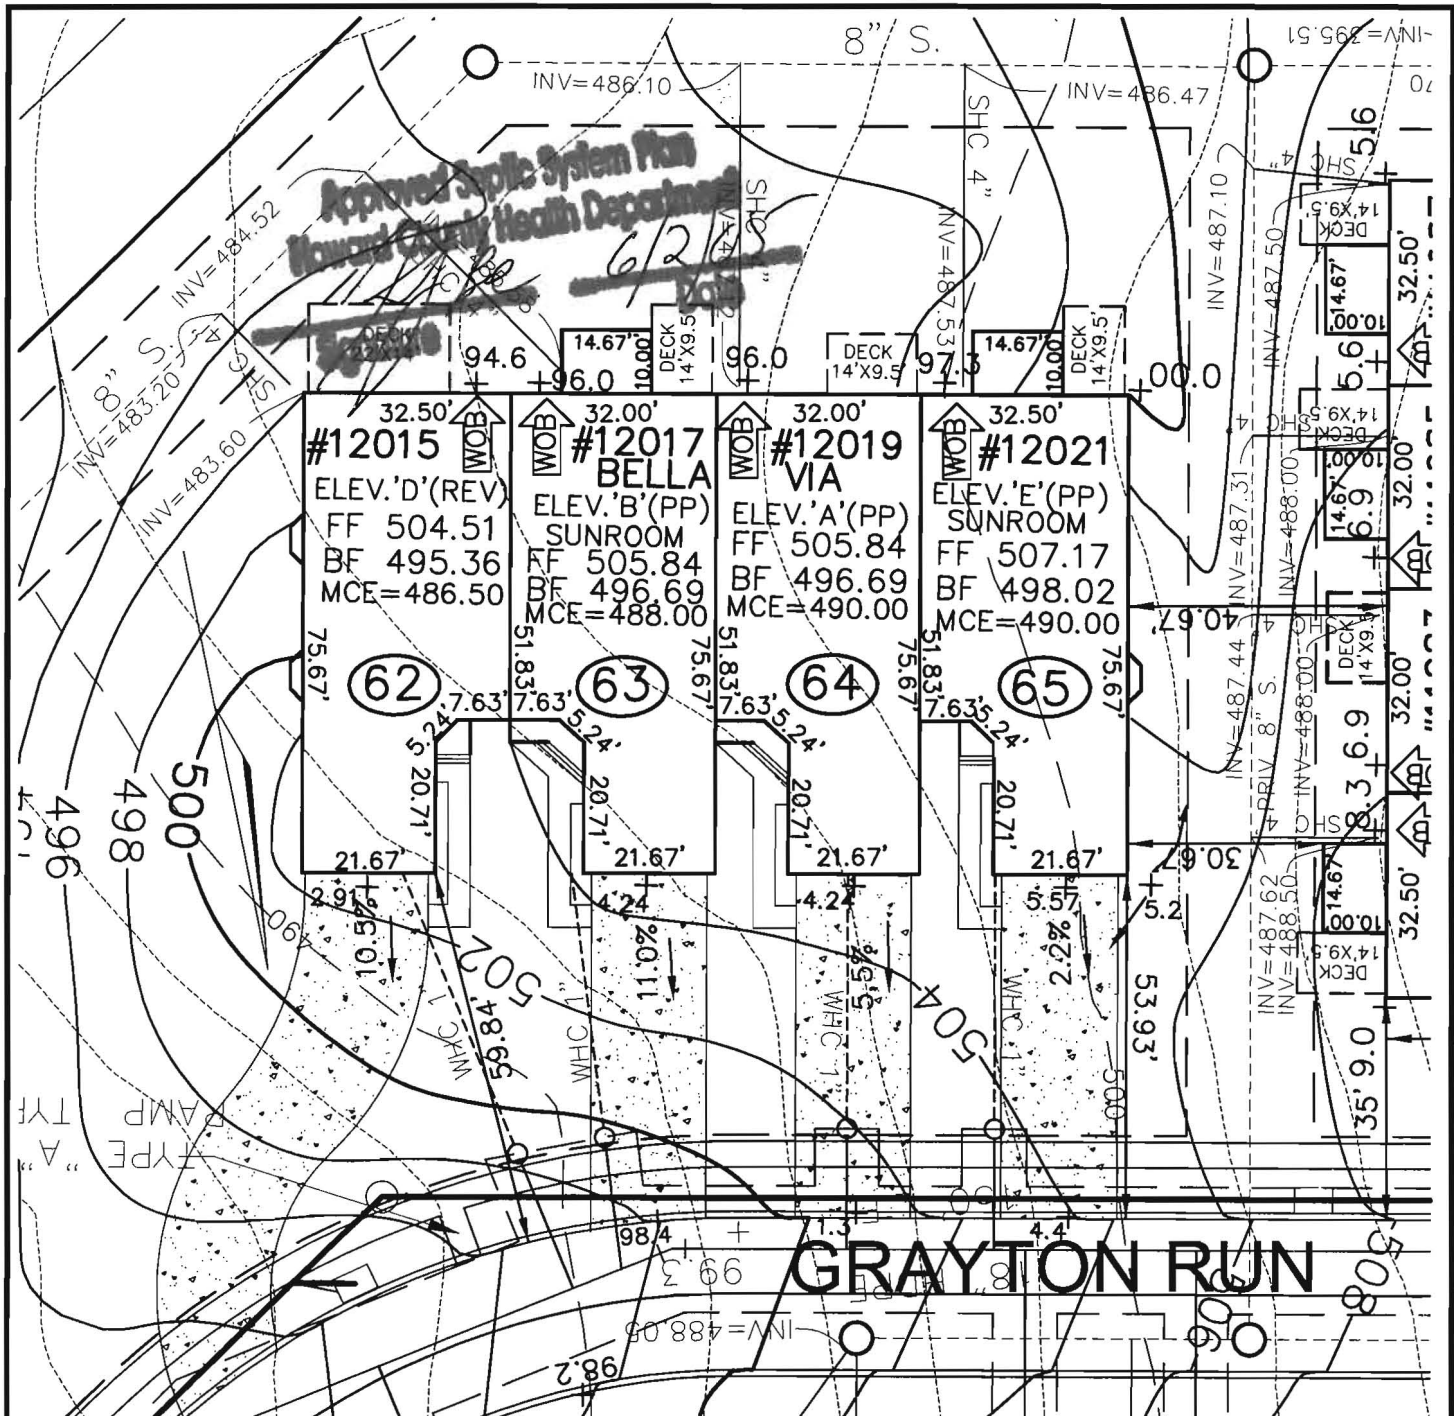

ROBERT H. VOGEL
ENGINEERING, INC.
ENGINEERS • SURVEYORS • PLANNERS
8407 MAIN STREET TEL: 410.461.7666
ELlicOTT CITY, MD 21043 FAX: 410.461.8961

SCALE 1"=30'
DRAWN BY JCO
CHECKED BY RHV
DATE MAY, 2005
W. O. # 04-87.00
SHEET# 1 OF 1

NV HOMES
ELlicOTT MEADOWS
UNITS 62-65

HOMELAND SDP-03-30
TAX MAP 16
3RD ELECTION DISTRICT

PARCEL 53,96,165&204
HOWARD COUNTY, MARYLAND



HOWARD COUNTY HEALTH DEPARTMENT

75 23289

DATE
9 / 8 / 2009

Received From

NWR

PHONE # 410-379-5956

6085 Marshalee Dr, Ste 130, Elkhridge MD 21075

For Septic Permits

CASH

CHECK

Homeland - lots 102-65 on Drayton Road

NO.

259357

One thousand five hundred eighty-four and 00/100 Dollars

\$

1584 00

Received By

Mary R. Biggs