

SITE INSPECTION SHEET

A # 23065

OWNER: \_\_\_\_\_ PHONE #: \_\_\_\_\_


ADDRESS: 2546 Jennings Chapel Rd CONTRACTOR: \_\_\_\_\_

WELL TAG #: HO-73-1549

SUBDIVISION: \_\_\_\_\_ LOT: \_\_\_\_\_ COUNTY #: \_\_\_\_\_

PROPOSAL: House Fire Damage - Well cap broken  
Well top open

LOCATION DIAGRAM

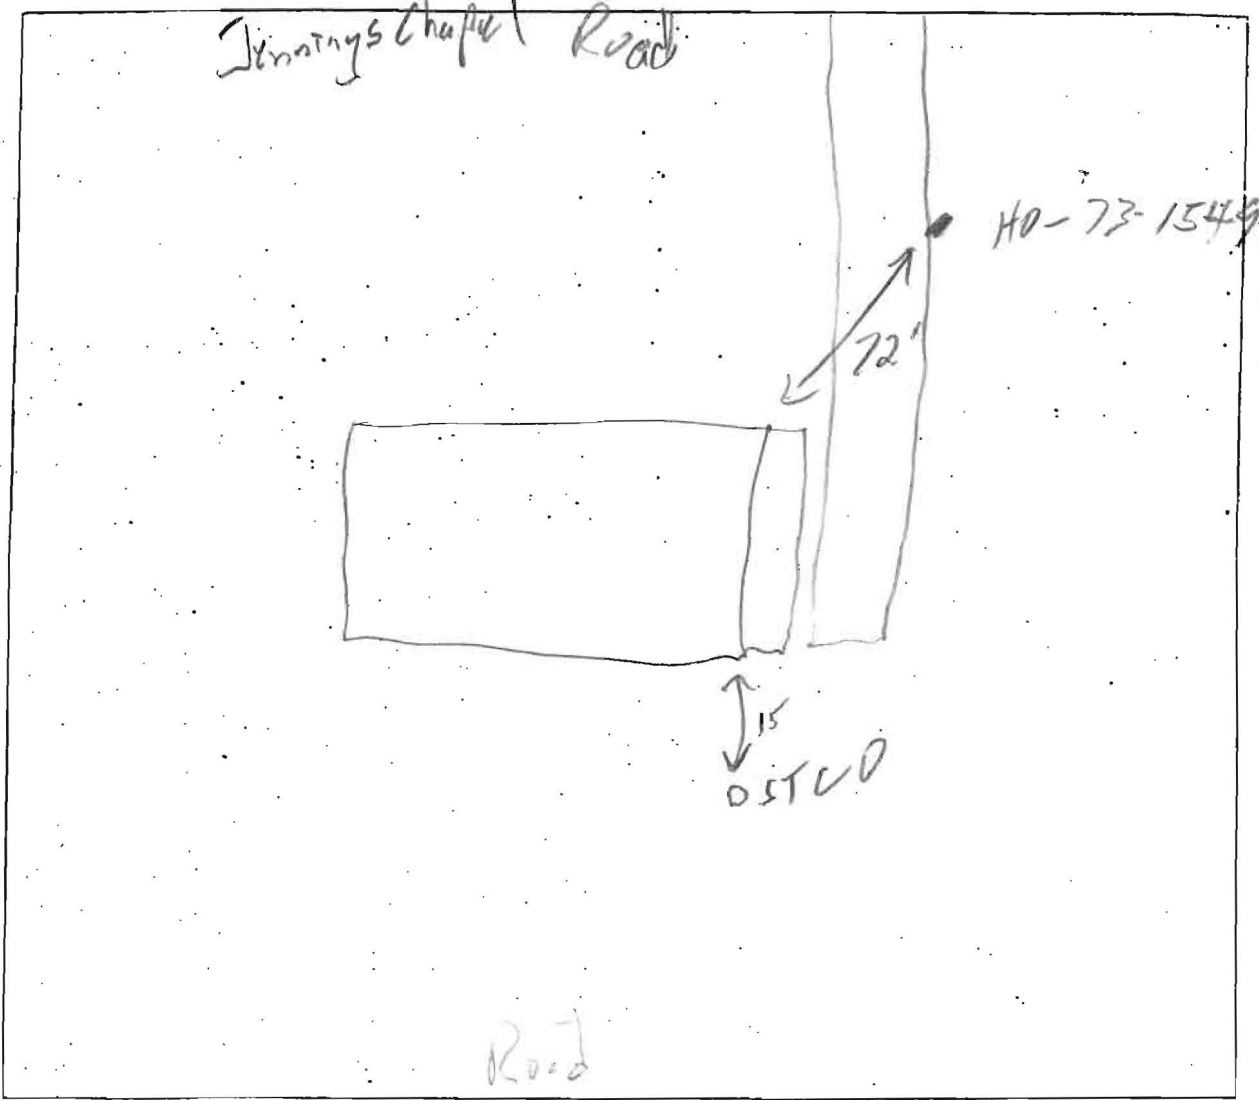

COMMENTS: \_\_\_\_\_

\_\_\_\_\_