

PUB. SEWER STATUS VERIFIED BY _____

ISSUE DATE: _____

APPROVAL DATE: _____

PERMIT

P _____

A W517372

INDEXED

ON-SITE SEWAGE DISPOSAL SYSTEM HOWARD COUNTY HEALTH DEPARTMENT BUREAU OF ENVIRONMENTAL HEALTH *05-351065*

IS PERMITTED TO INSTALL ALTER

ADDRESS: _____ PHONE NUMBER: _____

SUBDIVISION: _____ LOT NUMBER: _____

ADDRESS: 13111 Linden Church Road PROPERTY OWNER: Kathleen Gilliece

SEPTIC TANK CAPACITY (GALLONS): _____

PUMP CHAMBER CAPACITY (GALLONS): _____

NUMBER OF BEDROOMS: _____

SQUARE FEET PER BEDROOM: _____

LINEAR FEET OF TRENCH REQUIRED: _____

TRENCHES:	Trench to be _____ feet wide. Inlet _____ feet below original grade. Bottom maximum depth _____ feet below original grade. Effective area begins at _____ feet below original grade. _____ feet of stone below distribution pipe.
LOCATION:	_____
PURPOSE:	_____

PLANS APPROVED: _____ DATE: _____

- NOTE: PERMIT VOID AFTER 2 YEARS
- NOTE: CONTRACTOR RESPONSIBLE FOR SCHEDULING A PRE-CONSTRUCTION INSPECTION FOR ALL INSTALLATIONS
- NOTE: WATERTIGHT SEPTIC TANKS REQUIRED
- NOTE: ALL PARTS OF SEPTIC SYSTEM SHALL BE 100 FEET FROM ANY WATER WELL
- NOTE: MANHOLE RISERS REQUIRED ON ALL SEPTIC TANKS AND PUMP CHAMBERS

NEITHER THE HOWARD COUNTY COUNCIL NOR THE HEALTH DEPARTMENT IS RESPONSIBLE FOR THE SUCCESSFUL OPERATION OF ANY SYSTEM PERMITTEE RESPONSIBLE FOR OBTAINING FINAL APPROVAL ON THIS PERMIT CALL 410-313-2640 FOR INSPECTION OF SEPTIC SYSTEM

W517372

SITE INSPECTION SHEET

7/17/02
10:00

OWNER: Gilliece

DATE REQUESTED: _____

PHONE #: 410-988-9724


CONTRACTOR: J Mayne

ADDRESS: 13111 Linden Church Rd

WELL TAG #: _____

COUNTY #: _____

PROPOSAL: replacement well requested due to inadequate flow

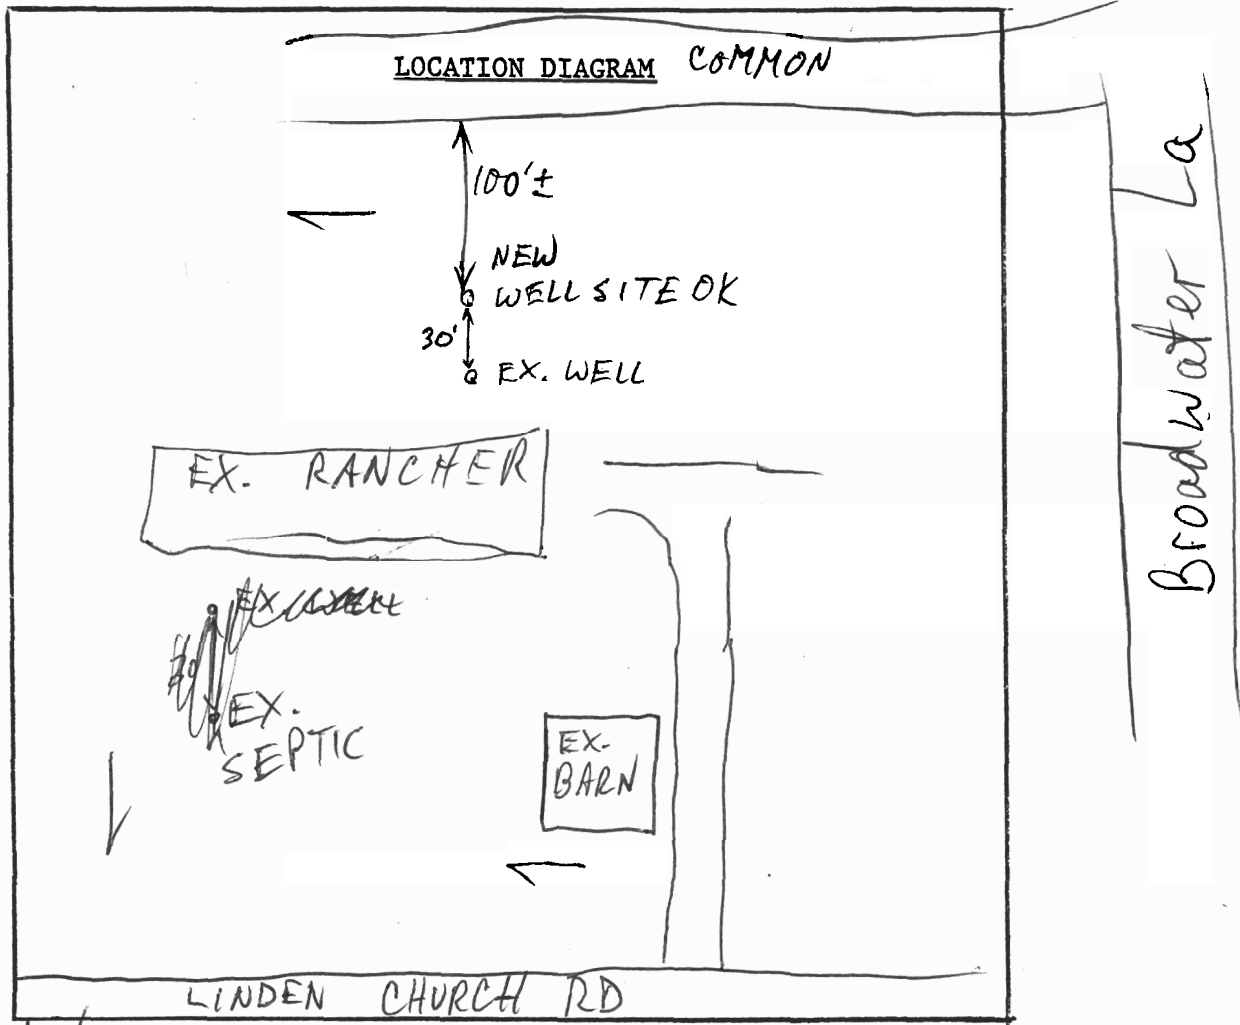

COMMENTS: 7/18/02 NEW WELL SITE OK; EX. WELL TO BE MAINTAINED AS OUTDOOR SUPPLY (MR)

DATE: _____

INSPECTOR: _____

9/15/75

File 9/15/75
22040
A 23118

PERMIT

SEWAGE DISPOSAL SYSTEM

MARYLAND STATE DEPARTMENT OF HEALTH

HOWARD COUNTY

INDEXED

ELLICOTT CITY

DISTRICT 5th

DATE 8/25/75

Richard Lowe

IS PERMITTED TO INSTALL X ALTER

ADDRESS Ilchester Road, Ellicott City, Md.

PHONE 747-7998

A SEWAGE DISPOSAL SYSTEM LOCATED AT _____

SUBDIVISION _____ ROAD 13111 Linden Chapel Rd. LOT 7

PROPERTY OWNER Steve W. Gilliese

ADDRESS Route 2, Box 63, Severn, Md. 21144

Phone: 796-4400 ask for Steve

SPECIFICATIONS 3 bedrooms

DRAIN FIELD _____ DEPTH _____ FEET. BOTTOM AREA _____ SQ. FT.

SEEPAGE PITS _____ ABSORBENT SIDE-WALL AREA _____ SQ. FT.

SEPTIC TANK CAPACITY 1000 GALLONS

FOR GARBAGE GRINDER, INCREASE DISPOSAL AREA 22% & TANK CAPACITY 50%.

OTHER DRY WELL - To have 170 effective square feet absorbent sidewall area per bedroom below first 3/4 ft. of original grade and maximum depth permitted for dry well is 12 ft. Locate as per specs per Mr. Gilliese house plan submission to Charles B. Breaker and 5/2/75 perc tests. Inlet can come in at 4 ft. however, good ground starts at 3 1/2 ft. Must have manhole type cleanout to final grade level on septic tank.

NOTE: ALL PIPE FROM HOUSE TO DISPOSAL AREA MUST BE CAST IRON. PERMIT VOID AFTER THREE YEARS. NOTE: STAND PIPES MUST BE 6 INCHES IN DIAMETER. CAST IRON, CONCRETE OR TERRA COTTA ACCEPTED.

PLANS APPROVED BY Charles B.


DATE 5/2/75

FILL SEPTIC TANK AND DISTRIBUTION BOX WITH WATER BEFORE CALLING FOR AN INSPECTION. COVER NO WORK UNTIL INSPECTED AND APPROVED.

NEITHER THE HOWARD COUNTY COMMISSIONERS NOR THE HEALTH DEPARTMENT IS RESPONSIBLE FOR THE SUCCESSFUL OPERATION OF ANY SYSTEM.

21418

21418

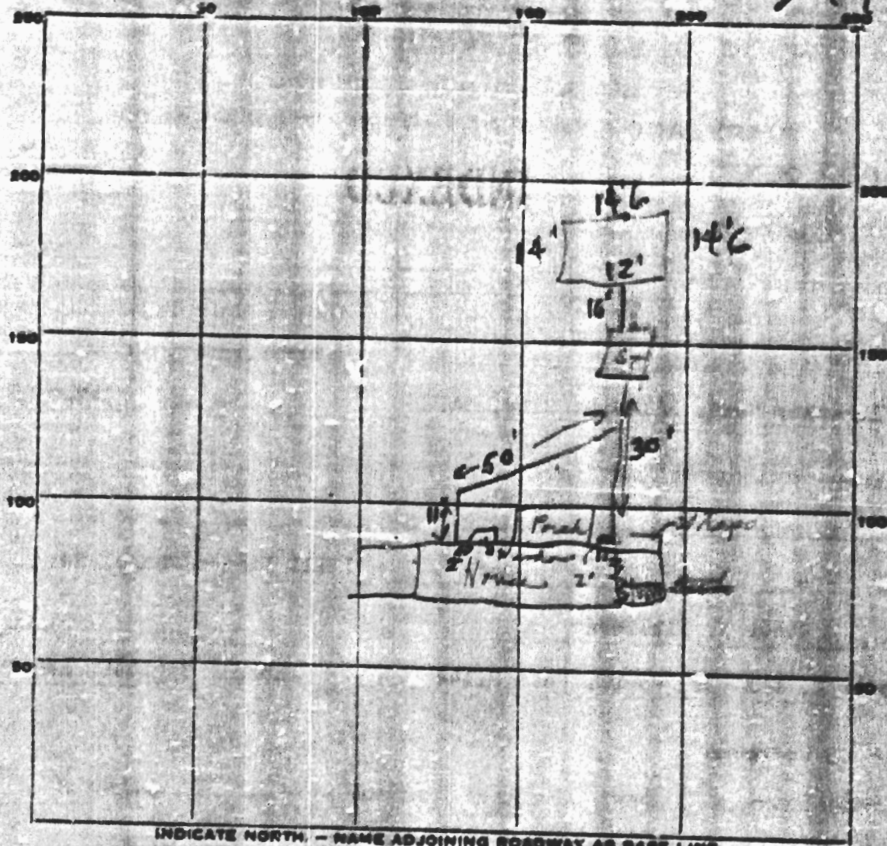

PERMIT CARD Yes found
 SEPTIC TANK LEVEL 1 CLEANOUTS S.T. / P.W.
 DISTRIBUTION BOX LEVEL ---

TILE FIELD, DEPTH --- FT. TRENCH WIDTH --- FT.
 ① GRAVEL DEPTH 7 1/2 FT. TOTAL LENGTH 18 FT. ① 12 1/2 FT.
 NUMBER OF TRENCHES 1 TOTAL BOTTOM AREA ---

SEEPAGE PITS, INSIDE DIAMETER 5 1/2 FT. DEPTH BELOW INLET 8 1/2 FT.
 ABSORBENT AREA 602 ± SQ. FT.

REMARKS 7/15/75 Good sign all the way ② 476

DATE SYSTEM APPROVED 7/15/75 INSPECTOR C. P. [Signature]

14 deep
 5 1/2
 8 1/2 in
 1 1/2
 4 1/2
 170
 476
 602

35
R₂ test

2004
Label
has to
Local records

APPLICATION

A 21013

SEWAGE DISPOSAL TESTING

STATE OF MARYLAND - DEPARTMENT OF HEALTH AND MENTAL HYGIENE

HOWARD COUNTY HEALTH DEPARTMENT
ENVIRONMENTAL HEALTH SERVICES

*1-3 Bedrooms, 1000 gallon
1250 gallon*
DISTRICT _____
DATE 5/20/75

P. O. BOX 478, ELLICOTT CITY, MARYLAND 21043
TELEPHONE: 443-5000, EXT. 398

5/2/75
1:30

*Dig well to have 170 suffocation discharge
sidewall area per bedroom below first 5' of soil and
maximum depth 12'. Location as per specs per Mr. Sullivan
house per submission to G.R. and 5/2/75 per tests G.R.
(Note inlet can come in at 4'.) C.R.D.
good ground starts at 5 1/2', however*

TO: THE COUNTY HEALTH OFFICER
ELLICOTT CITY, MARYLAND

*Must have manhole type cleanout
to final grade level*

I, HEREBY, APPLY FOR THE NECESSARY TEST IN ORDER TO CONSTRUCT (OR RECONSTRUCT) A SEWAGE DISPOSAL SYSTEM.

PROPERTY OWNER Steve W. Gillice

ADDRESS Route 2, Box 61, Sykesville, Maryland 21144 PHONE 736-4400 ask for Steve

PROPERTY LOCATION:

SUBDIVISION _____ LOT NO. 7

ROAD AND DESCRIPTION Linden Chapel Road off Broadwater Lane (Off Route 32)

SIZE OF LOT 5,000 sqft TYPE BLDG. 1 or 2

IF NOT SINGLE RESIDENCE DESCRIBE _____ NUMBER OF BEDROOMS (Single Faly. Dwlg.)

THE SYSTEM INSTALLED UNDER THIS APPLICATION IS ACCEPTABLE ONLY UNTIL PUBLIC FACILITIES BECOME AVAILABLE.

SIGNATURE OF APPLICANT /s/ Steve Gillice

✓ APPROVED BY C. B. Shuster FOR Dig Well DATE 5/2/75
(KIND OF SYSTEM)

REJECTED BY _____ FOR _____ DATE _____
(KIND OF SYSTEM)


HOLD PENDING FURTHER TESTS _____ DATE _____

REASONS FOR REJECTION OR HOLDING _____

BLDG. PERMIT SIGNED
AND RETURNED 5/2/75

THIS IS NOT A PERMIT

A 2148

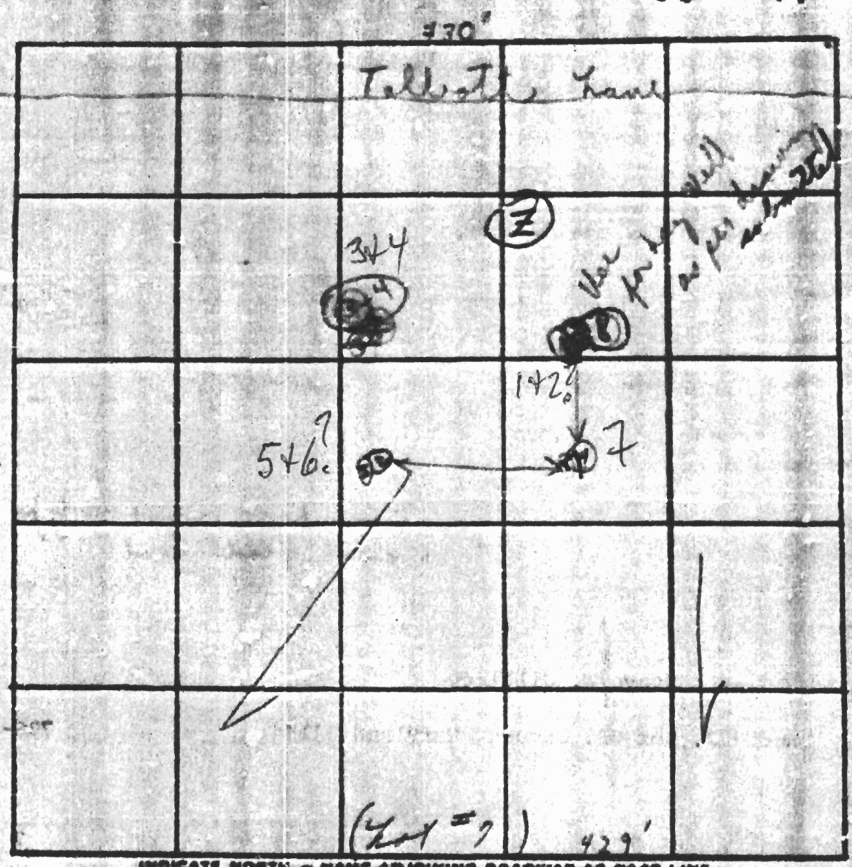

INDICATE NORTH - NAME ADJOINING ROADWAY AS BASE LINE

Kenner's Church Road

DATE	TEST NO.	DEPTH	PRE-WET		TEST - 1" DROP		TIME	
			START	STOP	START	STOP		
5/1/75	1	4 1/2'	1:05	1:	Pulled plug, lowered	1:13	11 in. hole	
	2	11 1/2'	1:07	1:13	1:13	1:30	12 min	
	3	4 1/2'	1:23	1:25	1:25	1:28	3 min	
	4	11'	1:22	1:25	1:25	1:27	4 min	
	5	4'	1:36	1:50	1:50	2:15	25 min	
	6	12'	1:40	1:44	1:44	1:50	6 min	
	7	10 1/2'	visual similar to other					
	8	5 1/2'	1:52	1:59	1:59	2:14	15 min	
5-2-72	X	4 1/2 ft		15 min	16 min	6	70	
	X	12 1/2 ft		4 min	12 min			

Vandy to Area below clay
↓

orig tests A16971 same basic area

REMARKS

TYPE OF SOIL