

1/23/02
10:00

ISSUE DATE: 1/18/2002

PERMIT

P 516481

APPROVAL DATE: 1/23/02

A REPAIR

ON-SITE SEWAGE DISPOSAL SYSTEM HOWARD COUNTY HEALTH DEPARTMENT BUREAU OF ENVIRONMENTAL HEALTH

05-364205

INDEXED

Jenkins Brothers

IS PERMITTED TO INSTALL ALTER

ADDRESS: 7670 Smith's Private Road PHONE NUMBER: 410-461-9282

SUBDIVISION: Holiday Hills LOT NUMBER: 70

ADDRESS: 10714 Hunting Lane PROPERTY OWNER: Randall

SEPTIC TANK CAPACITY (GALLONS): 1000 Ex

PUMP CHAMBER CAPACITY (GALLONS): —

NUMBER OF BEDROOMS: 3

SQUARE FEET PER BEDROOM: 240

LINEAR FEET OF TRENCH REQUIRED: 75'±

TRENCHES:	Trench to be 2 feet wide. Inlet 5 feet below original grade. Bottom maximum depth 12 feet below original grade. Effective area begins at 5 feet below original grade. 7 feet of stone below distribution pipe.
LOCATION:	Run trench on contour to the left lot line
PURPOSE:	Existing septic system has failed. Scheduled inspection of septic repair for Wednesday, January 23, 2002.

PLANS APPROVED: Brian Baker DATE: 1/17/2002



- NOTE: PERMIT VOID AFTER 2 YEARS
- NOTE: CONTRACTOR RESPONSIBLE FOR SCHEDULING A PRE-CONSTRUCTION INSPECTION FOR ALL INSTALLATIONS
- NOTE: WATERTIGHT SEPTIC TANKS REQUIRED
- NOTE: ALL PARTS OF SEPTIC SYSTEM SHALL BE 100 FEET FROM ANY WATER WELL
- NOTE: MANHOLE RISERS REQUIRED ON ALL SEPTIC TANKS AND PUMP CHAMBERS

NEITHER THE HOWARD COUNTY COUNCIL NOR THE HEALTH DEPARTMENT IS RESPONSIBLE FOR THE SUCCESSFUL OPERATION OF ANY SYSTEM PERMITTEE RESPONSIBLE FOR OBTAINING FINAL APPROVAL ON THIS PERMIT CALL 410-313-2640 FOR INSPECTION OF SEPTIC SYSTEM

P516481

NOT TO SCALE

EX WELL?

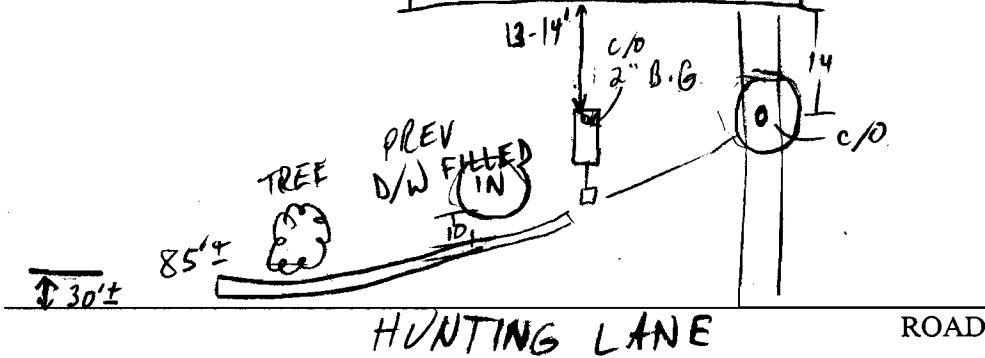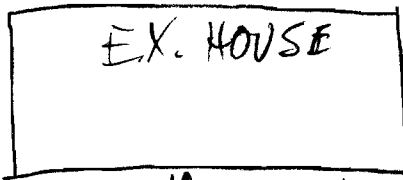

TRENCH/DRAINFIELD DATA		
WIDTH	INLET	BOTTOM
2	5	12
NUMBER OF TRENCHES		1
TOTAL LENGTH		85±
ABSORPTION AREA		595±
DISTRIBUTION BOX LEVEL		✓
DISTRIBUTION BOX BAFFLE		✓
DISTRIBUTION BOX PORT		—

SEPTIC TANK DATA	
SEPTIC TANK 1 LEVEL	EX
CAPACITY	1000 GAL
SEAM LOC	_____
TANK LID DEPTH	_____
BAFFLES	_____
BAFFLE FILTER	_____
MANHOLE LOC	_____
6" PORT LOC	FRONT
WATERTIGHT TEST	_____
SEPTIC TANK 2 LEVEL	_____
CAPACITY	_____ GAL
SEAM LOC	_____
TANK LID DEPTH	_____
BAFFLES	_____
BAFFLE FILTER	_____
MANHOLE LOC	_____
6" PORT LOC	_____
WATERTIGHT TEST	_____

PRE-CONSTRUCTION 1/23/02 OK TO START PER SPECS (MR)

INSTALLATION 1/23/02 OK TO COVER

FINAL INSPECTOR M. Ripkin DATE OF APPROVAL 1/28/02