

**HOWARD COUNTY
 PERMIT APPLICATION**

PERMIT NUMBER

B 00132595

Building Address 840 Marriottsville Rd.
Marriottsville 21104
 Suite/Apt. #: _____ SDP/WP/Petition #: _____
 Census Tract 6030 Subdivision _____
 Section _____ Area _____ Lot _____
 Tax Map _____ Parcel _____ Grid _____
 Zoning _____ Map Coordinates 6A7 Lot size _____

Property Owner's Name Keith Link
 Address 740 Marriottsville Rd
 City Marriottsville State MD Zip Code 21104
 Home Phone 410 442 1122 Work Phone _____
 Applicant's Name & Mailing Address, (if other than stated hereon):
Damon J. Hammersla
905 Reynolds Rd.
Kennettown MD 21136
 Phone 410 833 0850 Fax 410 329 2075

Existing Use SFD
 Proposed Use SFD 16' Ground Pool
 Estimated Construction Cost \$ 20,000
 Description of Work Construct a 16' x 16' pool
with 3.6' deep
pool by tank, 16' x 16' x 3.6' deep

Contractor Company Craw Pools
 Contact Person Damon J. Hammersla
 Address 905 Reynolds Rd.
 City Kennettown State MD Zip Code 21136
 License No. 1272
 Phone (410) 833-0850 Fax 410 329 2075

Occupant or Tenant _____
 Contact Name _____
 Address _____
 City _____ State _____ Zip Code _____
 Phone _____ Fax _____

Engineer or Architect Company _____
 Contact Person _____
 Address _____
 City _____ State _____ Zip Code _____
 Phone _____ Fax _____

BUILDING DESCRIPTION - COMMERCIAL

BUILDING DESCRIPTION - RESIDENTIAL

Building Characteristics
 Height: _____
 No. of stories: _____
 Gross area, sq. ft. per floor: _____
 Use group: _____
 Construction type:
 Reinforced Concrete
 Structural Steel
 Masonry
 Wood Frame
 State Certified Modular

Utilities
 Water Supply:
 Public
 Private
 Sewage Disposal:
 Public
 Private
 Electric Yes No
 Gas Yes No
 Heating System:
 Electric Oil
 Natural Gas
 Propane Gas
 Sprinkler system: N/A
 Full
 Partial
 Other Suppression
 # of Heads

Building Characteristics
 SF Dwelling SF Townhouse
 Depth _____ Width _____
 1st floor: _____
 2nd floor: _____
 Basement: _____
 Finished Basement Unfinished Basement
 Crawl space Slab on Grade
 No. of Bedrooms _____
 Multi-family dwellings:
 No. of efficiency units: _____
 No. of 1 BR units: _____
 No. of 2 BR units: _____
 No. of 3 BR units: _____
 Other Structure: _____
 Dimensions: _____
 Footings: _____
 Roof: _____
 State Certified Modular
 Manufactured Home

Utilities
 Water Supply:
 Public
 Private
 Sewage Disposal:
 Public
 Private
 Electric Yes No
 Gas Yes No
 Heating System:
 Electric Oil
 Natural Gas
 Propane Gas
 Sprinkler system: N/A
 NFPA #13D
 NFPA #13R
 Other:

APPLICANT HEREBY CERTIFIES AND AGREES AS FOLLOWS: (1) THAT HE/SHE IS AUTHORIZED TO MAKE THIS APPLICATION; (2) THAT THE INFORMATION IS CORRECT; (3) THAT HE/SHE WILL COMPLY WITH ALL REGULATIONS OF HOWARD COUNTY WHICH ARE APPLICABLE THERETO; (4) THAT HE/SHE WILL PERFORM NO WORK ON THE ABOVE REFERENCED PROPERTY NOT SPECIFICALLY DESCRIBED IN THIS APPLICATION; (5) THAT HE/SHE GRANTS COUNTY OFFICIALS THE RIGHT TO ENTER ONTO THIS PROPERTY FOR THE PURPOSE OF INSPECTING THE WORK PERMITTED AND POSTING NOTICES.

Applicant's Signature _____
 Company Craw Pools

Print Name Damon J. Hammersla
 Date 9/27/01

Checks payable to: **DIRECTOR OF FINANCE OF HOWARD COUNTY**
**** PLEASE WRITE NEATLY AND LEGIBLY. ****
- FOR OFFICE USE ONLY -

DATE 9/28/01 SIGNATURE APPROVAL Brian Baker
 Development, DPZ _____
 Highways _____
 Engineering Official _____
 Engineering, DPZ _____
 Detection _____
 Contingency Construction Start:
 ONE STOP SHOP:

DPZ SETBACK INFORMATION
 Front: _____
 Rear: _____
 Side: _____
 Side St.: _____
 All minimum setbacks met? YES NO
 Is Entrance Permit required? YES NO
 Historic District? YES NO
 Lot Coverage for NewTown Zone _____
 SDP/Red-line approval date _____

PROPERTY ID#: 52306
 Filing fee \$ _____
 Permit fee \$ 270
 Excise tax \$ _____
 Add'l per. fee \$ _____
 TOTAL FEES \$ 270
 Sub-total paid \$ _____
 Balance due \$ _____
 Check # 0-11
 Validation # 43226


Accepted by (Signature)

Post-It® Fax Note	7671	Date		# of pages	2
To	DANNON	From	KEITH LINKS		
Co. Dept		To			
Phone #		Fax #			



WOOD GAZEBO

NOTE: WOOD GAZEBO APPEARS TO ENCRACH ADJACENT PROPERTY

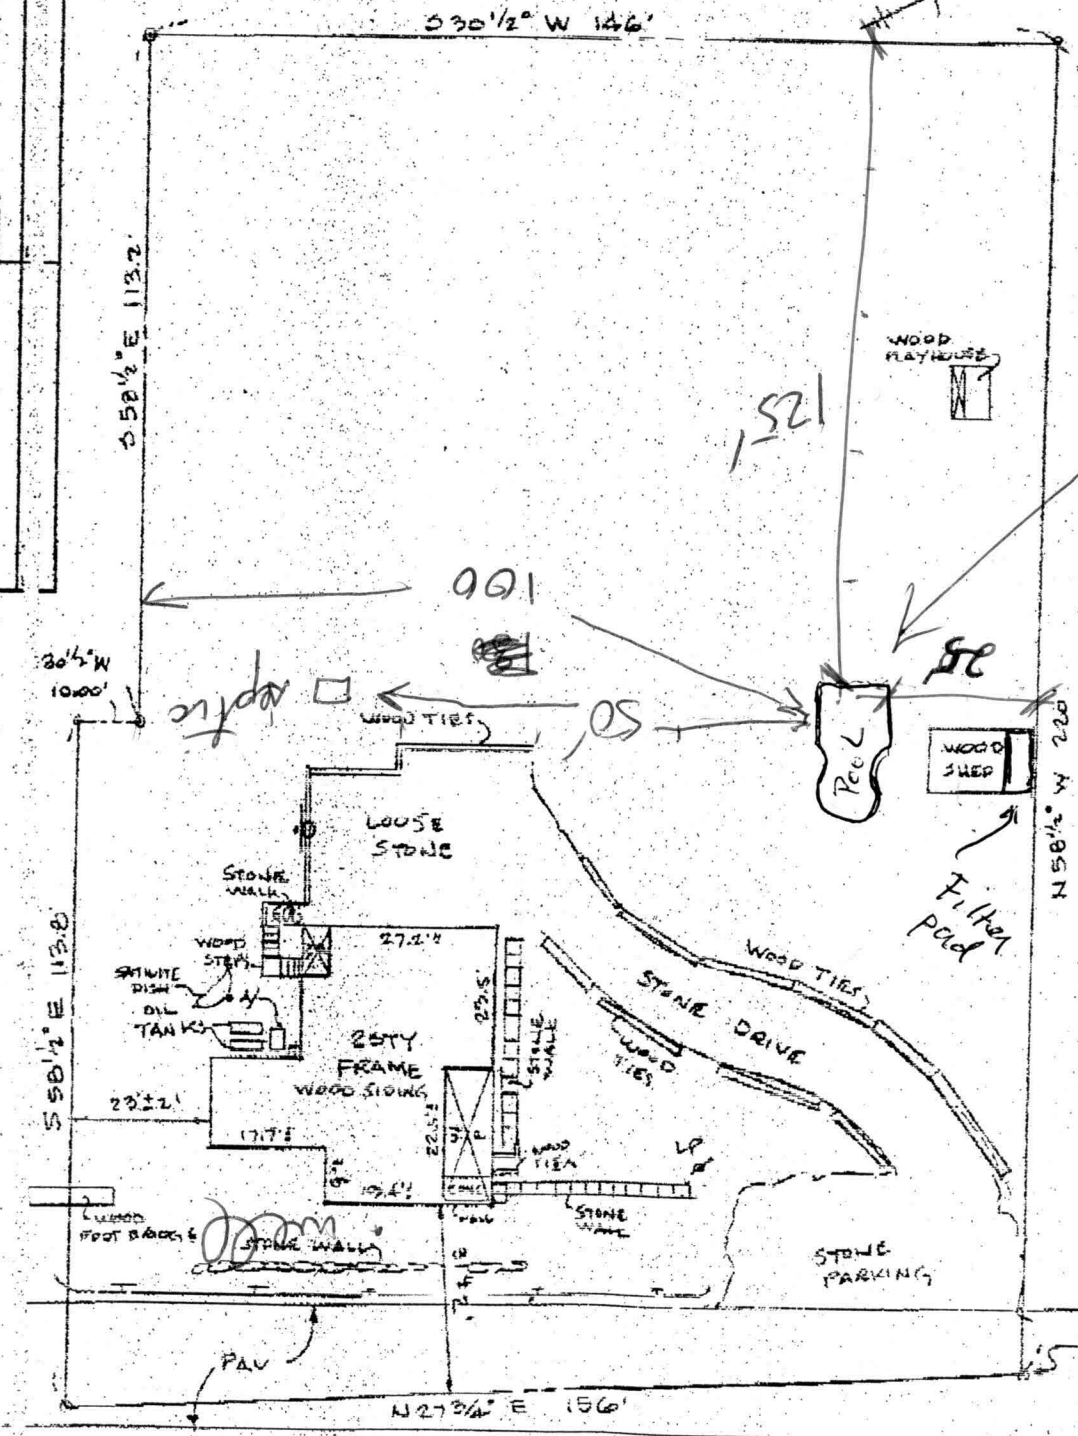

9/28/01
Proposed
Pool location
O.K.
(BB)

MARRIOTTSVILLE ROAD

The plat is of benefit to a consumer only insofar as it is required by a lender or a title insurance company or its agent in connection with contemplated transfer, financing or refinancing. The plat is not to be relied upon for the establishment of boundaries.

*840 MARRIOTTSVILLE ROAD