

APPROVED
WALK-THRU BUILDING PERMIT
 BP# R00154007 A# 27887
 APP. SAN KJB DATE: 5/25/05
 DESC. OF WORK: 17 x 41 Pad

034-225
MORGES

A-27887
 12-64620

N41°05'16" W
 200.00'


307' ±

13376 HUNT RIDGE.

LOCATION SURVEY PLAT
 SUBJECT PROPERTY NOT LOCATED IN A FLOOD PLAIN AREA UNLESS OTHERWISE NOTED

CERTIFICATION SEAL SCALE 1"=50' DATE 6-23-1994

This is to certify that I have surveyed

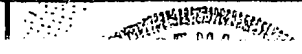

FOR DESC. 7 &
 SEE L.2010 F.721