

# APPLICATION

A 18306

SEWAGE DISPOSAL TESTING  
STATE OF MARYLAND - DEPARTMENT OF HEALTH AND MENTAL HYGIENE  
HOWARD COUNTY HEALTH DEPARTMENT  
ENVIRONMENTAL HEALTH SERVICES  
P. O. BOX 478, ELLICOTT CITY, MARYLAND 21043  
TELEPHONE: 465-8000, EXT. 388

P \_\_\_\_\_  
DISTRICT 3rd  
DATE 4/18/73

TO: THE COUNTY HEALTH OFFICER  
ELLICOTT CITY, MARYLAND

I, HEREBY, APPLY FOR THE NECESSARY TEST IN ORDER TO CONSTRUCT (OR RECONSTRUCT) A SEWAGE DISPOSAL SYSTEM.

PROPERTY OWNER Adelphia Developers Purdum & Jeschke  
ADDRESS 6931 Donachie Road, Balto., Md. 21239 PHONE 465-1635

PROPERTY LOCATION:  
SUBDIVISION Adelphia LOT NO. 17  
ROAD AND DESCRIPTION Unnamed road

SIZE OF LOT 40,500 sq. ft. TYPE BLDG. 3 or 4 bedrooms  
NUMBER OF BEDROOMS

IF NOT SINGLE RESIDENCE DESCRIBE \_\_\_\_\_

THE SYSTEM INSTALLED UNDER THIS APPLICATION IS ACCEPTABLE ONLY UNTIL PUBLIC FACILITIES BECOME AVAILABLE.

SIGNATURE OF APPLICANT /s/ Purdum & Jeschke

APPROVED BY \_\_\_\_\_ FOR \_\_\_\_\_ (KIND OF SYSTEM) DATE \_\_\_\_\_

REJECTED BY \_\_\_\_\_ FOR \_\_\_\_\_ (KIND OF SYSTEM) DATE \_\_\_\_\_


HOLD PENDING FURTHER TESTS \_\_\_\_\_ DATE \_\_\_\_\_

REASONS FOR REJECTION OR HOLDING \_\_\_\_\_

## THIS IS NOT A PERMIT

# APPLICATION

150'

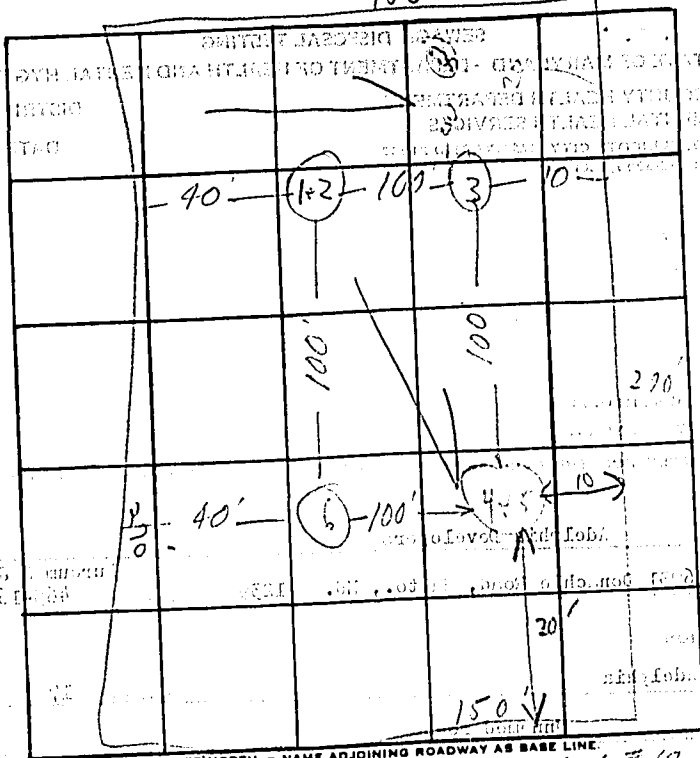

DATE	TEST NO.	DEPTH	PRE-WET		TEST - 1" DROP		TIME
			START	STOP	START	STOP	
4/24/21	1	3'	2:25	2:27	2:27	2:30	3 min
	2	10 1/2'	2:25	2:30	2:30	2:38	8 min
	3	9' + 1/2'					4 min
	4	2 1/2'	2:40	2:44	2:44	2:50	6 min
July 23	5	10"	2:40	2:43	2:43	2:51	8 min
	6	9' + 1/2'					4 min
7/21	7	15'	5:00				4:25

REMARKS: Certified Soils Works Holes Certified  
 TYPE OF SOIL: Wanda m...