


spoke to Mr. Schuster on 10/22/76

he will
have cap
loosen to
have DW
depth
checked
ok to
cover however
DW will
be checked

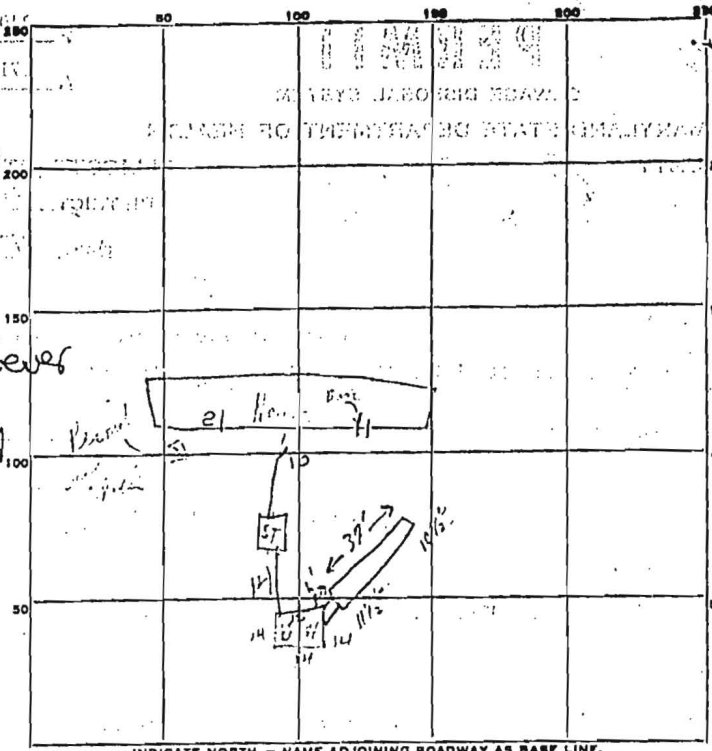

INDICATE NORTH - NAME ADJOINING ROADWAY AS BASE LINE.

PERMIT CARD _____

SEPTIC TANK, LEVEL 1250 CLEANOUTS S.T. / D.W.

DISTRIBUTION BOX, LEVEL _____

TILE-FIELD, DEPTH 10 1/2 - 11 FT. TRENCH WIDTH _____ FT.

GRAVEL DEPTH 7.5 IN. TOTAL LENGTH 37 FT.

NUMBER OF TRENCHES _____ TOTAL BOTTOM AREA 277.5

SEEPAGE PITS, INSIDE DIAMETER 57 FT. DEPTH BELOW INLET 6 1/2 FT.

ABSORBENT AREA _____ SQ. FT.

REMARKS 10/19/76 checked trench 37' long with depth
10/21 - unable to measure depth of clay well - placed paper
on all stone in D.W. then call for final
 DATE SYSTEM APPROVED 10/22/76 INSPECTOR W.A. BENSON