

INDEXED

PERMIT

SEWAGE DISPOSAL SYSTEM

MARYLAND STATE DEPARTMENT OF HEALTH

HOWARD COUNTY

ELLICOTT CITY

DISTRICT 2

DATE 6/13/62

P 05328

A 03102

6/17/62
Approved DH

INDEXED

Excavating Con.

IS PERMITTED TO INSTALL _____ ALTER _____

ADDRESS _____ PHONE _____

A SEWAGE DISPOSAL SYSTEM LOCATED AT _____

SUBDIVISION Bonnie Acres ROAD Bonnie Acres Dr. LOT 15

PROPERTY OWNER Edwards and Wilson

ADDRESS Ellicott City, Md.

SPECIFICATIONS

DRAIN FIELD _____ DEPTH _____ FEET, BOTTOM AREA _____ SQ. FT.

SEEPAGE PITS _____ ABSORBENT SIDE-WALL AREA _____ SQ. FT.

SEPTIC TANK CAPACITY 750 GALLONS 3 bedroom
1000 4 bedroom.

FOR GARBAGE GRINDER, INCREASE DISPOSAL AREA 22% & TANK CAPACITY 50%.

OTHER For 3 bedrooms. one 9 ft. dia. by 12 ft. deep dry well located 18 ft. from Hurst Rd. and 47 ft. from rear of lot. Inlet pipe 3 ft. below original grade.

or 113 sq. ft. of sidewall area below inlet per bedroom.


Septic tank - Not more than 3 feet below original grade.

PLANS APPROVED BY James E. Hennigen DATE 10/25/60

FILL SEPTIC TANK AND DISTRIBUTION BOX WITH WATER BEFORE CALLING FOR AN INSPECTION. COVER NO WORK UNTIL INSPECTED AND APPROVED.

NEITHER THE HOWARD COUNTY COMMISSIONERS NOR THE HEALTH DEPARTMENT IS RESPONSIBLE FOR THE SUCCESSFUL OPERATION OF ANY SYSTEM.

A 031022

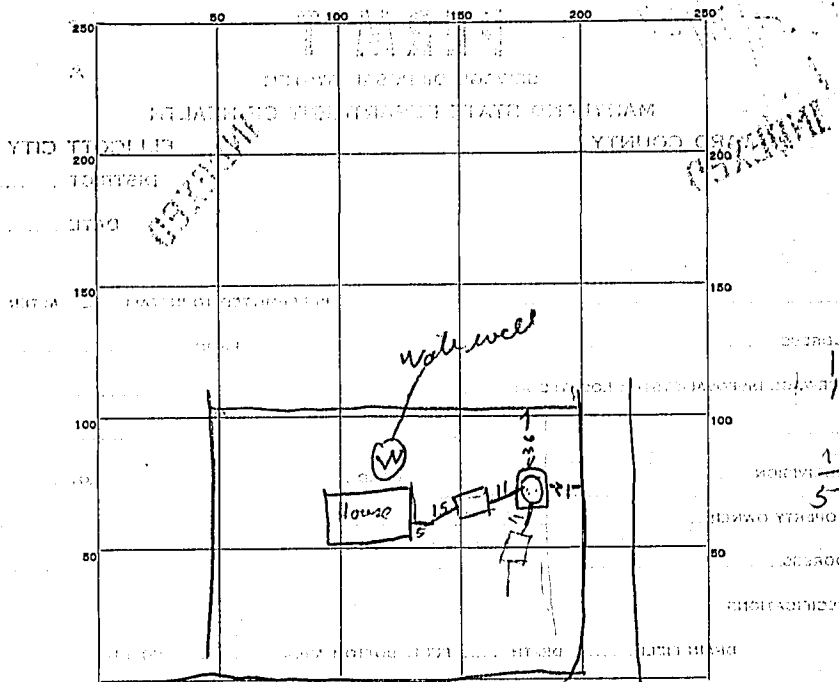

STAMPED: 11/15/67

$15 \frac{1}{2}$
 14
 $9 \frac{1}{2}$
 14
530

INDICATE NORTH - NAME ADJOINING ROADWAY AS BASE LINE.

PERMIT CARD _____

SEPTIC TANK, LEVEL OK 750 top of tank CLEANOUTS OK

DISTRIBUTION BOX, LEVEL 200

TILE FIELD, DEPTH _____ FT. TRENCH WIDTH _____ FT.

GRAVEL DEPTH _____ IN. TOTAL LENGTH _____ FT.

NUMBER OF TRENCHES _____ TOTAL BOTTOM AREA _____

SEEPAGE PITS, INSIDE DIAMETER 10 FT. DEPTH BELOW INLET 8 FT.

ABSORBENT AREA 298 SQ. FT. not counting slant

REMARKS Dry Well installed 25 ft below grade

Perimeter $14 + 9 \frac{1}{2} + 15 \frac{1}{2} = 38.7 \approx 39$ ft = 424

sq ft sidewall area counting slant

3 bedroom - 340 sq ft sidewall area requires

DATE SYSTEM APPROVED 14 June 67 INSPECTOR Raymond Hodge

113

53
8
424