

**HOWARD COUNTY
PERMIT APPLICATION**

PERMIT NUMBER
900159525

Building Address 5240 ILEX WAY
DAYTON MD 21036
Suite/Apt. #: _____ SDP/WP/Petition #: #4172
Census Tract 605101 Subdivision Kalmia Farms
Section 1 Area _____ Lot 20
Tax Map 27 Parcel 127 Grid 23
Zoning RR-DEO Map Coordinates 13DS Lot size 3.01A

Property Owner's Name JULIA + BOB STUM
Address 5240 ILEX WAY
City DAYTON State MD Zip Code 21036
Home Phone 301-854-9625 Work Phone _____
Applicant's Name & Mailing Address, (if other than stated hereon): _____
Phone _____ Fax _____

Existing Use SINGLE FAMILY DWELLING
Proposed Use 12'x46' FRONT PORCH
Estimated Construction Cost \$ 20,000.00
Description of Work POUR FOOTING, BLOCK AND
BACK, 2X10 JOISTS, TRIMBLE FLOORING
2X10 BEAM, 2X10 RAFTERS, CEILING SHANK ROOF

Contractor Company DOUSEY CUSTOM CARPENTRY INC
Contact Person JOSEPH H DOUSEY
Address 14767 JUSTIFIABLE CT
City WOODBINE State MD Zip Code 21797
License No. 68878
Phone 410-489-7636 Fax 410-489-7675

Occupant or Tenant SAME AS OWNER
Contact Name _____
Address _____
City _____ State _____ Zip Code _____
Phone _____ Fax _____

Engineer or Architect Company _____
Contact Person _____
Address _____
City _____ State _____ Zip Code _____
Phone _____ Fax _____

BUILDING DESCRIPTION - COMMERCIAL

BUILDING DESCRIPTION - RESIDENTIAL

Building Characteristics
Height: _____
No. of stories: _____
Gross area, sq. ft. per floor: _____
Use group: _____
Construction type:
____ Reinforced Concrete
____ Structural Steel
____ Masonry
____ Wood Frame
____ State Certified Modular

Utilities
Water Supply:
____ Public
____ Private
Sewage Disposal:
____ Public
____ Private
Electric Yes No
Gas Yes No
Heating System:
Electric Oil
Natural Gas
Propane Gas
Sprinkler system: N/A
____ Full
____ Partial
____ Other Suppression
____ # of Heads

Building Characteristics
SF Dwelling SF Townhouse
Depth _____ Width _____
1st floor: _____
2nd floor: _____
Basement: _____
Finished Basement Unfinished Basement
Crawl space Slab on Grade
No. of Bedrooms _____
Multi-family dwellings:
No. of efficiency units: _____
No. of 1 BR units: _____
No. of 2 BR units: _____
No. of 3 BR units: _____
Other Structure: _____
Dimensions: _____
Footings: _____
Roof: _____
State Certified Modular
 Manufactured Home 552

Utilities
Water Supply:
____ Public
 Private
Sewage Disposal:
____ Public
 Private
Electric Yes No
Gas Yes No
Heating System:
Electric Oil
Natural Gas
Propane Gas
Sprinkler system: N/A
____ NFPA #13D
____ NFPA #13R
____ Other:

THE UNDERSIGNED HEREBY CERTIFIES AND AGREES AS FOLLOWS: (1) THAT HE/SHE IS AUTHORIZED TO MAKE THIS APPLICATION; (2) THAT THE INFORMATION IS CORRECT; (3) THAT HE/SHE WILL COMPLY WITH ALL REGULATIONS OF HOWARD COUNTY WHICH ARE APPLICABLE THERETO; (4) THAT HE/SHE WILL PERFORM NO WORK ON THE ABOVE REFERENCED PROPERTY NOT SPECIFICALLY DESCRIBED IN THIS APPLICATION; (5) THAT HE/SHE GRANTS COUNTY OFFICIALS THE RIGHT TO ENTER ONTO THIS PROPERTY FOR THE PURPOSE OF INSPECTING THE WORK PERMITTED AND POSTING NOTICES.

Joseph H Dousey
Applicant's Signature
Joe DKL
Title/Company

JOSEPH H DOUSEY
Print Name
5/10/06
Date

Checks payable to: **DIRECTOR OF FINANCE OF HOWARD COUNTY**
** PLEASE WRITE NEATLY AND LEGIBLY. **
- FOR OFFICE USE ONLY -

AGENCY DATE SIGNATURE APPROVAL
Land Development, DPZ _____
State Highways _____
Building Official 5/10/06 _____
Dev. Engineering, DPZ _____
Health 5/10/06 _____
Fire Protection _____
Is Sediment Control approval required prior to issuance?
YES NO
CONTINGENCY CONSTRUCTION START:
ONE STOP SHOP:

DPZ SETBACK INFORMATION
Front: _____
Rear: _____
Side: _____
Side St.: _____
All minimum setbacks met?
YES NO
Is Entrance Permit required?
YES NO
Historic District?
YES NO
Lot Coverage for NewTown Zone _____
SDP/Red-line approval date _____

PROPERTY ID#: 69538
Filing fee \$ 25
Permit fee \$ 99
Excise tax \$ N/A
Add'l per. fee \$ 10
TOTAL FEES \$ _____
Sub-total paid \$ _____
Balance due \$ (234)
Check # 1410
Validation # 115321

Accepted by [Signature]



Distribution of Copies- White: Building Official Green: LDD, DPZ Yellow: DED, DPZ Pink: Health Gold: SHA

CONSUMER INFORMATION NOTES:

1. This plan is a benefit to a consumer insofar as it is required by a lender or a title insurance company or its agent in connection with contemplated transfer, financing or re-financing.
2. This plan is not to be relied upon for the establishment or location of fences, garages, buildings, or other existing or future improvements.
3. This plan does not provide for the accurate identification of property boundary lines, but such identification may not be required for the transfer of title or securing financing or re-financing.
4. Building line and/or Flood Zone information is taken from available sources and is subject to interpretation of originator.

Notes

1. Flood zone "C" per H.U.D. panel No. 0025B
2. Setback distances as shown to the principal structure from property lines are approximate. The level of accuracy for this drawing should be taken to be no greater than plus or minus 2 FEET.

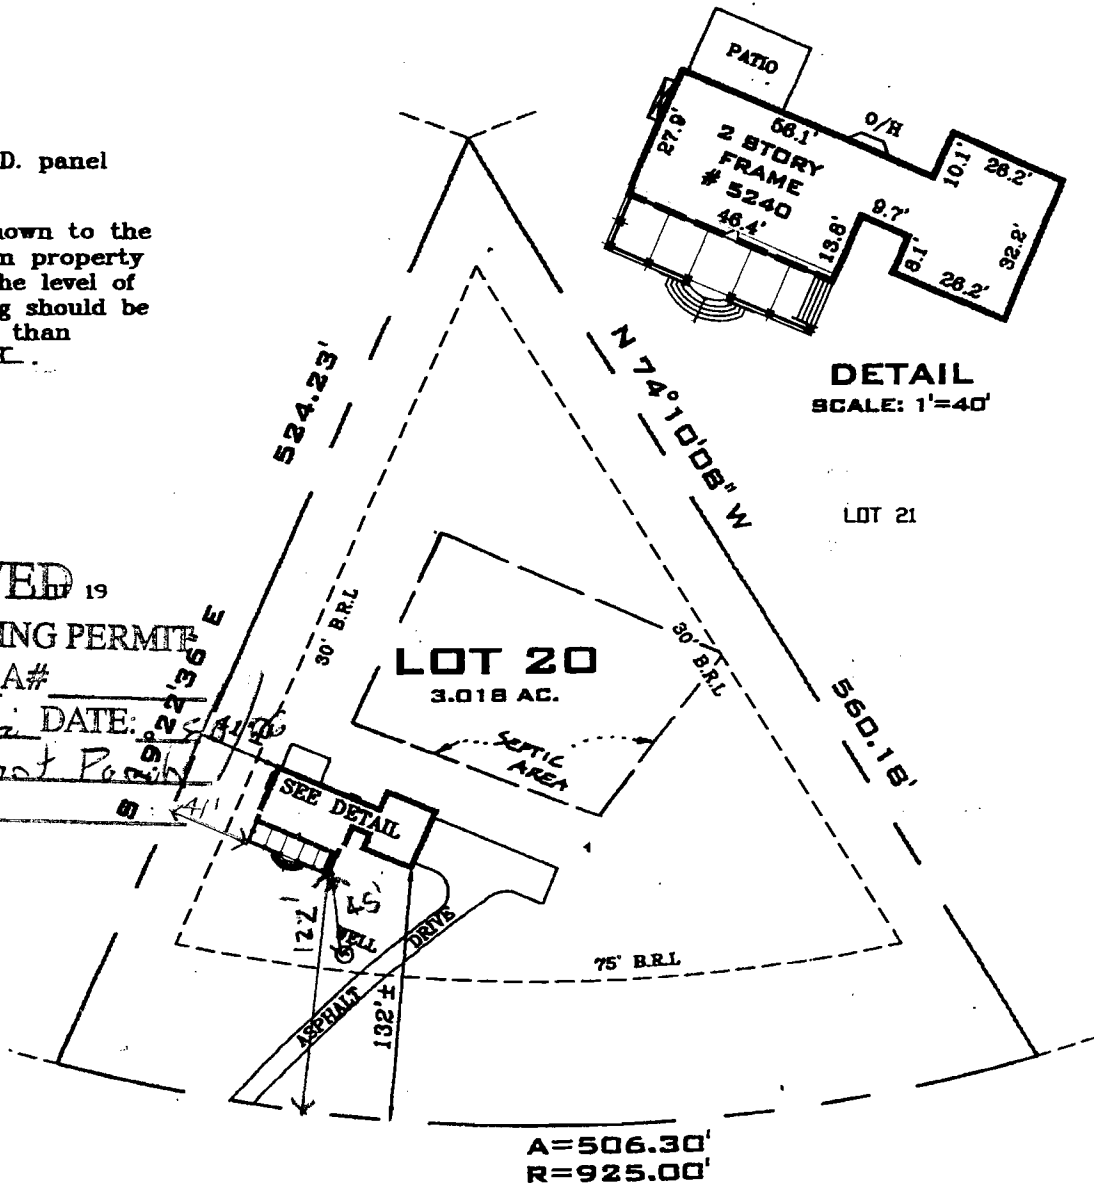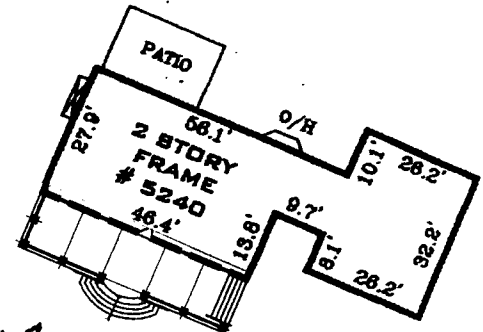

APPROVED 19
WALK-THRU BUILDING PERMIT
BE# P58504-B A#
APP. SAN M. D. Davis DATE: 02/25/06
DESC. OF WORK: Front Porch
12 ft x 46 ft.

LOCATION DRAWING
LOT 20
SHEET 4 OF 6, SECTION 1
KALMIA FARMS
HOWARD COUNTY, MARYLAND

ILEX WAY

Location Plan . Sturm Residence Porch Addition
5240 Ilex Way . Howard County, Maryland
Scale: 1"=100'-0"