

C 1 05076

SEQUENCE NO. (MDE USE ONLY)

STATE OF MARYLAND WELL COMPLETION REPORT

THIS REPORT MUST BE SUBMITTED WITHIN 45 DAYS AFTER WELL IS COMPLETED.

COUNTY NUMBER A56952-C

(THIS NUMBER IS TO BE PUNCHED IN COLS. 3-6 ON ALL CARDS)

ST/CO USE ONLY DATE RECEIVED 6-1-98

DATE WELL COMPLETED 4-6-98

Depth of Well 200 (TO NEAREST FOOT)

PERMIT NO. FROM "PERMIT TO DRILL WELL" HO-94-1488

OWNER: Glendy Manor Assoc, STREET OR RFD: Folly Quarter Rd, TOWN: Glendy, SUBDIVISION: Maisel Prop., SECTION, LOT 6

WELL LOG table with columns: DESCRIPTION, FEET (FROM, TO), check if water bearing. Includes entries for TOP SOIL, BROWN SHILL, SANDSTONE, MKD, BLUE ROUL, GOT WATER.

GROUTING RECORD form with fields for WELL HAS BEEN GROUTED, TYPE OF GROUTING MATERIAL (CEMENT, BENTONITE CLAY), NO. OF BAGS, NO. OF POUNDS, GALLONS OF WATER, DEPTH OF GROUT SEAL.

CASING RECORD form with fields for casing types (STEEL, CONCRETE, PLASTIC, OTHER), MAIN CASING TYPE, Nominal diameter, Total depth.

OTHER CASING (if used) form with fields for diameter, depth.


SCREEN RECORD form with fields for screen type or open hole (STEEL, BRASS, BRONZE, PLASTIC, OPEN HOLE, OTHER).

DEPTH (nearest ft.) table with columns for depth intervals (1-2, 3-4, 5-6, 7-8, 77-78, 79-80).

GRAVEL PACK IF WELL DRILLED WAS FLOWING WELL, MDE USE ONLY (NOT TO BE FILLED IN BY DRILLER), TELESCOPE CASING, LOG INDICATOR, OTHER DATA.

PUMPING TEST form with fields for HOURS PUMPED, PUMPING RATE, METHOD USED TO MEASURE PUMPING RATE, WATER LEVEL (BEFORE PUMPING, WHEN PUMPING), TYPE OF PUMP USED.

PUMP INSTALLED form with fields for DRILLER WILL INSTALL PUMP, TYPE OF PUMP INSTALLED, CAPACITY, PUMP COLUMN, CASING HEIGHT, LAND SURFACE.

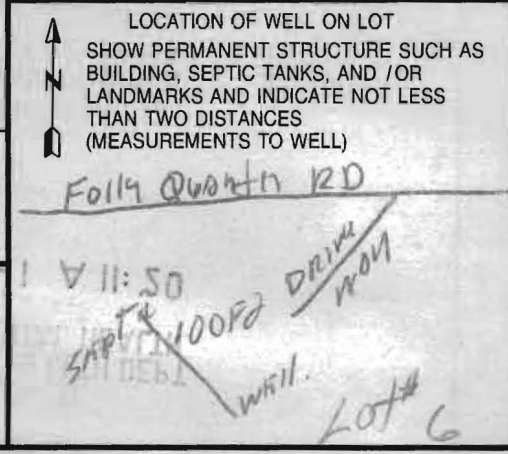

NUMBER OF UNSUCCESSFUL WELLS: 0, WELL HYDROFRACTURED: YES/NO

CIRCLE APPROPRIATE LETTER: A (WELL ABANDONED AND SEALED), E (ELECTRIC LOG OBTAINED), P (TEST WELL CONVERTED TO PRODUCTION WELL)

I HEREBY CERTIFY THAT THIS WELL HAS BEEN CONSTRUCTED IN ACCORDANCE WITH COMAR 26.04.04 "WELL CONSTRUCTION" AND IN CONFORMANCE WITH ALL CONDITIONS STATED IN THE ABOVE CAPTIONED PERMIT...

DRILLERS LIC. NO.: M S D 143, DRILLERS SIGNATURE: Perry Hardy, LIC. NO.: M D

SITE SUPERVISOR (sign. of driller or journeyman responsible for sitework if different from permittee)

B 1 **3068** SEQUENCE NO. (DP USE ONLY)
 (THIS NUMBER IS TO BE PUNCHED IN COLS. 3-6 ON ALL CARDS)

STATE OF MARYLAND
 APPLICATION FOR PERMIT TO DRILL WELL
 please print or type

STATE PERMIT NUMBER
40-94-1488
 70 fill in this form completely 79

OWNER INFORMATION
 Date Received (APA) [] [] [] [] [] []
 8 13
 15 Last Name **Gene G** Owner **Harley** First Name **Assoc** 34
 36 Street or RFD **12789 F0114 CHARLTON** 55
 57 Town **FAIRFAX** City **MD** 70 State **21** Zip **047** 75

B 3 LOCATION OF WELL
 1 2
 8 COUNTY **HOWARD** 21
 23 SUBDIVISION **MAISEI PROPERTY** 42
 SECTION [] [] 44 46 LOT **06** 48 50
 52 NEAREST TOWN **CHARLESVILLE** 71
 MILES FROM TOWN (enter 0 if in town) **4** 73 **M I** 76 77 78

DRILLER INFORMATION (MSD) MGD/MWD
 Driller's Name **Derry Harley** 77 License No. **0743** 80
 Firm Name **Box 160 HARLEY DRILLING**
 Address **Box 160 WALKERSVILLE, MD**
 Signature **Derry Harley** Date **3-6-98** 21042

B 4 DIRECTION OF WELL FROM TOWN (CIRCLE BOX)
 1 2
 11 NEAR WHAT ROAD **Folly Quarter** 30
 ON WHICH SIDE OF ROAD (CIRCLE APPROPRIATE BOX)
 NORTH [] WEST [] EAST [] SOUTH []
 34 DISTANCE FROM ROAD **1000** 37
 ENTER FT OR MI **FT** 38 39
 TAX MAP: _____ BLK: _____ PARCEL: _____

B 2 WELL INFORMATION
 1 2
 APPROX. PUMPING RATE (GAL. PER MIN.) **3** 8 12
 AVERAGE DAILY QUANTITY NEEDED (GAL. PER DAY) **600** 14 20

USE FOR WATER (CIRCLE APPROPRIATE BOX)
 HOME (SINGLE OR DOUBLE HOUSEHOLD UNIT ONLY)
 FARMING (LIVESTOCK WATERING & AGRICULTURAL IRRIGATION)
 INDUSTRIAL, COMMERCIAL, STATE AND FEDERAL GOV. OTHER (REQUIRES APPROPRIATION PERMIT)
 PUBLIC OR PRIVATE WATER COMPANY (REQUIRES APPROPRIATION PERMIT AND STATE HEALTH DEPARTMENT APPROVAL)
 TEST, OBSERVATION, MONITORING (MAY REQUIRE APPROPRIATION PERMIT)

NOT TO BE FILLED IN BY DRILLER HEALTH DEPARTMENT APPROVAL
 COUNTY NAME **Howard Co** COUNTY NO. **A56952-C**
 STATE SIGNATURE _____ INSERT S _____ 41
 DATE ISSUED **03/17/98** CO SIGNATURE **A McMeel** EXP. DATE **3/17/99**
 43 NORTH GRID **510000** 55 EAST GRID **0810000** 57 63

APPROXIMATE DEPTH OF WELL **300** 24 28 FEET

APPROXIMATE DIAMETER OF WELL **6"** NEAREST INCH

METHOD OF DRILLING (circle one)
 BORED (or Augered) JETTED Jetted & DRIVEN
 30 AIR-ROTARY AIR-PERCussion ROTARY (Hydraulic Rotary)
 37 CABLE REVerse-ROTARY DRive-POINT
 other _____

SHOW MAJOR FEATURES OF BOX & LOCATE WELL WITH AN X
 SOURCES OF DRILLING WATER
 1. **WELL**
 2.
 3.
 WRITE THE BOX NUMBER FROM THE MAP HERE
 E **1810**
 N **510**
 000
 000
 4/6/98 12:00g
 Folly Quarter Rb
 Just started @ time of insp.
 ALM

REPLACEMENT OR DEEPEMED WELLS (CIRCLE APPROPRIATE BOX)
 THIS WELL WILL NOT REPLACE AN EXISTING WELL
 THIS WELL WILL REPLACE A WELL THAT WILL BE ABANDONED AND SEALED
 39 THIS WELL WILL REPLACE A WELL THAT WILL BE USED AS A STANDBY-CONTACT LOCAL APPROVING AUTHORITY FOR POLICY ON STANDBY WELLS
 THIS WELL WILL DEEPEM AN EXISTING WELL
 PERMIT NUMBER OF WELL TO BE REPLACED OR DEEPEMED (IF AVAILABLE) 41 [] [] [] [] [] [] [] [] [] [] 52

DRAW A SKETCH BELOW SHOWING LOCATION OF WELL IN RELATION TO NEARBY TOWNS AND ROADS AND GIVE DISTANCE FROM WELL TO NEAREST ROAD JUNCTION
 N
 Folly Quarter Rb
 Drilling
 Lot # 7

Not to be filled in by driller (OEP USE ONLY)
 APPROP. PERMIT NUMBER [] [] [] [] [] [] [] [] [] [] 54 63
 FORCE **AV** WRITE INITIALS IN BOX PERMIT No. **40-94-1488** 70 71 72 73 74 75 76 77 78 79

SPECIAL CONDITIONS
 NOTE = APPROVING AUTHORITIES SHOULD USE SEPARATE SHEET IF NEEDED =
 COUNTY


22.41"E 136.72'

NON-BUILDABLE
PRESERVATION PARCEL A
TO BE DEDICATED TO H.O.A.

EXISTING
ALUMINUM
BUILDING

CONCRETE
SILOS

PROP. TREELINE

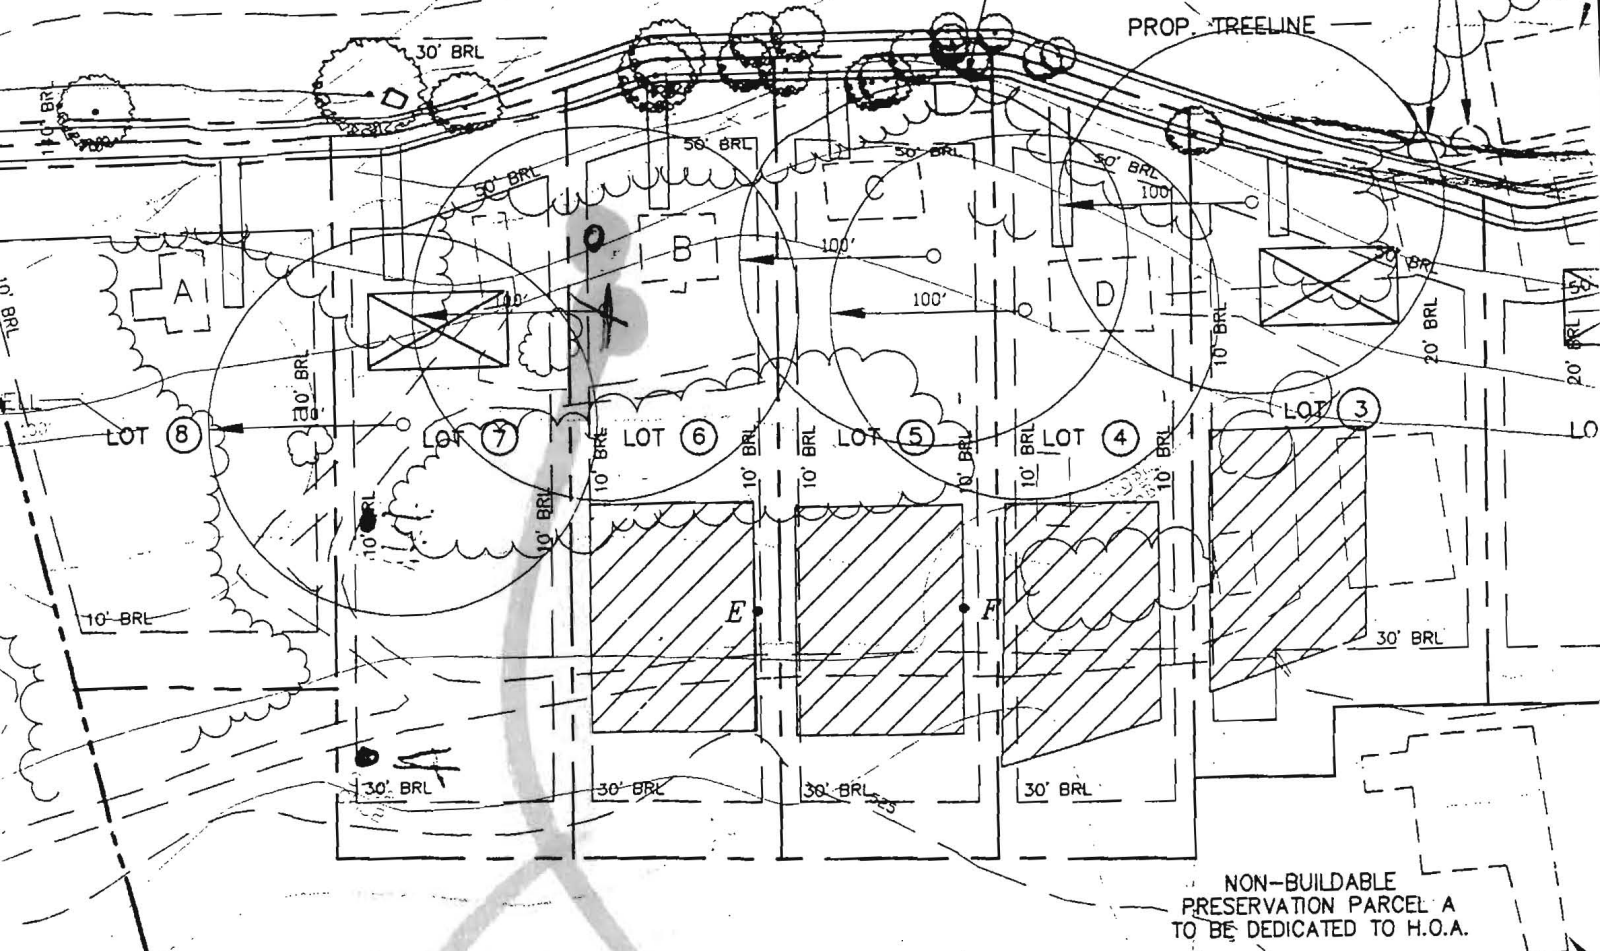

NON-BUILDABLE
PRESERVATION PARCEL A
TO BE DEDICATED TO H.O.A.

N37°06'44"E

675.63'

EX. HOUSE

*3/17/98
well site OK
as stated
A*

Ch12
ChB2

C5B2
C5C2

500