


Scale 1" = 50 feet

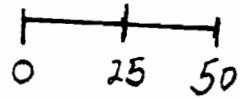

**APPROVED**

WALK-THRU BUILDING PERMIT


BP# B00158898A# 10005

APP. SAN SF DATE: 4/4/06

DESC. OF WORK:

40 x 16' inground pool

(P14345)

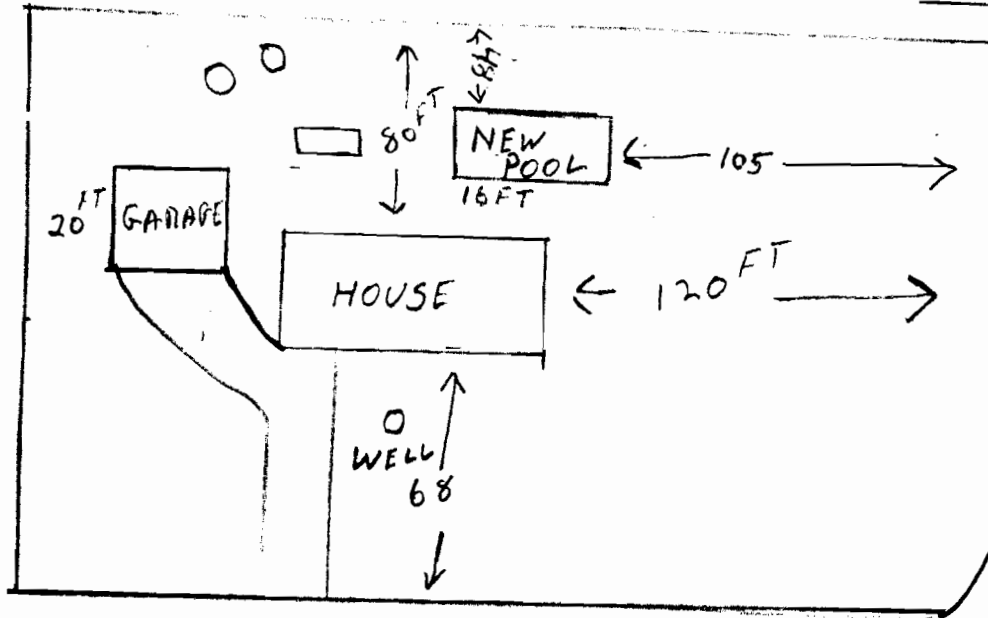

12570 Indian Hill Dr  
Sykesville, MD 21784