

# APPLICATION

A 13070

SEWAGE DISPOSAL TESTING

P. \_\_\_\_\_

MARYLAND STATE DEPARTMENT OF HEALTH

HOWARD COUNTY

ELLICOTT CITY

Septic Tank - 3 bedrooms - 750 gal.  
4 " " - 1000 gal.DISTRICT 3DATE 9/6/67

Dry Well - 100 sq. ft. adjacent sidewalk and per bedroom  
& begin below inlet pipe. Max depth permitted for Dry Well below orig. grade is  
12 ft.

Place Dry Well - 3 ft. from front lot line, 21 ft. from right sidewalk as shown  
when facing lot from ~~West~~ Ioka Ct.

TO: THE COUNTY HEALTH OFFICER  
ELLCOTT CITY, MARYLANDI, HEREBY, APPLY FOR THE NECESSARY TESTS IN ORDER TO CONSTRUCT (OR RECONSTRUCT) A SEWAGE  
DISPOSAL SYSTEM.PROPERTY OWNER Woodmark, Inc. - M. A. WakefieldADDRESS 231 Chatham Rd. PHONE \_\_\_\_\_

PROPERTY LOCATION: \_\_\_\_\_

SUBDIVISION Woodmark, Inc. LOT NO. 54, Blk. E, Sec. 3ROAD AND DESCRIPTION Court I

OCCUPANT: \_\_\_\_\_ PHONE \_\_\_\_\_

PERSON TO CONSTRUCT SYSTEM \_\_\_\_\_

ADDRESS \_\_\_\_\_ PHONE \_\_\_\_\_

SIZE OF LOT 110' x 48' x 74' x 275' x 60' x 185' x 135' TYPE BLDG. 3 or 4  
NUMBER OF BEDROOMS


IF NOT SINGLE RESIDENCE DESCRIBE \_\_\_\_\_

SIGNATURE OF APPLICANT /s/ M. A. WakefieldAPPROVED BY [Signature] FOR Dry Well DATE 9/14/68  
(KIND OF SYSTEM)REJECTED BY \_\_\_\_\_ FOR \_\_\_\_\_ DATE \_\_\_\_\_  
(KIND OF SYSTEM)

HOLD PENDING FURTHER TESTS \_\_\_\_\_ DATE \_\_\_\_\_

REASONS FOR REJECTION OR HOLDING \_\_\_\_\_

## THIS IS NOT A PERMIT

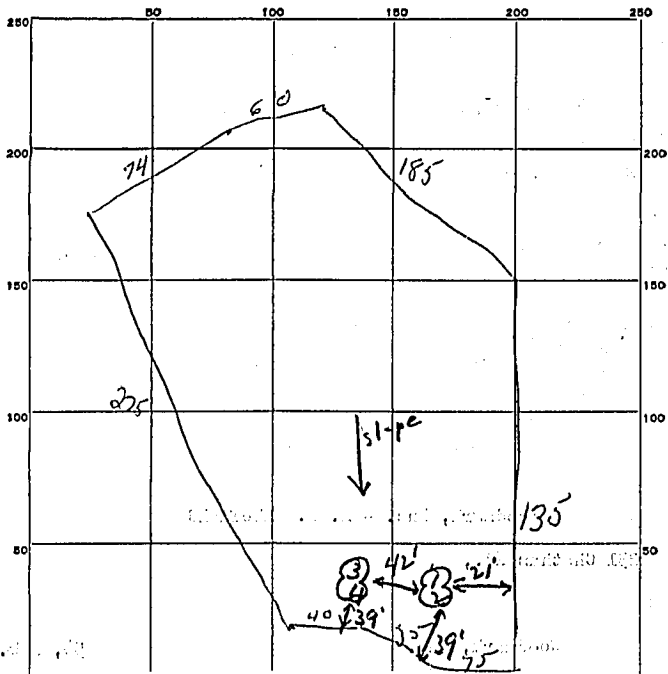

INDICATE NORTH. - NAME ADJOINING ROADWAY AS BASE LINE.

Count I

DATE	TEST NO.	DEPTH	PRE-WET		TEST - 1" DROP		TIME
			START	STOP	START	STOP	
9/7/67	1	4'	1:42	1:44	1:44	1:46	2 min
	2	10'	1:42	1:45	1:45	1:48	3 min
	3	6'	1:44	Overtime			
	4	10"	1:44	1:45	1:45	1:46	1 min

SOIL AUGER FINDING \_\_\_\_\_

TESTED BY AHK + DM

REMARKS \_\_\_\_\_

54E 2003