

APPLICATION

A 23968

SEWAGE DISPOSAL TESTING

P _____

STATE OF MARYLAND - DEPARTMENT OF HEALTH AND MENTAL HYGIENE

HOWARD COUNTY HEALTH DEPARTMENT
ENVIRONMENTAL HEALTH SERVICES
P. O. BOX 476, ELLICOTT CITY, MARYLAND 21043
TELEPHONE: 465-5000, EXT. 356

DISTRICT Fifth

DATE 9/16/76

TO: THE COUNTY HEALTH OFFICER
ELLICOTT CITY, MARYLAND

I, HEREBY, APPLY FOR THE NECESSARY TEST IN ORDER TO CONSTRUCT (OR RECONSTRUCT) A SEWAGE DISPOSAL SYSTEM.

PROPERTY OWNER Mr. Walter Bucher

ADDRESS Highland Partnership
8777 First Avenue PHONE (8)-588-3100
Silver Spring, MD 20901

PROPERTY LOCATION:
SUBDIVISION Highland Lake LOT NO. 10 [#] 10 New
on reversed plot

ROAD AND DESCRIPTION Isle of Skye Drive and Blackwatch Court

SIZE OF LOT one acre m/1 TYPE BLDG. 3 or 4 bedroom
NUMBER OF BEDROOMS

IF NOT SINGLE RESIDENCE DESCRIBE _____

THE SYSTEM INSTALLED UNDER THIS APPLICATION IS ACCEPTABLE ONLY UNTIL PUBLIC FACILITIES BECOME AVAILABLE.

SIGNATURE OF APPLICANT /s/ Mr. Walter Bucher

APPROVED BY _____ FOR _____ DATE _____
(KIND OF SYSTEM)


REJECTED BY _____ FOR _____ DATE _____
(KIND OF SYSTEM)

HOLD PENDING FURTHER TESTS _____ DATE _____

REASONS FOR REJECTION OR HOLDING 6/18/76 hold # 10

THIS IS NOT A PERMIT

A23968

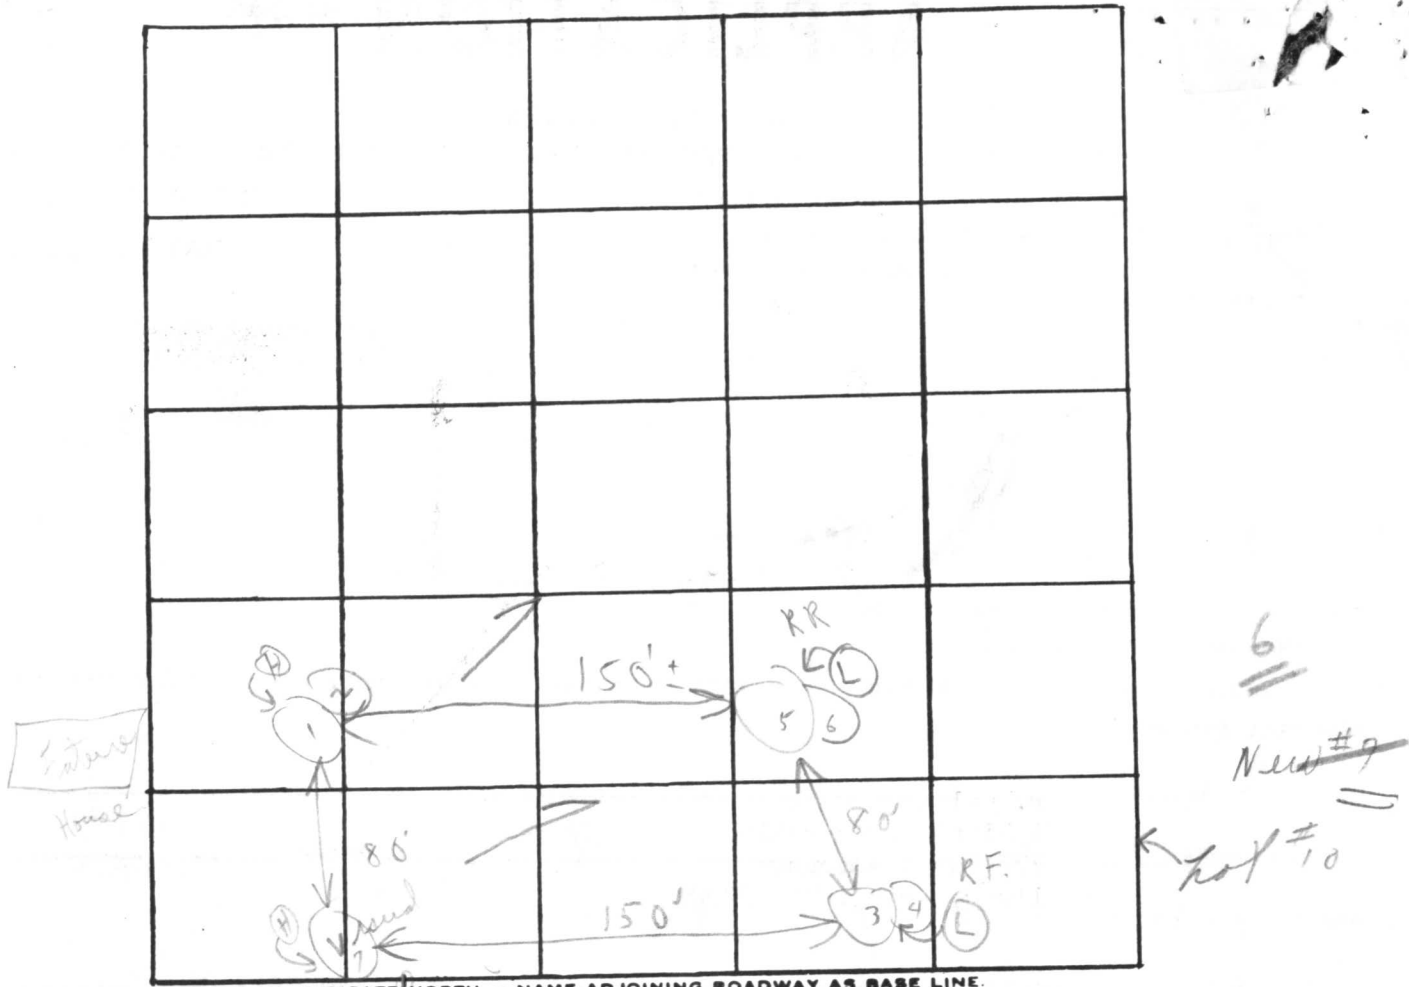

INDICATE NORTH. - NAME ADJOINING ROADWAY AS BASE LINE.

orientation of dyke

Soil Profile	DATE	TEST NO.	DEPTH	PRE-WET		TEST - 1" DROP		TIME
				START	STOP	START	STOP	
1'-3' clay	4/18/76	1	3' s	1:58	2:00	2:00	2:04	4 min
↓ 9 1/2' loam		Ⓚ 2	12' d	1:58	2:00	2:00	2:04	4 min
1'-5' clay		3	5' s	1:26	1:27	1:27	1:39	12 min
↓ 7' loam		Ⓚ 4	12' d	1:26	1:27	1:27	1:35	8 min
1'-4 1/2' clay		5	4'-4 1/2' s	1:43	1:45	1:45	1:55	10 min
↓ 7 1/2' loam		Ⓚ 6	12' d	1:43	1:45	1:45	1:49	4 min
		H-7		Visual		1 1/4' clay	4-12' 8' loam	7 min
							6:42	
							New 10	see new plot

REMARKS

Heavily wooded Field locate Dordford

TYPE OF SOIL

Sandy loam below clay

TESTED BY

C.B.D.

ALSO PRESENT:

Kettner