

2/3/81 FILE COMPLETE

PERMIT

P 30832

A 25687

SEWAGE DISPOSAL SYSTEM

MARYLAND STATE DEPARTMENT OF HEALTH

HOWARD COUNTY

03-300188

ELLICOTT CITY

DISTRICT 3rd.

DATE 8/11/80

INDEXED

2/3/81
as soon as possible

Souder Builders, Inc. IS PERMITTED TO INSTALL ALTER

ADDRESS 9335 Old Acaggsville Road, Laurel, Md. PHONE 725-5772

SUBDIVISION _____ ROAD 3705 Ivory Road

PROPERTY OWNER Donald Souder

ADDRESS Same as above

SPECIFICATIONS 4 Bedrooms

SEPTIC TANK CAPACITY 1250 GALLONS

DRAIN FIELD _____ DEPTH _____ FEET, BOTTOM AREA _____ SQ. FT.

DEEP TRENCH _____ DEPTH _____ FEET, BOTTOM AREA _____ SQ. FT.

Dry Well SEEPAGE PITS ABSORBENT SIDE-WALL AREA 120 SQ. FT. per bedroom

INLET PIPE 4 FT. BELOW ORIGINAL GRADE. MAXIMUM DEPTH 12 FT. BELOW ORIGINAL GRADE

EFFECTIVE DEPTH AT _____ FT. BELOW ORIGINAL GRADE.

LOCATE DISPOSAL AREA 175 FT. FROM Front LOT LINE AND 25 FT. FROM Left LOT LINE AS SEEN WHEN

FACING LOT FROM Ivory Road

Howard County Health Department
Bureau of Environmental Health
**BLDG. PERMIT SIGNED
AND RETURNED**
7/21/80 600155140 - POLE BARN

NOTE: OKAY TO USE TRENCH ~~OR~~ DRY WELL TO MAKE UP ABSORBENT SIDEWALL AREA IN SYSTEM.
LEAVE 5 FT. EARTH BUFFER BETWEEN TRENCH AND DRY WELL. TRENCH TO FOLLOW CONTOUR OF THE LAND.

CALL FOR TWO INSPECTION - BEFORE AND AFTER STONE IS IN.

PLANS APPROVED BY Raymond Hodges DATE 12/5/77

COVER NO WORK UNTIL INSPECTED AND APPROVED.

NEITHER THE HOWARD COUNTY COUNCIL NOR THE HEALTH DEPARTMENT IS RESPONSIBLE FOR THE SUCCESSFUL OPERATION OF ANY SYSTEM.

NOTE: IF TRENCH IS USED CALL FOR INSPECTION BEFORE PLACING GRAVEL IN TRENCH.

NOTE: NO DRY WELL SHALL EXCEED 15 FOOT IN DIAMETER.

NOTE: ALL PIPE FROM HOUSE TO DISPOSAL AREA MUST BE CAST IRON.

PERMIT VOID AFTER THREE YEARS.

NOTE: INSTALL STAND PIPE ON SEPTIC TANK AND DRY WELL. STAND PIPES MUST BE 6 INCHES IN DIAMETER. CAST IRON, CONCRETE OR TERRA COTTA ACCEPTED.


***INSTALLER IS RESPONSIBLE FOR OBTAINING FINAL APPROVAL ON THIS PERMIT.**

BLDG. PERMIT SIGNED
AND RETURNED 8/12/80
Serial # 44069

A 25687

Blgd permit OK
5/7/82 JS

BLDG. PERMIT SIGNED
AND RETURNED 5/10/82
Serial # 49446
Prot.

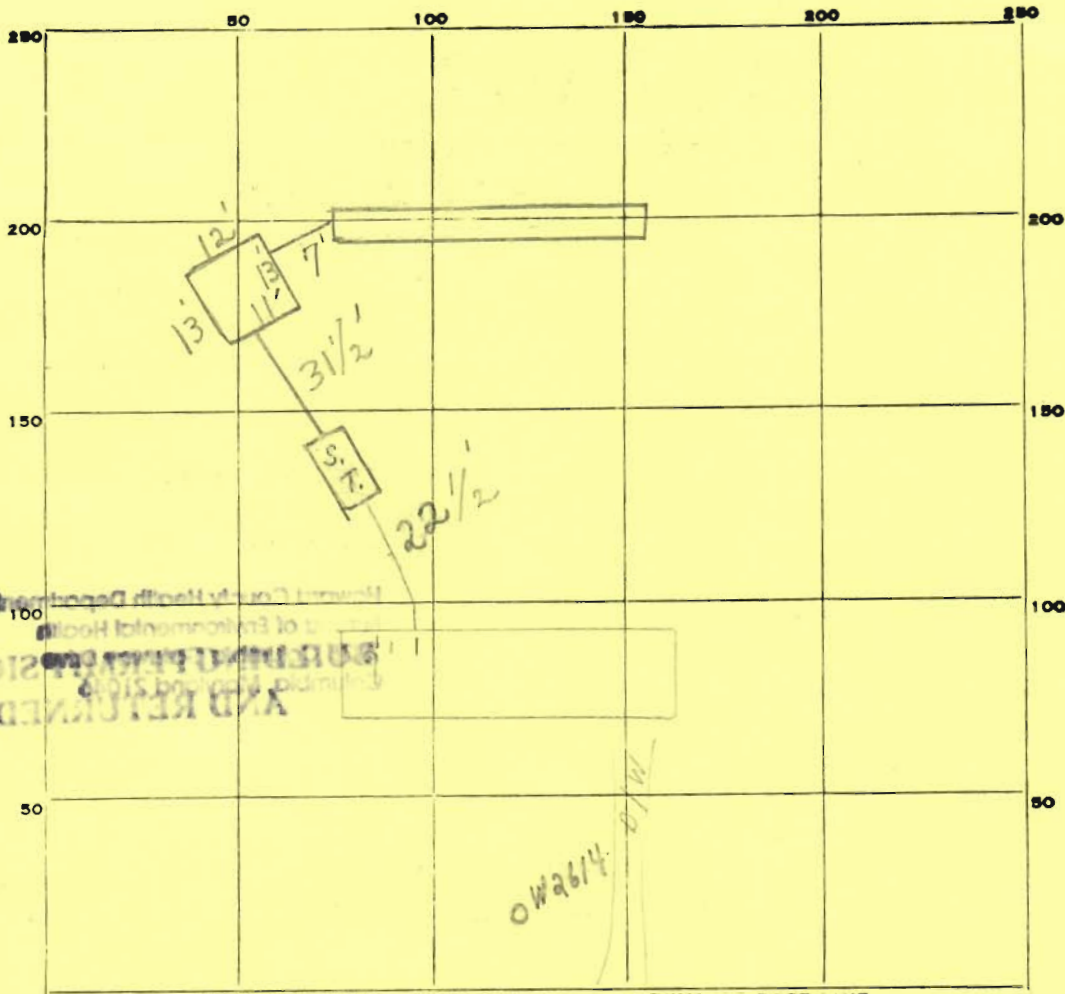

INDICATE NORTH. - NAME ADJOINING ROADWAY AS BASE LINE.

IVORY ROAD

PERMIT CARD

S.T. | D.W.

SEPTIC TANK, LEVEL

CLEANOUTS

DISTRIBUTION BOX, LEVEL _____

TILE FIELD, DEPTH 11 1/2 - 12 FT. TRENCH WIDTH 2 FT.

GRAVEL DEPTH 8 IN. TOTAL LENGTH 18 FT. 14 4'

NUMBER OF TRENCHES 1 TOTAL BOTTOM AREA _____

SEEPAGE PITS, INSIDE DIAMETER 49 FT. DEPTH BELOW INLET 8 FT. 392'

ABSORBENT AREA 536 SQ. FT.

REMARKS AM. 2/3/81 CHECKED TRENCH ONLY - OK FOR STOVE

PM. 2/3/81 SYSTEM COMPLETE. C.B.D.

DATE SYSTEM APPROVED 2/3/81

INSPECTOR C.B. Stueck