

3/24/69
Handwritten initials

PERMIT

P 14364
A 13994

SEWAGE DISPOSAL SYSTEM

MARYLAND STATE DEPARTMENT OF HEALTH

HOWARD COUNTY

ELLICOTT CITY

INDEXED

DISTRICT 4

DATE 3/24/69

Hubert E. Snapp IS PERMITTED TO INSTALL ALTER

ADDRESS 25641 Ridge Road, Damascus, Maryland PHONE 253-2857

A SEWAGE DISPOSAL SYSTEM LOCATED AT _____

SUBDIVISION _____ ROAD Daisy Rd. LOT _____
(see application for better directions)

PROPERTY OWNER Joshua L. Chrobot

ADDRESS Daisy Rd., Woodbine, Md.

SPECIFICATIONS - 2 bedrooms

DRAIN FIELD _____ DEPTH _____ FEET, BOTTOM AREA _____ SQ. FT.

SEEPAGE PITS _____ ABSORBENT, SIDE-WALL AREA _____ SQ. FT.

SEPTIC TANK CAPACITY 1,250 GALLONS

FOR GARBAGE GRINDER, INCREASE DISPOSAL AREA 22% & TANK CAPACITY 50%.

OTHER Dry well - 376 sq. ft. absorbent sidewall area to begin below the inlet pipe. Dry well to be located 37 ft. from the right side line and 300 ft. from the front property line as seen from Jennings Chapel Road. Maximum depth permitted from original grade is 11 ft.

NOTE: ALL PIPE FROM HOUSE TO SEPTIC TANK MUST BE CAST IRON.
PERMIT VOID AFTER THREE YEARS.

PLANS APPROVED BY Robert Torre DATE 10/11/68

FILL SEPTIC TANK AND DISTRIBUTION BOX WITH WATER BEFORE CALLING FOR AN INSPECTION. COVER NO WORK UNTIL INSPECTED AND APPROVED.

NEITHER THE HOWARD COUNTY COMMISSIONERS NOR THE HEALTH DEPARTMENT IS RESPONSIBLE FOR THE SUCCESSFUL OPERATION OF ANY SYSTEM.


NOTIFY THE HEALTH DEPARTMENT 48 HOURS BEFORE EXCAVATIONS ARE TO BE BACK FILLED.

Handwritten number: 13994

ADSL

W. H. A. G. H. S. E.

ADSL A

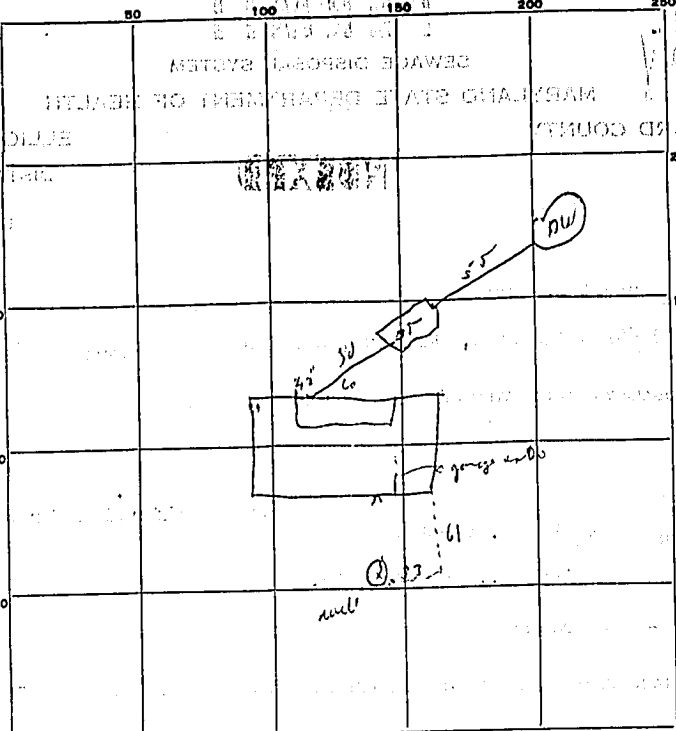

60
3
56
36

5.10
12
94.2
314
4.08 2

INDICATE NORTH. - NAME ADJOINING ROADWAY AS BASE LINE.

Jennings Chapel Rd

PERMIT CARD OK

SEPTIC TANK, LEVEL OK

CLEANOUTS marked

DISTRIBUTION BOX, LEVEL _____

TILE FIELD, DEPTH _____ FT. TRENCH WIDTH _____ FT.

GRAVEL DEPTH _____ IN. TOTAL LENGTH _____ FT.

NUMBER OF TRENCHES _____ TOTAL BOTTOM AREA _____

SEEPAGE PITS, INSIDE DIAMETER 17 FT. DEPTH BELOW INLET 10 FT.

ABSORBENT AREA 408 SQ. FT.

REMARKS _____

DATE SYSTEM APPROVED 2/26/69 INSPECTOR [Signature]