

**THIS REPORT
MUST BE SUBMITTED
WITHIN 30 DAYS
AFTER COMPLETION
OF THE WELL**

WELL COMPLETION REPORT RECEIVED

WELL DESCRIPTION

A WELL LOG
State the kind of formations penetrated, their color, their depth, their thickness, and if water-bearing

B) CASING AND SCREEN RECORD
State the kind and size and position of casing, liner, shoe, screen, and other accessories (if no casing used, give diameter of well).

FEET from 1 to	WATER	DIAM. (inches)	FEET from 1 to
0-3	top soil	6 1/2	0-109
3-100	sandy		
100-140	gray rock		
	water 60&115		
	steel		

Permit Number H0660083
Owner Joshua Orbat
Address Woodhime Md.
Subdivision _____
Section _____ Lot _____
County Permit Number _____
PUMPING TEST
Hours Pumped 3
Type of Pump Used air
Pumping Rate _____
Gallons per Minute 50


WATER LEVEL
(Distance from land surface to water)
Before Pumping 40 Ft.
When Pumping 140 Ft.

APPEARANCE OF WATER
Clear _____ Cloudy _____
Taste _____
Odor _____

Height of Casing Above Land
Surface 2 Ft.

PUMP INSTALLED
Type _____
Capacity
Gallons per Minute _____
Gallons per Hour _____
Pump Column Length _____ Ft.

LOCATION OF WELL ON LOT
Show permanent structures such as building(s), septic tank, and/or other landmarks and indicate not less than 2 distances (measurements) to well.

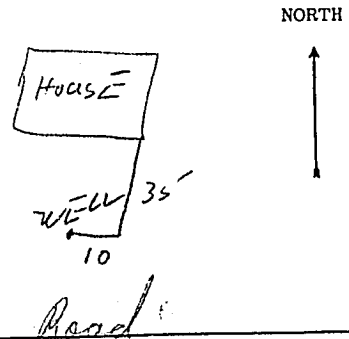

DATE WELL WAS COMPLETED

I hereby affirm that this report contains no willful misrepresentations or falsifications and that information given in this report is true, accurate and complete to the best of my knowledge and belief.

P. F. Esterday, Well Driller

88t 31.

Well Driller License No.: 70