

COUNTY #

SOIL PROFILE
828 827

red
brn
SiClm

4.0

orange
beigh
SSL

15%
shale

3.0

824 822
825 817


orange
brn
SiLm

2.5


lgt
orange
SSL

horizontal
saprolite
15%

1.5

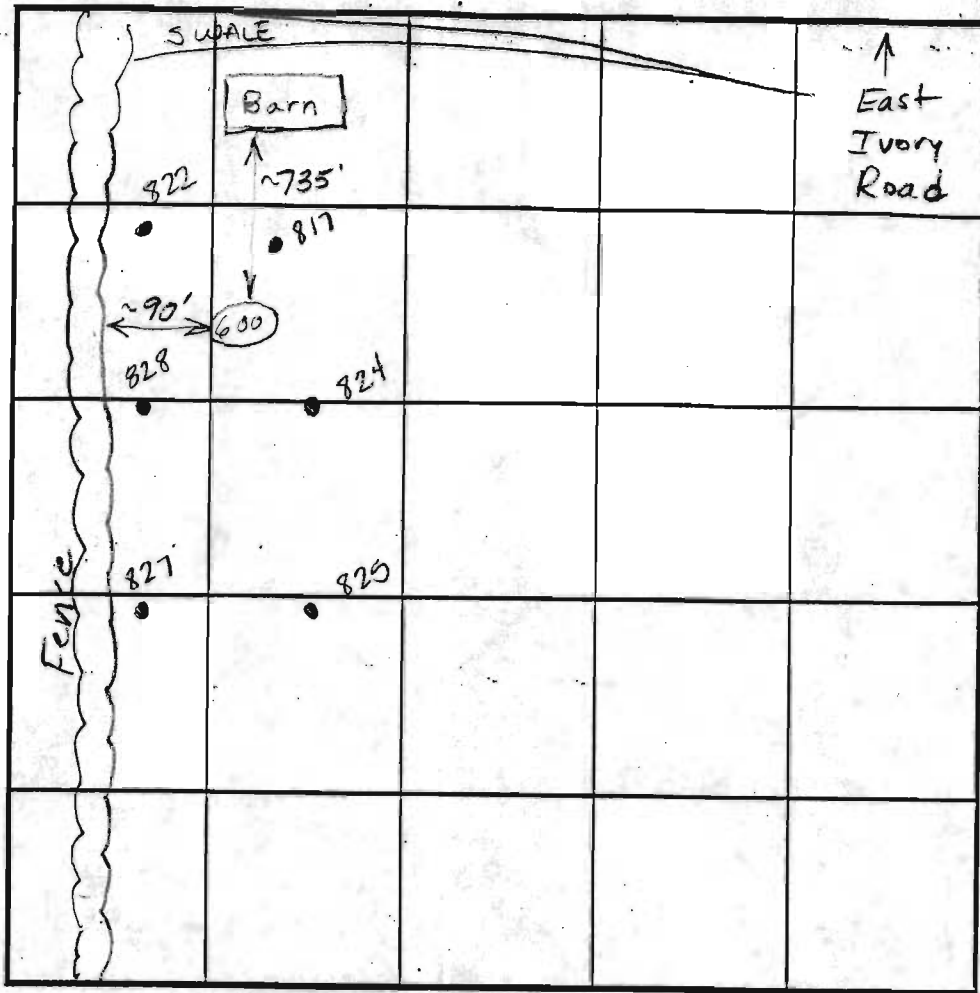

SOIL PROFILE

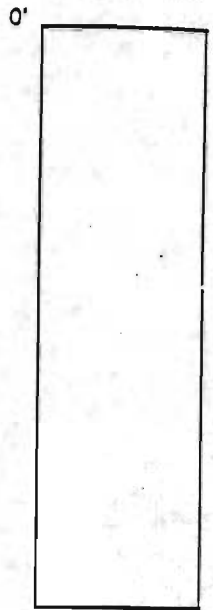

INDICATE NORTH - NAME ADJOINING ROADWAY AS BASE LINE.

DATE	TEST NO.	DEPTH	PRE-WET		TEST - 1" DROP		TIME
			START	STOP	START	STOP	
6-1-01	828	4.0 V13.0	10:22	10:23	10:23	10:25	2min
	827	3.5 V14.5	10:25	10:26	10:26	10:27	1min
	825	3.0 V13.5	10:30	10:31	10:31	10:32	1min
	824	4.0 V13.0	10:32	10:35	10:35	10:38	3min
	817	3.5 V13.5	10:39	10:40	10:40	10:42	2min
	822	4.0 V14.0	10:41	10:43	10:43	10:45	2min

REMARKS _____

TYPE OF SOIL _____

TESTED BY Amy McMillen

ALSO PRESENT _____

TRENCH DESIGN DATA: AVERAGE PERCOLATION TIME _____

TRENCH WIDTH _____

INLET DEPTH _____

MAXIMUM BOTTOM DEPTH _____

SQ. FT./BEDROOM _____

all ok
HP

COUNTY #

SOIL PROFILE

(600)

Topsoil and Red Br Loam 20"

Light Br Sa Loam ~20% Rock

Pocket of ~25-30% Rock from 6'-8'

20"

13.5'

(628)

Red Br Heavy Loam and Topsoil 1.5'-3'

1.5'-3'


Med Br Sa Loam ~5% Rock 14'

14'

(628)

Red Br Heavy Loam and Topsoil 1.5'-3'

1.5'-3'

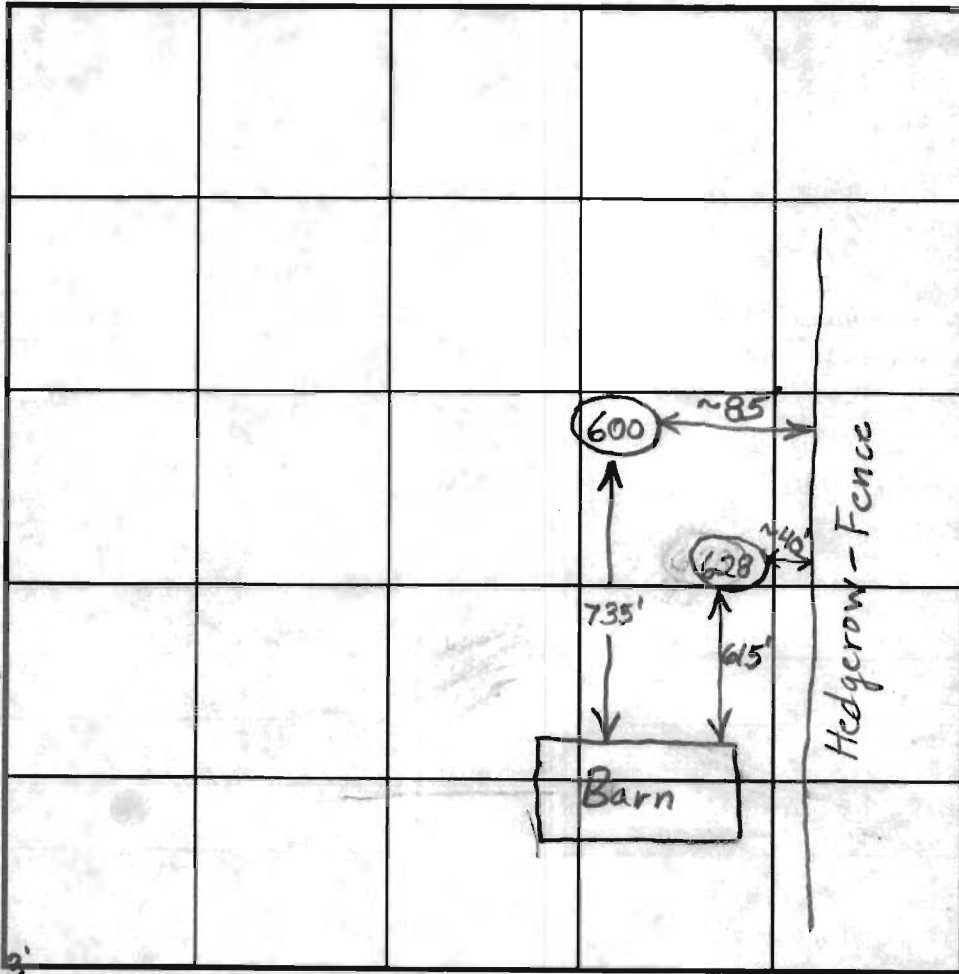

SOIL PROFILE

0'



INDICATE NORTH - NAME ADJOINING ROADWAY AS BASE LINE.

Ivory Road East

DATE	TEST NO.	DEPTH	PRE-WET		TEST - 1" DROP		TIME	
			START	STOP	START	STOP		
4/30/02	600	3.5/13.5'	9:18:30	9:19:30	9:19:30	9:21	1 1/2	OK
5/23/02	628	3'/14'	2:04	2:04:45	2:04:45	2:06:20	~1 1/2	OK
Holes Done with Post Hole Digger								

REMARKS _____

TYPE OF SOIL _____

TESTED BY _____ ALSO PRESENT _____

TRENCH DESIGN DATA: AVERAGE PERCOLATION TIME _____ TRENCH WIDTH _____

INLET DEPTH _____ MAXIMUM BOTTOM DEPTH _____ SQ. FT./BEDROOM _____