


PROPERTY KNOWN AS: Lot 12
Hallmark
Section One
Lot 1 Thru Lot
5th Election District
Howard County, Maryland
Plat No. 3865

THIS PLAT CAN NOT BE USED TO ESTABLISH
PROPERTY LINES OR CORNERS.

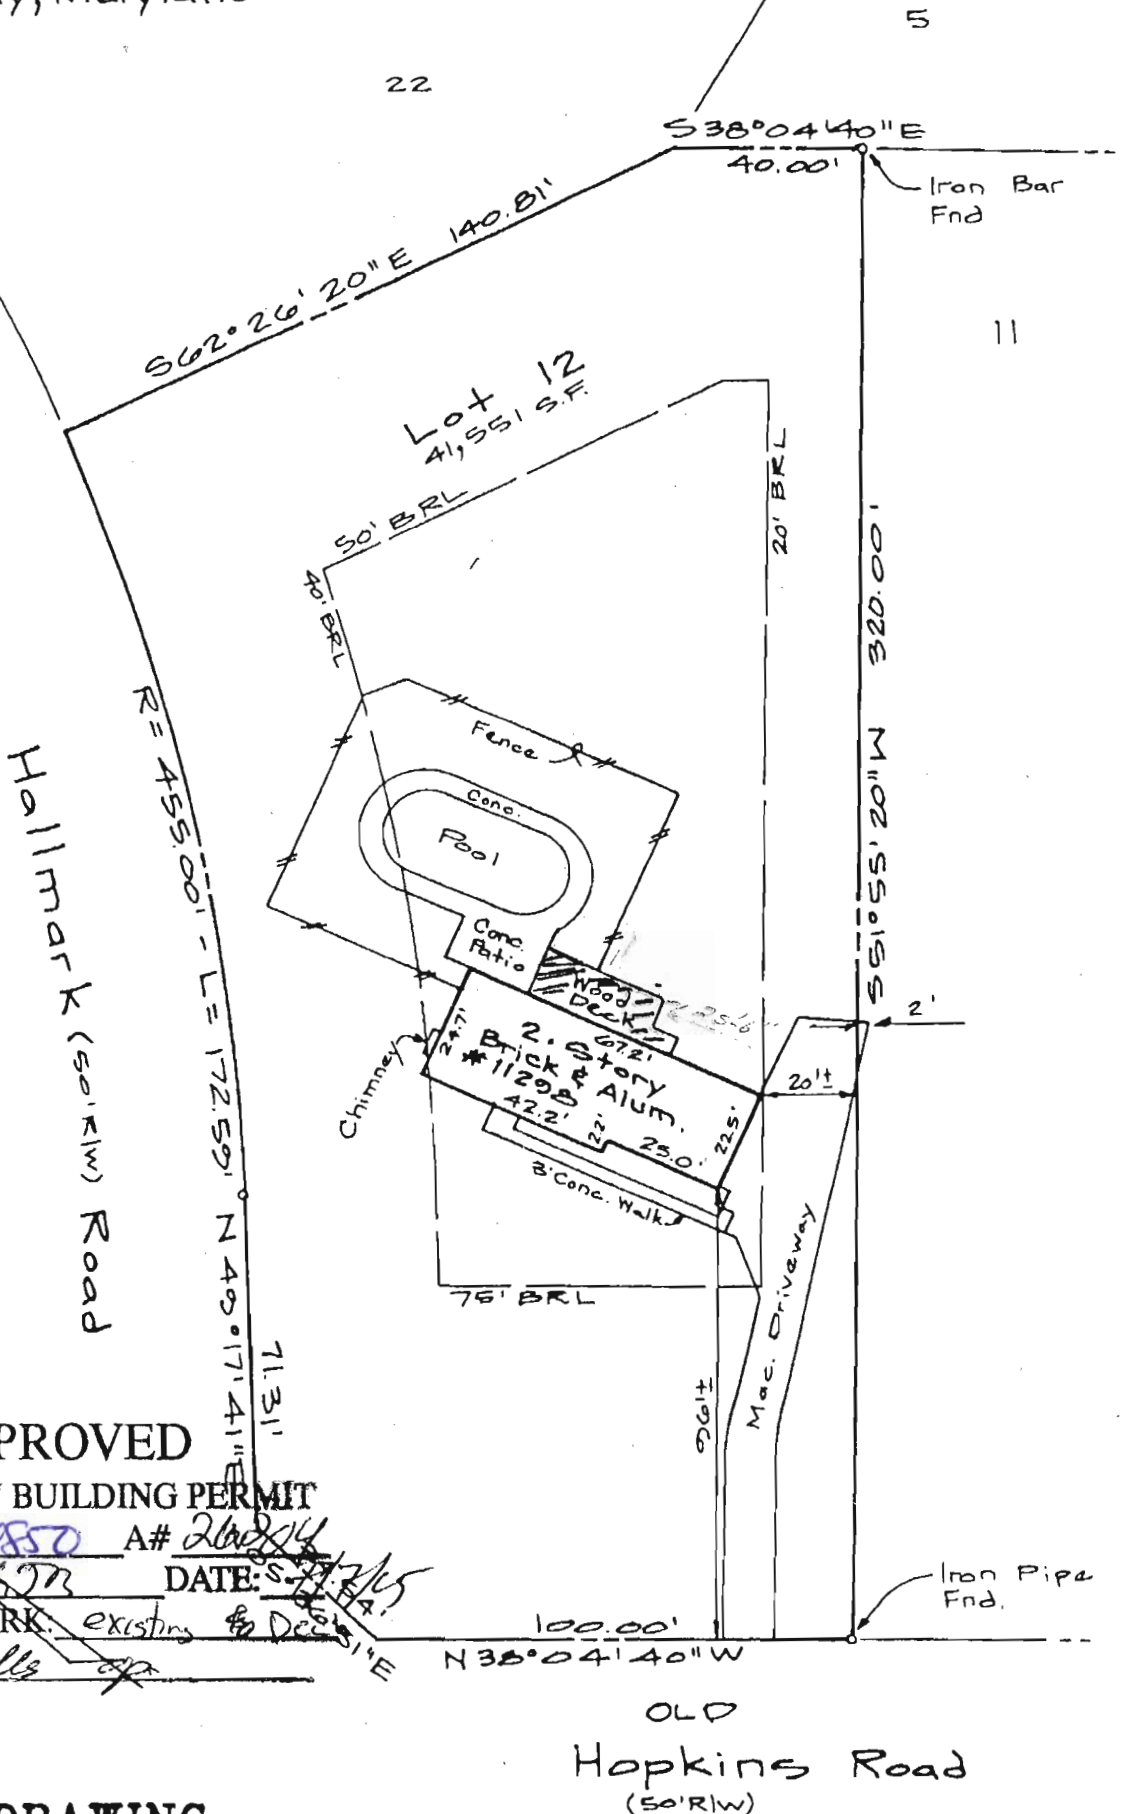

APPROVED

WALK-THRU BUILDING PERMIT

BP# BODK4850 A# 26204

APP. SAN LR DATE: 5/2/99

DESC. OF WORK: existing & Demolish
patio walls

LOCATION DRAWING

CERTIFICATION

This is to certify that I have surveyed the property known as: 1129B Old Hopkins Road

The information shown has been established by current acceptable survey procedures and from available record information. This drawing is to be used for Title Transfer Financing, or Refinancing Only and IS NOT to be used for the Establishment of Property Lines, Location for Fences, Garages, Buildings, or other Existing or Future Improvements.

SEAL



Walter Park

SCALE: 1" = 40'

DATE: 7/16/99

LDE Inc.

9250 Rumsey Road Suite 106
Columbia, Maryland 21045

(410) 715-1070 (Balt.)
(301) 596-3424 (Wash.)
(410) 715-9540 (Fax)