

9/16/74 File Animal 9.5
 7/12/74 Permitted 10.5
 7/12/74 vs 9/13/74

PERMIT
 SEWAGE DISPOSAL SYSTEM
 MARYLAND STATE DEPARTMENT OF HEALTH
 HOWARD COUNTY

P 20327
 A 14103
 ELLICOTT CITY
 DISTRICT 3rd
 DATE 7/10/74

INDEXED

Lyle Adcock Excavation IS PERMITTED TO INSTALL ALTER

ADDRESS Baltimore, Maryland 21227 PHONE 247-1024

A SEWAGE DISPOSAL SYSTEM LOCATED AT _____

SUBDIVISION Benson ROAD 3506 Lakeway Drive LOT 2, Blk. B, Sec. 1

PROPERTY OWNER Charles J. Karfonta

ADDRESS 21 Chrysler Place, Baltimore, Maryland Phone: 744-0512

SPECIFICATIONS 3 bedrooms

DRAIN FIELD _____ DEPTH _____ FEET, BOTTOM AREA _____ SQ. FT.

SEEPAGE PITS _____ ABSORBENT SIDE-WALL AREA _____ SQ. FT.

SEPTIC TANK CAPACITY 1000 GALLONS

FOR GARBAGE GRINDER, INCREASE DISPOSAL AREA 22% & TANK CAPACITY 50%.

OTHER DRY WELL - To be 100 sq. ft. of absorbent ~~at~~ sidewall area below the inlet pipe per bedroom. Maximum depth of dry well to be 11 ft. deep below original grade. Inlet pipe to begin 3 1/2 feet below original grade. Locate dry well 21 ft. from front property line and 50 ft. from left side line as lot is seen standing on Lakeway Drive facing lot.

NOTE: ALL PIPE FROM HOUSE TO DRY WELL MUST BE CAST IRON.

PERMIT VOID AFTER THREE YEARS.

NOTE: INSTALL STAND PIPE ON SEPTI C TANK AND DRY WELL.


PLANS APPROVED BY J. T. Wright and R. V. Torre DATE 1/15/71 and 11/27/73

FILL SEPTIC TANK AND DISTRIBUTION BOX WITH WATER BEFORE CALLING FOR AN INSPECTION. COVER NO WORK UNTIL INSPECTED AND APPROVED.

NEITHER THE HOWARD COUNTY COMMISSIONERS NOR THE HEALTH DEPARTMENT IS RESPONSIBLE FOR THE SUCCESSFUL OPERATION OF ANY SYSTEM.

A 14103

 _____ DATE SYSTEM APPROVED

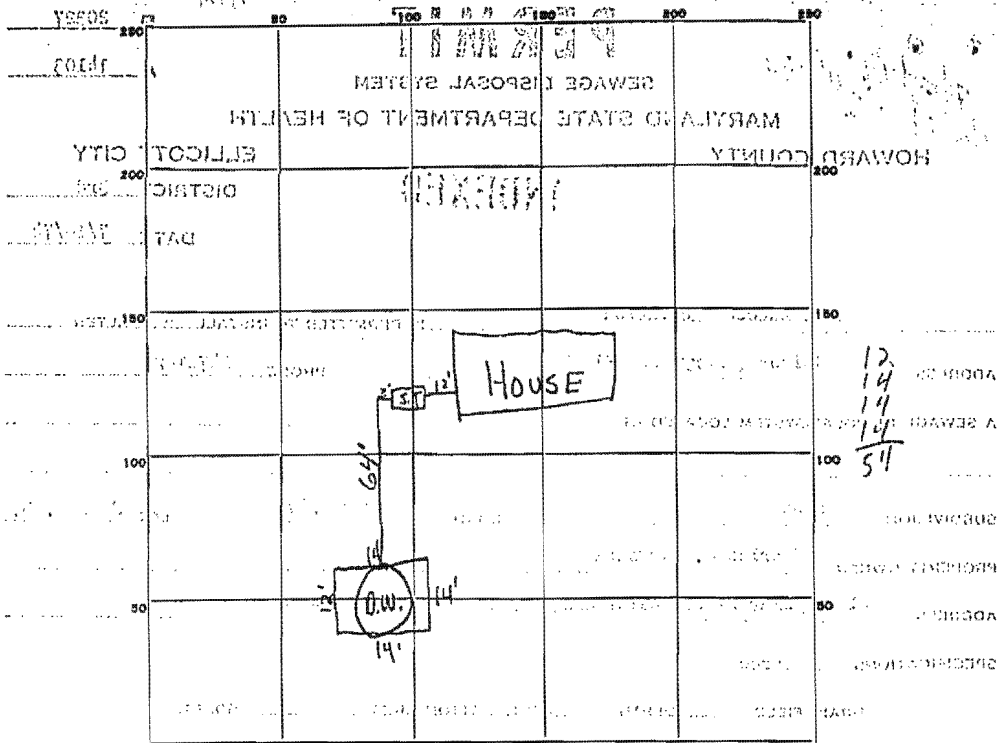

12
14
14
54

INDICATE NORTH - NAME ADJOINING ROADWAY AS BASE LINE.

Lakeway Drive

PERMIT CARD signed coordination correct S.T. D.W. O.K. no cap

SEPTIC TANK, LEVEL CLEANOUTS

DISTRIBUTION BOX, LEVEL _____

TILE FIELD, DEPTH _____ FT. TRENCH WIDTH _____ FT.

GRAVEL DEPTH _____ IN. TOTAL LENGTH _____ FT.

NUMBER OF TRENCHES _____ TOTAL BOTTOM AREA _____

D.W. WELL OUTSIDE PERIMETER 5.4 FT. DEPTH BELOW INLET 8 FT.

SEEPRAGE PITS INSIDE DIAMETER 5.4 FT. DEPTH BELOW INLET 8 FT.

ABSORBENT AREA ± 432 SQ. FT.

REMARKS: 7/12/74 No expansion well; pipe from house to septic tank not exposed. D.W. well inlet is at 25' below original grade. Partial checkout only A.S.

9/6/74 House sewer pipe from house to tank now exposed; cap on D.W. cleanout A.S.

DATE SYSTEM APPROVED 9/6/74 INSPECTOR Frank Skinner

