

11/25/68
Mr. Wine promised
nothing checked out

PERMIT

SEWAGE DISPOSAL SYSTEM

MARYLAND STATE DEPARTMENT OF HEALTH

HOWARD COUNTY

P 14133

A _____

ELLICOTT CITY

DISTRICT 5

DATE 11/22/68

INDEXED

Dale Thurman IS PERMITTED TO INSTALL _____ ALTER X

ADDRESS 8202 German Ave., Laurel, Md. PHONE 725-3615

A SEWAGE DISPOSAL SYSTEM LOCATED AT _____

SUBDIVISION Hopkins Head ROAD Cherry Tree Dr. LOT _____

PROPERTY OWNER James Voreis 3rd lot off Johns Hopkins Road - left

ADDRESS 1st lot on right

SPECIFICATIONS

DRAIN FIELD _____ DEPTH _____ FEET, BOTTOM AREA _____ SQ. FT.

SEEPAGE PITS _____ ABSORBENT SIDE-WALL AREA _____ SQ. FT.

SEPTIC TANK CAPACITY _____ GALLONS

FOR GARBAGE GRINDER, INCREASE DISPOSAL AREA 22% & TANK CAPACITY 50%.

OTHER REPAIR - Long trench - 50 ft. long - not over 12' deep - 2 ft. wide.

Call for inspection of trench before putting gravel in.

PLANS APPROVED BY Palmer F. Wine DATE 11/22/68


FILL SEPTIC TANK AND DISTRIBUTION BOX WITH WATER BEFORE CALLING FOR AN INSPECTION. COVER NO WORK UNTIL INSPECTED AND APPROVED.

NEITHER THE HOWARD COUNTY COMMISSIONERS NOR THE HEALTH DEPARTMENT IS RESPONSIBLE FOR THE SUCCESSFUL OPERATION OF ANY SYSTEM.

NOTIFY THE HEALTH DEPARTMENT 48 HOURS BEFORE EXCAVATIONS ARE TO BE BACK FILLED.

11/23/68

15 17
 3 30
 46 51
 18
 3 6 1/2
 5-4 12 1/2
 5 1/2 9 1/4
 35 7
 4
 51
 40 1/2
 8 1/6

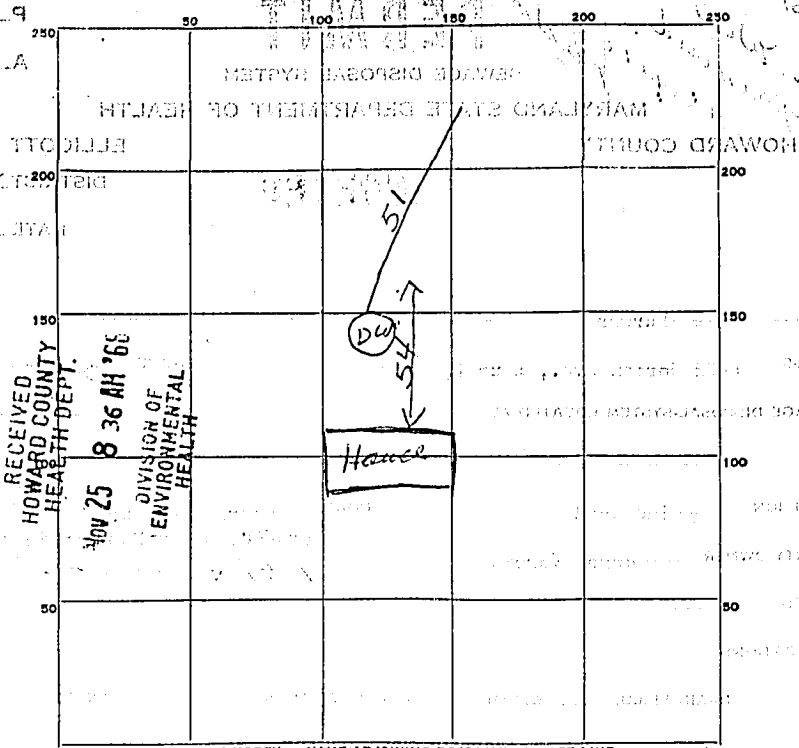

PERMIT CARD OK
 SEPTIC TANK, LEVEL _____ CLEANOUTS _____
 DISTRIBUTION BOX, LEVEL _____
 TILE FIELD, DEPTH: 12' FT. TRENCH WIDTH 2' FT.
7' GRAVEL DEPTH 8' FT. TOTAL LENGTH 51' FT.
 NUMBER OF TRENCHES 1 TOTAL BOTTOM AREA 8/6
 SEEPAGE PITS, INSIDE DIAMETER _____ FT. DEPTH BELOW INLET _____ FT.
 ABSORBENT AREA _____ SQ. FT.
 REMARKS _____

DATE SYSTEM _____
 J. J. Wright
 INSPECTOR 11/26/68