


LONG VIEW ROAD

SCALE 1" = 40'

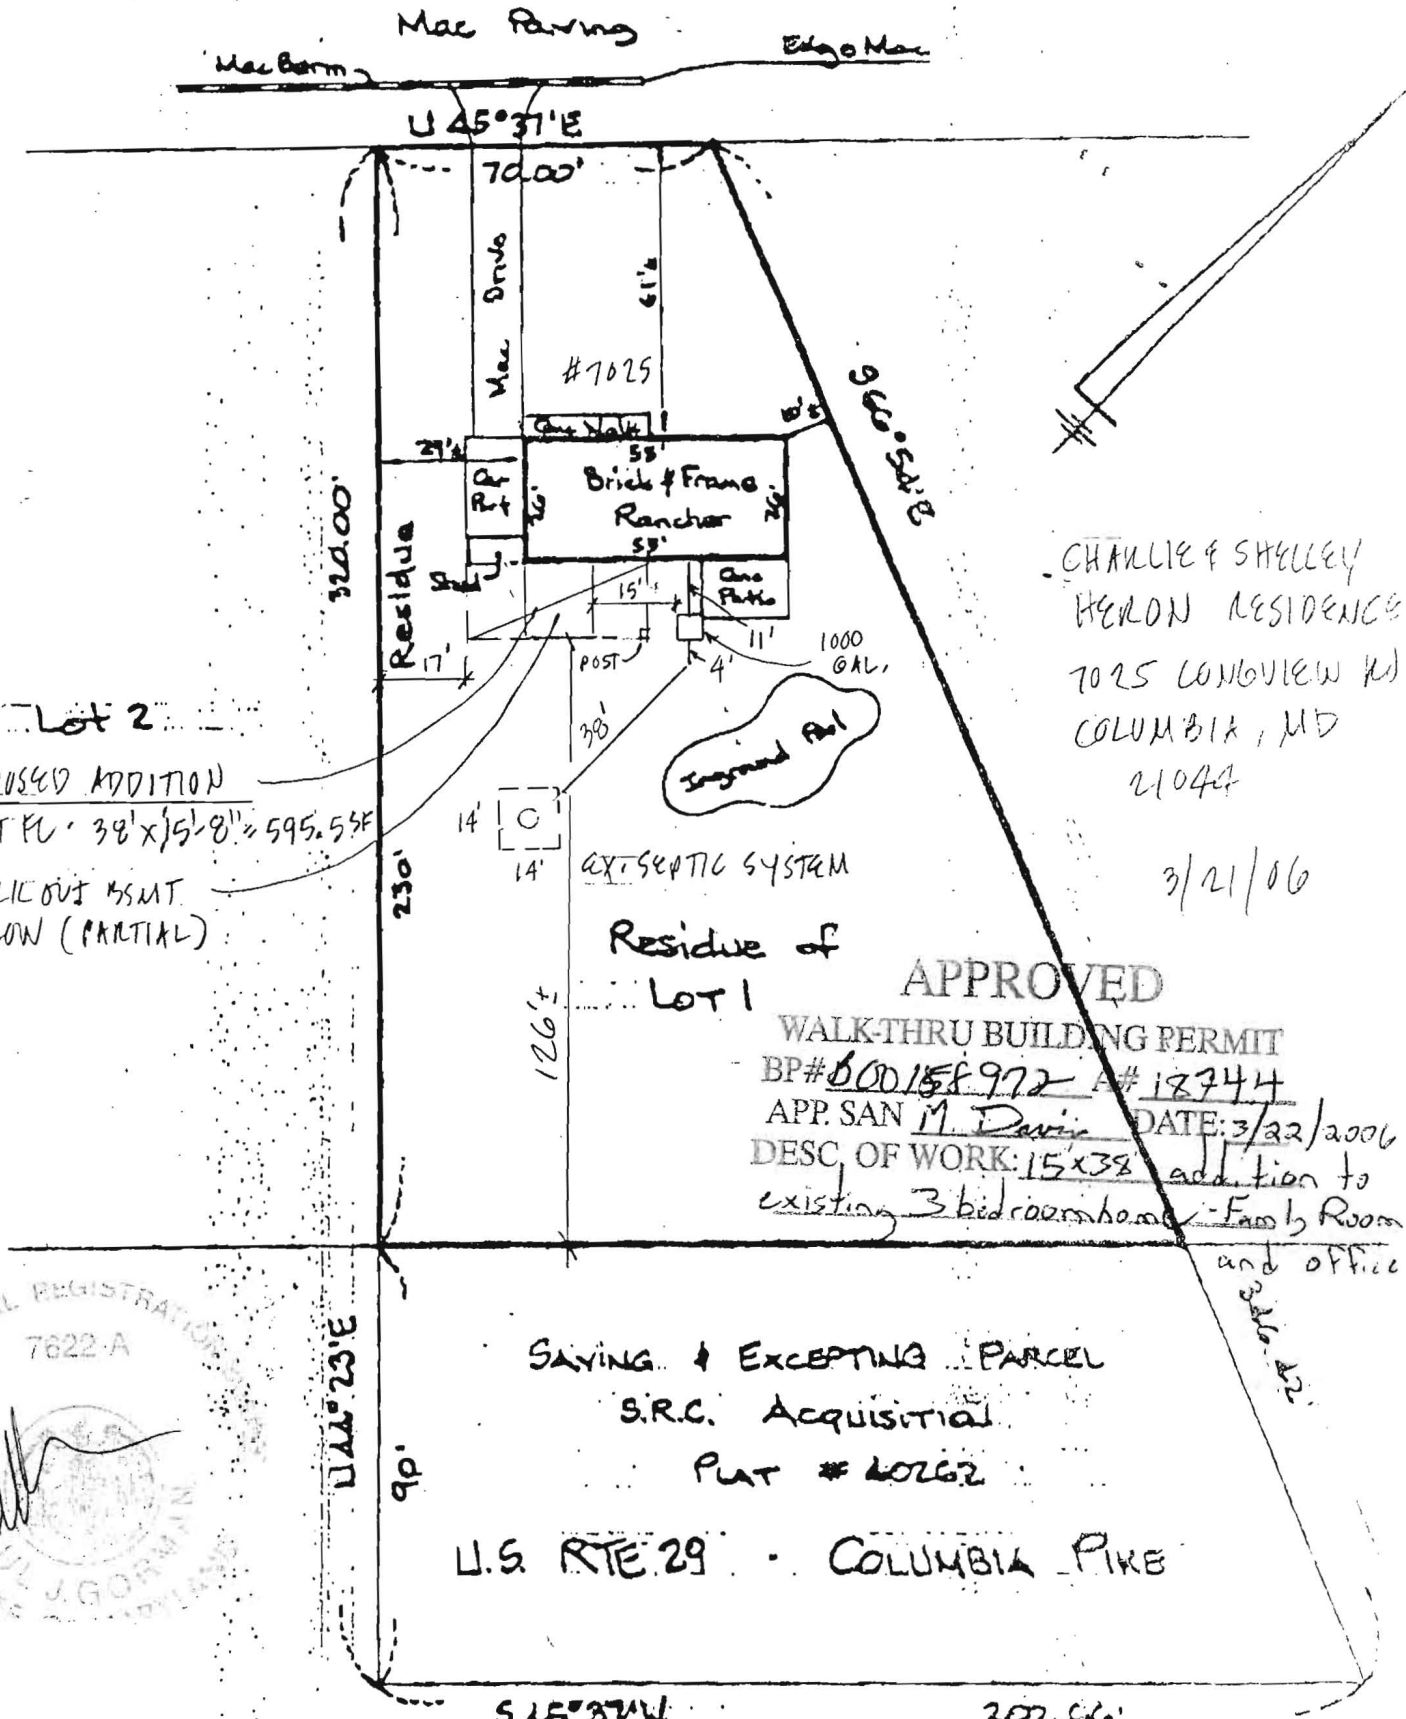

CHARLIE & SHELLEY  
 HERON RESIDENCE  
 7025 LONGVIEW RD  
 COLUMBIA, MD  
 21044

3/21/06

Lot 2  
 PROPOSED ADDITION  
 EAST FC - 38' x 51' 8" = 595.55 SF  
 UTILITY OUT BASMT  
 BELOW (PARTIAL)

APPROVED  
 WALK-THRU BUILDING PERMIT  
 BP# 000158972 A# 18744  
 APP. SAN M. Davis DATE: 3/22/2006  
 DESC. OF WORK: 15x38 addition to  
 existing 3 bedroom home - Family Room  
 and office

SAVING & EXCEPTING PARCEL  
 S.R.C. ACQUISITIONAL  
 PAT # 40262

U.S. RTE 29 - COLUMBIA PIKE



THE LOT SHOWN HEREON IS IN FLOOD  
 ZONE C PER FEMA FLOOD INSURANCE

LONG VIEW ROAD

SCALE 1" = 40'

Mac Farming

Mac Farm

Edge Mac

$\angle 45^{\circ} 31' E$

70.00'

Mac Drive

#7025

One Walk

Brick & Frame Rancher

53'

53'

15'

4'

11'

1000 GAL.



SEPTIC SYSTEM

Residue of LOT 1

APPROVED

WALK-THRU BUILDING PERMIT

BP# B00158977 A# 18744

APP. SAN M. Davis DATE: 3/22/2006

DESC. OF WORK: 15x38 addition to existing 3 bedroom home - Family Room and office

SAVING & EXCEPTING PARCEL

S.R.C. ACQUISITIONAL

PLAT # 40262

U.S. RTE. 29 - COLUMBIA PIKE

$\angle 45^{\circ} 31' W$

202.66'

CHARLIE & STELLY  
HERON RESIDENCE  
7025 LONGVIEW RD  
COLUMBIA, MD  
21044

3/21/06

Lot 2

PROPOSED ADDITION

NEST PL. 38' x 5'-8" = 595.53 SF

UTIL. OUT 45 MT  
BELOW (PARTIAL)



THE LOT SHOWN HEREON IS IN FLOOD ZONE C PER F.E.M.A. FLOOD INSURANCE DATE MAP PANEL # 21004-0030R