

*Preliminary*

# APPLICATION

A 09881  
P \_\_\_\_\_

SEWAGE DISPOSAL TESTING

MARYLAND STATE DEPARTMENT OF HEALTH

HOWARD COUNTY

ELLICOTT CITY  
DISTRICT 3  
DATE 3/31/65

TO: THE COUNTY HEALTH OFFICER  
ELLICOTT CITY, MARYLAND

I, HEREBY, APPLY FOR THE NECESSARY TESTS IN ORDER TO CONSTRUCT (OR RECONSTRUCT) A SEWAGE DISPOSAL SYSTEM.

PROPERTY OWNER Fox Den, Inc.

ADDRESS Folly Quarter Rd., Ellicott City, Md. PHONE HO 5-4222

PROPERTY LOCATION:

SUBDIVISION Fox Den Farms LOT NO. 7, Blk. A

ROAD AND DESCRIPTION Road Not Named Jumper Hill Road

OCCUPANT \_\_\_\_\_ PHONE \_\_\_\_\_

PERSON TO CONSTRUCT SYSTEM \_\_\_\_\_

ADDRESS \_\_\_\_\_ PHONE \_\_\_\_\_

SIZE OF LOT 93,000 sq. ft. TYPE BLDG. \_\_\_\_\_ NUMBER OF BEDROOMS 4

IF NOT SINGLE RESIDENCE DESCRIBE \_\_\_\_\_

SIGNATURE OF APPLICANT /s/ Geo. B. White


APPROVED BY J. Fleming FOR Dry Well (KIND OF SYSTEM) DATE 12-16-65

REJECTED BY \_\_\_\_\_ FOR \_\_\_\_\_ (KIND OF SYSTEM) DATE \_\_\_\_\_

HOLD PENDING FURTHER TESTS \_\_\_\_\_ DATE \_\_\_\_\_

REASONS FOR REJECTION OR HOLDING \_\_\_\_\_

# THIS IS NOT A PERMIT

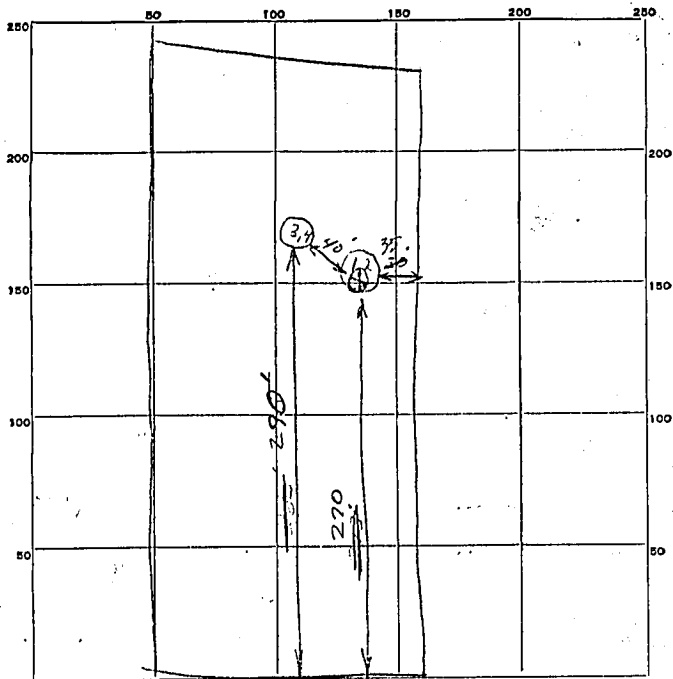

INDICATE NORTH. - NAME ADJOINING ROADWAY AS BASE LINE.

Juppens Hill Rd.

DATE	TEST NO.	DEPTH	PRE-WET		TEST - 1" DROP		TIME
			START	STOP	START	STOP	
4-2-65	1	9	1:39	1:41	1:41	1:45	4 1/2 min
	2	5 1/2	1:48	1:52	1:52	1:57	5 min
	3	9	1:50	1:52	1:52	1:55	3 min
	4	4	1:52	1:53	1:52	1:56	3 min
4/5/73	R	Void hole			← go back as marked		
		My dimensions of			290' back + 80' off		
		right sides.			into move up hill		
							C.B.D.

SOIL AUGER FINDING \_\_\_\_\_

TESTED BY JH

REMARKS \_\_\_\_\_

ALSO PRESENT 9 1/2 white

LOT NO. 7 P.P. A