

7/2/79
7/3/79
ready around 10:30 on 11/20/79

approved 10/24/79
J. [Signature]

PERMIT

SEWAGE DISPOSAL SYSTEM

MARYLAND STATE DEPARTMENT OF HEALTH

HOWARD COUNTY

P 29957
A 17429

10/24/79
final

39210

ELLICOTT CITY
DISTRICT 3rd.
DATE 6/28/79

INDEXED

Thomas G. Harris

IS PERMITTED TO INSTALL ALTER

ADDRESS Box 6, Monkton Md. 21111 PHONE 482 - 4613

SUBDIVISION Benson ROAD Lakeway Drive LOT 13A

PROPERTY OWNER Daniel Elswick

ADDRESS 10519 York Road, Cockeysville, Md. 21030

SPECIFICATIONS ~~3 Bedrooms~~ 4 Bedrooms

SEPTIC TANK CAPACITY ~~1000~~ 1250 GALLONS

DRAIN FIELD DEPTH FEET, BOTTOM AREA SQ. FT.

DEEP TRENCH DEPTH FEET, BOTTOM AREA SQ. FT.

SEEPAGE PITS ABSORBENT SIDE-WALL AREA 300 SQ. FT. per bedroom Total Absorbant Area 300 Sq. Ft.

DRY WELL INLET PIPE 4 FT. BELOW ORIGINAL GRADE. MAXIMUM DEPTH 10 FT. BELOW ORIGINAL GRADE

EFFECTIVE DEPTH AT FT. BELOW ORIGINAL GRADE.

LOCATE DISPOSAL AREA FT. FROM LOT LINE AND FT. FROM LOT LINE AS SEEN WHEN FACING LOT FROM

Locate Dry Well 155 ft from front lot line and 20 ft. from left lot line as seen when facing lot from Lakeway Drive

TRENCH to 4 1/2 ft below original grade and maximum depth to be 10 ft. - Come off rear of dry well - run trench toward rear lot line. Follow contour to keep trench level.

Trench for 3 bedrooms is to be 20 ft. and 4 bedrooms to be 45 ft.

PLANS APPROVED BY Wm. Zepp/ Frommelt DATE June 1, 1979

COVER NO WORK UNTIL INSPECTED AND APPROVED.

NEITHER THE HOWARD COUNTY COUNCIL NOR THE HEALTH DEPARTMENT IS RESPONSIBLE FOR THE SUCCESSFUL OPERATION OF ANY SYSTEM.

NOTE: IF TRENCH IS USED CALL FOR INSPECTION BEFORE PLACING GRAVEL IN TRENCH.

NOTE: NO DRY WELL SHALL EXCEED 15 FOOT IN DIAMETER.

NOTE: ALL PIPE FROM HOUSE TO DISPOSAL AREA MUST BE CAST IRON.

PERMIT VOID AFTER THREE YEARS.


NOTE: INSTALL STAND PIPE ON SEPTIC TANK AND DRY WELL. STAND PIPES MUST BE 6 INCHES IN DIAMETER. CAST IRON, CONCRETE OR TERRA COTTA ACCEPTED.

BLDG. PERMIT SIGNED AND RETURNED 7/11/79

Serial No. 39210

17429

*INSTALLER IS RESPONSIBLE FOR OBTAINING FINAL APPROVAL ON THIS PERMIT.

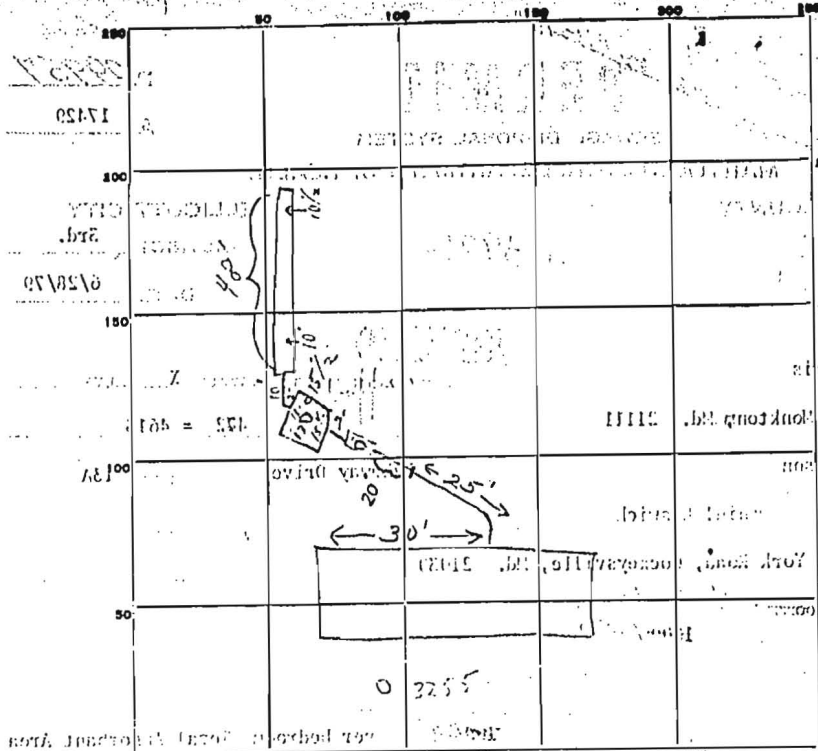

INDICATE NORTH - NAME ADJOINING ROADWAY AS BASE LINE.

PERMIT CARD 10/24/79 S.T. / 070

SEPTIC TANK, LEVEL 100 CLEANOUTS 100

DISTRIBUTION BOX, LEVEL N/A

TILE FIELD, DEPTH 10 TRENCH WIDTH 10

GRAVEL DEPTH 6 TOTAL LENGTH 20

NUMBER OF TRENCHES 1 TOTAL BOTTOM AREA -

SEEPAGE PITS, INSIDE DIAMETER 5 1/2 FT. DEPTH BELOW INLET 6 FT.

ABSORBENT AREA 621 SQ. FT.

REMARKS Checked - found - trench ok - on to street. C.B.D.

(Used trench, concrete and tank) @ P.M. E.U.P.C.O.

Found - Tank in place

9/3/79 Checked - found - trench ok - on to street. C.B.D.

10/24/79 - Horse connections OK - OK & cover removed. J&R/D

DATE SYSTEM APPROVED 10/24/79 INSPECTOR J. Stone