

APPLICATION

A 17429

SEWAGE DISPOSAL TESTING

P _____

MARYLAND STATE DEPARTMENT OF HEALTH

HOWARD COUNTY

ELLICOTT CITY

DISTRICT 3rd

DATE 9/13/72

TO: THE COUNTY HEALTH OFFICER
ELLICOTT CITY, MARYLAND

I, HEREBY, APPLY FOR THE NECESSARY TESTS IN ORDER TO CONSTRUCT (OR RECONSTRUCT) A SEWAGE DISPOSAL SYSTEM.

PROPERTY OWNER Carl C. Hall

ADDRESS 3737 Chatham Road, Ellicott City, Md. 21043 PHONE 465-2642

PROPERTY LOCATION:

SUBDIVISION Benson

ROAD AND DESCRIPTION Lakeway Drive

*NON LOT 13J
includes part
of old 12 13 & 14*

LOT No. 12, Blk. A, Sect. 2

OCCUPANT _____

PHONE _____

PERSON TO CONSTRUCT SYSTEM _____

ADDRESS _____

PHONE _____

SIZE OF LOT 40,000 sq. ft.

TYPE BLDG. 3 or 4 bedrooms

NUMBER OF BEDROOMS

IF NOT SINGLE RESIDENCE DESCRIBE _____

SIGNATURE OF APPLICANT /s/ Carl C. Hall

APPROVED BY _____

FOR _____

(KIND OF SYSTEM)

DATE _____

REJECTED BY _____

FOR _____

(KIND OF SYSTEM)

DATE _____


HOLD PENDING FURTHER TESTS _____

DATE _____

REASONS FOR REJECTION OR HOLDING _____

THIS IS NOT A PERMIT

OS&VI

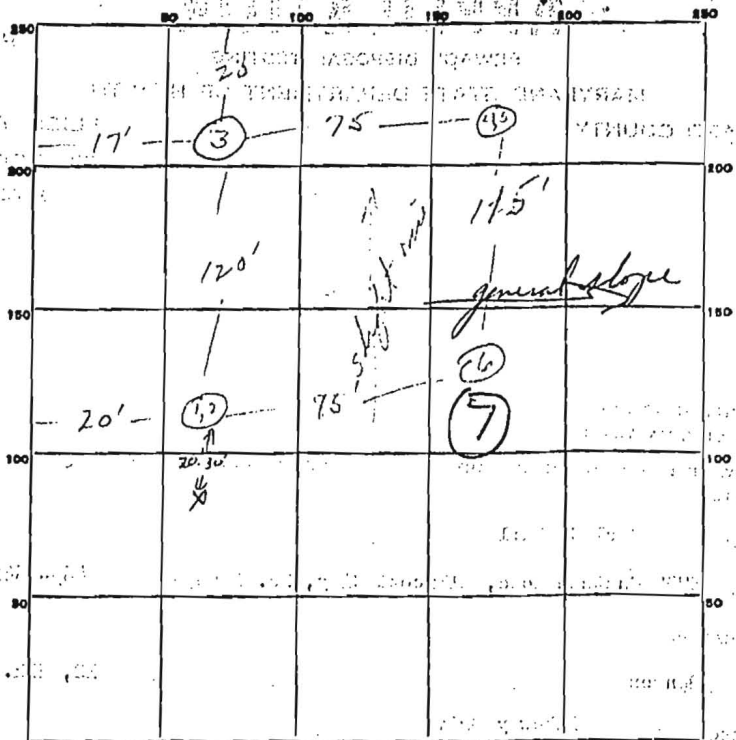

INDICATE NORTH. - NAME ADJOINING ROADWAY AS BASE LINE.
 LAUREN DR.

DATE	TEST NO.	DEPTH	PRE-WET		TEST - 1" DROP		TIME
			START	STOP	START	STOP	
9/6/73	1	6	9:50	9:52	9:52	9:56	3
	2	12	9:52	9:53	9:53	9:59	6
	3	11	10:00	10:03	10:03	10:06	3
	4	6	10:00	10:03	10:03	10:06	3
	5	14	10:00	10:04	10:04	10:22	18
	6	11	10:00	10:03	10:03	10:06	3
5/11/79	7	14	DRY ALL SAND				
			Fast B.y. R. H also present				
			Pat L. Lohr Daniel & Angela				
			Elswick (owners)				

10-7-73.
 System/ST

7-12

~~2/8~~

21
 t = 10 min

~~t = 8 min~~
 Max depth
 4'

SOIL AUGER FINDING: Soil at test 7 11'; sandy
 TESTED BY: (WATZ) use bk 742 or new in front of it.
 REMARKS: 445; soil appeared discolored 5-12; water at earth date?