

LAYOUT \_\_\_\_\_ INSP 4 \_\_\_\_\_  
INSP 2 \_\_\_\_\_ INSP 5 \_\_\_\_\_  
INSP 3 \_\_\_\_\_ INSP 6 \_\_\_\_\_

ISSUE DATE: \_\_\_\_\_

P 31130 \_\_\_\_\_

APPROVAL DATE: \_\_\_\_\_

A 524210 \_\_\_\_\_

**PERMIT**

INDEXED

TAX ID # 04-336917

**ON-SITE SEWAGE DISPOSAL SYSTEM  
HOWARD COUNTY HEALTH DEPARTMENT  
BUREAU OF ENVIRONMENTAL HEALTH**

IS PERMITTED TO INSTALL  ALTER

ADDRESS: \_\_\_\_\_ PHONE NUMBER: \_\_\_\_\_

SUBDIVISION: Warfield Estates LOT NUMBER: 19-B

ADDRESS: 14561 MacClintock Drive PROPERTY OWNER: R Margaret Gatto

SEPTIC TANK CAPACITY (GALLONS): \_\_\_\_\_ OUTLET BAFFLE FILTER REQUIRED

PUMP CHAMBER CAPACITY (GALLONS): \_\_\_\_\_ COMPARTMENTED TANK REQUIRED

NUMBER OF BEDROOMS: \_\_\_\_\_

SQUARE FEET PER BEDROOM: \_\_\_\_\_

LINEAR FEET OF TRENCH REQUIRED: \_\_\_\_\_

TRENCHES:	Trench to be _____ feet wide. Inlet _____ feet below original grade. Bottom maximum depth _____ feet below original grade. Effective area begins at _____ feet below original grade. _____ feet of stone below distribution pipe.
LOCATION:	
NOTES:	

PLANS APPROVED: \_\_\_\_\_ DATE: \_\_\_\_\_

- NOTE: PERMIT VOID AFTER 2 YEARS
- NOTE: CONTRACTOR RESPONSIBLE FOR SCHEDULING A PRE-CONSTRUCTION INSPECTION FOR ALL INSTALLATIONS
- NOTE: WATERTIGHT SEPTIC TANKS REQUIRED
- NOTE: ALL PARTS OF SEPTIC SYSTEM SHALL BE 100 FEET FROM ANY WATER WELL
- NOTE: MANHOLE RISERS REQUIRED ON ALL SEPTIC TANKS AND PUMP CHAMBERS UNLESS SPECIFICALLY AUTHORIZED

**NEITHER THE HOWARD COUNTY COUNCIL NOR THE HEALTH DEPARTMENT IS  
RESPONSIBLE FOR THE SUCCESSFUL OPERATION OF ANY SYSTEM  
PERMITTEE RESPONSIBLE FOR OBTAINING FINAL APPROVAL ON THIS PERMIT  
CALL 410-313-2640 FOR INSPECTION OF SEPTIC SYSTEM**

**BUILDING PERMIT SIGNED  
AND RETURNED**

11/19/07- B07004372- add Rooms

A524210

*approved 1/3/81*  
*5 layers*  
 129/81  
*as far as possible*  
 1/30/81  
*final*

# PERMIT

SEWAGE DISPOSAL SYSTEM

MARYLAND STATE DEPARTMENT OF HEALTH

HOWARD COUNTY

04-336917

INDEXED

P 31130  
 A 18124  
 ELLICOTT CITY 4th.  
 DISTRICT  
 DATE 1/28/80

\_\_\_\_\_ IS PERMITTED TO INSTALL  ALTER \_\_\_\_\_  
 ADDRESS 15775 Route 144 PHONE 442-1097  
 SUBDIVISION Warfield Estates ROAD 14561 MacClintock Dr. LOT 19 B  
 PROPERTY OWNER New World Homes *Gatto*

ADDRESS \_\_\_\_\_  
 SPECIFICATIONS 3 Bedrooms  
 SEPTIC TANK CAPACITY 1000 GALLONS  
 DRAIN FIELD \_\_\_\_\_ DEPTH \_\_\_\_\_ FEET, BOTTOM AREA \_\_\_\_\_ SQ. FT.  
 DEEP TRENCH \_\_\_\_\_ DEPTH \_\_\_\_\_ FEET, BOTTOM AREA \_\_\_\_\_ SQ. FT.  
 DRY WELL  
 SEEPAGE PITS  ABSORBENT SIDE-WALL AREA 130 SQ. FT. no less per bedroom  
 INLET PIPE  $3\frac{1}{2}$  FT. BELOW ORIGINAL GRADE. MAXIMUM DEPTH \_\_\_\_\_ FT. BELOW ORIGINAL GRADE  
 EFFECTIVE DEPTH AT \_\_\_\_\_ FT. BELOW ORIGINAL GRADE.  
 LOCATE DISPOSAL AREA \_\_\_\_\_ FT. FROM \_\_\_\_\_ LOT LINE AND \_\_\_\_\_ FT. FROM \_\_\_\_\_ LOT LINE AS SEEN WHEN \_\_\_\_\_ FACING LOT FROM


Locate dry well 190 feet from 233 ft. property line (rear property line) and 35 feet from the 235 ft. property line. Begin the trench 5 feet from the edge of the dry well and follow the contour of the land. The trench will be 2 ft. wide - 9 ft. deep and contain 5 ft. of stone. Call for two (2) inspections of trench - before and after stone is installed.

PLANS APPROVED BY Moorefield/Fronmelt DATE June 9, 1977

COVER NO WORK UNTIL INSPECTED AND APPROVED.  
 NEITHER THE HOWARD COUNTY COUNCIL NOR THE HEALTH DEPARTMENT IS RESPONSIBLE FOR THE SUCCESSFUL OPERATION OF ANY SYSTEM.  
 NOTE: IF TRENCH IS USED CALL FOR INSPECTION BEFORE PLACING GRAVEL IN TRENCH.  
 NOTE: NO DRY WELL SHALL EXCEED 16 FOOT IN DIAMETER.  
 NOTE: ALL PIPE FROM HOUSE TO DISPOSAL AREA MUST BE CAST IRON.  
 PERMIT VOID AFTER THREE YEARS.  
 NOTE: INSTALL STAND PIPE ON SEPTIC TANK AND DRY WELL. STAND PIPES MUST BE 8 INCHES IN DIAMETER, CAST IRON, CONCRETE OR TERRA COTTA ACCEPTED.

BLDG. PERMIT SIGNED AND RETURNED *6/26/77*  
*Serial # 46852*  
*Shannon*

\*INSTALLER IS RESPONSIBLE FOR OBTAINING FINAL APPROVAL ON THIS PERMIT.  
 HD - 23  
 BLDG. PERMIT SIGNED AND RETURNED *5/16/85*  
*Serial # 59616*  
*1 car garage with*  
*master and 2nd bath*  
 BLDG. PERMIT SIGNED AND RETURNED *12/16/89*  
*Serial # 30687*  
 APPROVED

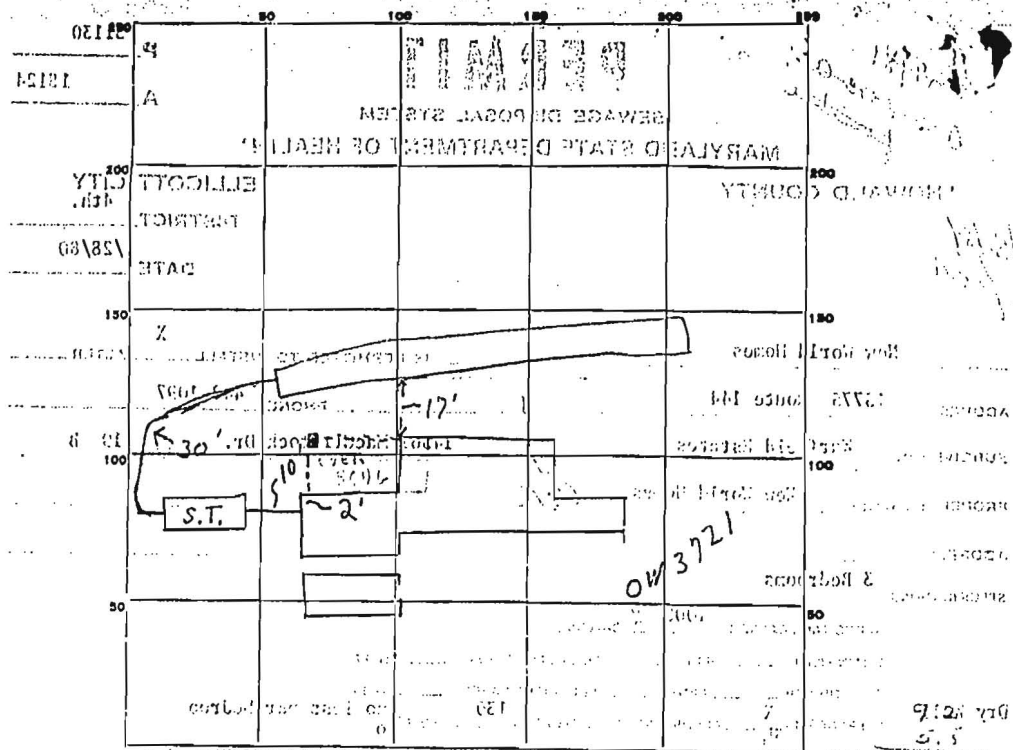

INDICATE NORTH. - NAME ADJOINING ROADWAY AS BASE LINE.  
 MAC CLINTOCK DR.

PERMIT CARD  MAC CLINTOCK DR. S.T.

SEPTIC TANK, LEVEL  CLEANOUTS

DISTRIBUTION BOX, LEVEL \_\_\_\_\_

TILE FIELD, DEPTH 5 FT. TRENCH WIDTH 2 FT.

GRAVEL DEPTH 5 1/2 IN. TOTAL LENGTH 92 FT.

NUMBER OF TRENCHES 1 TOTAL BOTTOM AREA 506

SEEPAGE PITS, INSIDE DIAMETER \_\_\_\_\_ FT. DEPTH BELOW INLET \_\_\_\_\_ FT.

ABSORBENT AREA 506 SQ. FT.

REMARKS: 1/29/81 OK TO PUT STONE IN TRENCH ONLY. NOTE CALLED FROM  
OFFICE - SPOKE TO MR FROMMELT - OK FOR TRENCH TO STAY 92 IS  
DUE TO CRACK SPACE PER MR DIXON WITHIN 70' OF TRENCH  
1/30/81 OK to cover all work @

DATE SYSTEM APPROVED 1/30/81 INSPECTOR STAY

**LOT 19**  
**SECTION SEVEN**  
**WARFIELD ESTATES**

A18124

Well Elev. 565.00'  
 f.f. 568.00'  
 base. 560.00'  
 Fin. gr. tank 567.00'  
 Inv. In. 562.75'  
 Inv. Out 562.50'

Inv. In. Field 562.00'  
 Finish Gr. Field 566.00'  
 Inv. Out of House 562.90'  
 Tank 1500 gal.  
 Drain field - 90' on countour

