

APPLICATION

PERCOLATION TESTING

A 39572

P _____

HOWARD COUNTY HEALTH DEPARTMENT
BUREAU OF ENVIRONMENTAL HEALTH
P.O. BOX 476 ELLICOTT CITY, MARYLAND 21043
TELEPHONE: 461-9933

DISTRICT 5-TH

DATE 6-12-87

TO: THE COUNTY HEALTH OFFICER
ELLICOTT CITY, MARYLAND

I HEREBY APPLY FOR THE NECESSARY TEST IN ORDER TO CONSTRUCT (OR RECONSTRUCT) A SEWAGE DISPOSAL SYSTEM.

PROPERTY OWNER ~~Kennard Warfield Jr. Crystal Clear General Partnership~~

ADDRESS 14663 Tridelphia Rd Glenely 21737 PHONE 670-9114
442-2337

PROSPECTIVE BUYER N/A Mark & Brenda Schluter

ADDRESS _____ PHONE 997-9500

PROPERTY LOCATION:
SUBDIVISION Crystal Clear LOT NO. 19 LOT 14 Preliminary

ROAD AND DESCRIPTION West side Ivory Rd North side Tridelphia Rd
13930 Kennard Drive

TAX MAP 22 PARCEL # 533

SIZE OF LOT 3± acres TYPE BLDG. SFD
(SINGLE FAMILY DWELLING OR COMMERCIAL)

THE SYSTEM INSTALLED UNDER THIS APPLICATION IS ACCEPTABLE ONLY UNTIL PUBLIC FACILITIES BECOME AVAILABLE. I FULLY UNDERSTAND THE FEE CONNECTED WITH THE FILING OF THIS PERC TEST APPLICATION IS NON-REFUNDABLE UNDER ANY CIRCUMSTANCES. I ALSO AGREE TO COMPLY WITH ALL M.O.S.H.A. REQUIREMENTS IN TESTING THIS LOT.

Mal Rein
(SIGNATURE OF APPLICANT)

APPROVED BY _____ FOR _____ DATE _____

REJECTED BY _____ FOR _____ DATE _____


HOLD PENDING FURTHER TESTS _____ DATE _____

REASONS FOR REJECTION OR HOLDING 7/28/87 Perc Satisfactory - 1610 for Subdivision per SA

BLDG. PERMIT SIGNED
AND RETURNED 7/2/88
Serial # 49188 - SFD

BLDG. PERMIT SIGNED
AND RETURNED 9/11/89
Serial # 28922 - SFD
5 Bedrooms with Opt Sleep

THIS IS NOT A PERMIT

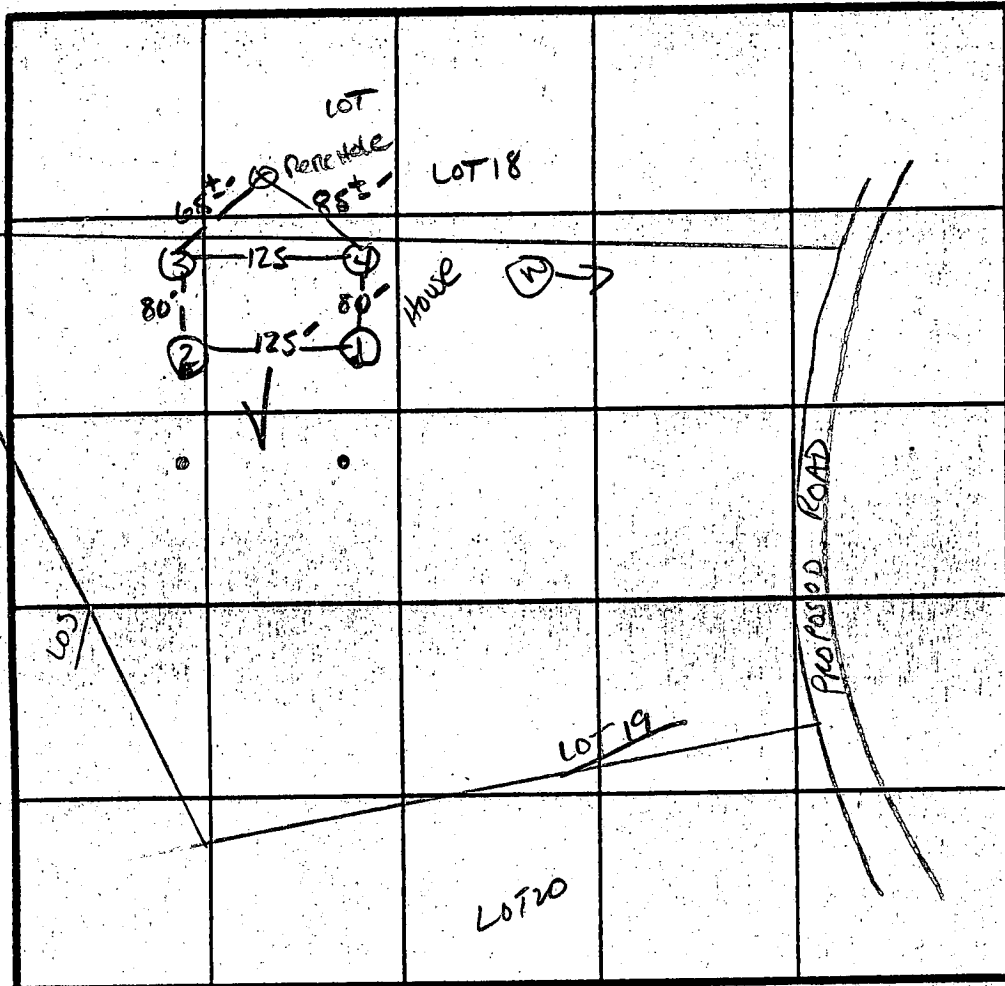

X Perc 17 min
 225 φ 13L
 INLET 3.5
 BOTTOM 5.5

① → ④
 SOIL PROFILE

7"
 2.0-4.0'
 AP
 Yellow Bl
 Silty loam
 Clayey
 10% frags
 Yellow Br
 Slightly
 micaceous
 Silty loam
 15-20%
 frags

DATE	TEST NO.	DEPTH	PRE-WET		TEST 1" DROP		TIME
			START	STOP	START	STOP	
7/28/87	1 S	4.5'	11:30	11:43	11:43	12:10	27 MIN
		8.0'	11:30	11:35	11:35	11:41	6 MIN
	1 V	12.5'	UNIFORM soil below 4.0'				
	2 S	3.0'	11:34	11:44	11:44	12:03	19 MIN
		13.0'	SMALL AMT OF H ₂ O AT 13.5'			UNIFORM soil below 2.0'	
	3 V	13.0'	UNIFORM soil below 3.5'				
	4 S	5'	12:35	12:47	12:47	11:02	15 MIN
		12.5'	UNIFORM soil below 4.0'				

REMARKS Holes DIFF THAN PLAT - Shallow Syst. Only

TYPE OF SOIL Chester Loam

TESTED BY S. Abel ALSO PRESENT MARK - K+K

EH-12-1079