

8/19/82
check per hole
6/1/83

PERMIT

P. 32079
A. REPAIR

SEWAGE DISPOSAL SYSTEM
MARYLAND STATE DEPARTMENT OF HEALTH

APPROVED 6/1/83
FS/cw

HOWARD COUNTY

ELLICOTT CITY

03-285072

9/19/82
1:30 p.m.

DISTRICT _____

DATE August 12, 1982

BILL TRIPLETT

INDEXED

William Boyd IS PERMITTED TO INSTALL _____ ALTER

ADDRESS 2785 Marriottsville Rd., Marriottsville, Md. PHONE 795-4263

SUBDIVISION _____ ROAD 2785 Marriottsville Rd. LOT _____

PROPERTY OWNER William Boyd

ADDRESS Same as above

SPECIFICATIONS

- SEPTIC TANK CAPACITY _____ GALLONS
- DRAIN FIELD _____ DEPTH _____ FEET, BOTTOM AREA _____ SQ. FT.
- DEEP TRENCH _____ DEPTH _____ FEET, BOTTOM AREA _____ SQ. FT.
- SEEPAGE PITS _____ ABSORBENT SIDE-WALL AREA _____ SQ. FT.
- INLET PIPE _____ FT. BELOW ORIGINAL GRADE. MAXIMUM DEPTH _____ FT. BELOW ORIGINAL GRADE
- EFFECTIVE DEPTH AT _____ FT. BELOW ORIGINAL GRADE.
- LOCATE DISPOSAL AREA _____ FT. FROM _____ LOT LINE AND _____ FT. FROM _____ LOT LINE AS SEEN WHEN

FACING LOT FROM

Complete system - 1000 gal septic tank - with dist. box.

~~REPAIR - CALL FOR INSPECTION WHEN GROUND IS OPENED UP SO SANITARIAN CAN~~

RECOMMEND REPAIR. Sewage to be pumped up hill

approx. 120 ft from septic tank. Recommend 150 ft
of trench - 6 ft deep 3 ft wide with 3 ft of stone. JS

PLANS APPROVED BY Palmer F. Wine DATE August 12, 1982

COVER NO WORK UNTIL INSPECTED AND APPROVED.

NEITHER THE HOWARD COUNTY COUNCIL NOR THE HEALTH DEPARTMENT IS RESPONSIBLE FOR THE SUCCESSFUL OPERATION OF ANY SYSTEM.

NOTE: IF TRENCH IS USED CALL FOR INSPECTION BEFORE PLACING GRAVEL IN TRENCH.

NOTE: NO DRY WELL SHALL EXCEED 15 FOOT IN DIAMETER.


NOTE: ALL PIPE FROM HOUSE TO DISPOSAL AREA MUST BE CAST IRON.

PERMIT VOID AFTER THREE YEARS.

NOTE: INSTALL STAND PIPE ON SEPTIC TANK AND DRY WELL. STAND PIPES MUST BE 6 INCHES IN DIAMETER. CAST IRON, CONCRETE OR TERRA COTTA ACCEPTED.

*INSTALLER IS RESPONSIBLE FOR OBTAINING FINAL APPROVAL ON THIS PERMIT.

P 32079

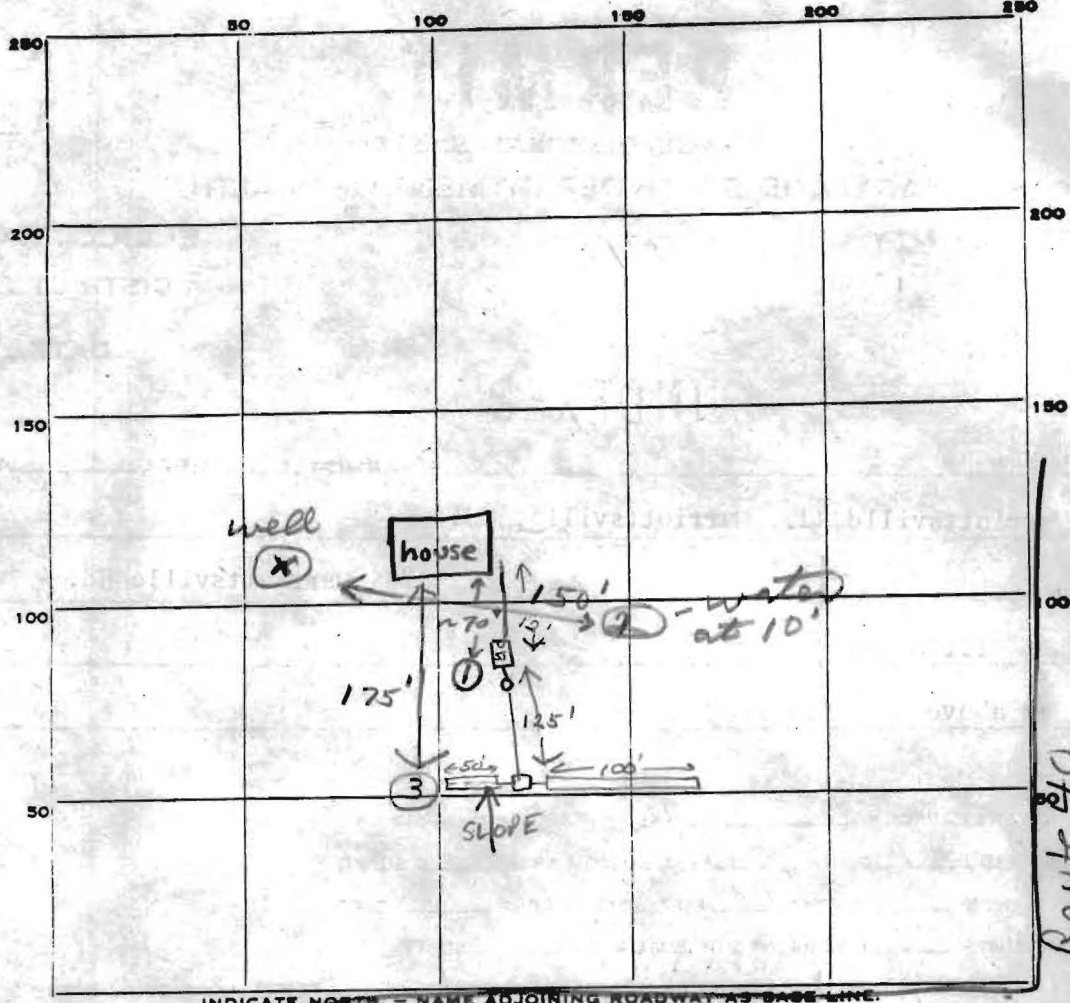

0	Fill
2'	Topsoil
3	clay
5'	
	Sandy mica loam
8 1/2'	Water

8/19/82 J.S.

INDICATE NORTH - NAME ADJOINING ROADWAY AS BASE LINE.
 Marriottsville Rd.

PERMIT CARD _____

SEPTIC TANK, LEVEL _____ CLEANOUTS ST.

DISTRIBUTION BOX, LEVEL _____

TILE FIELD, DEPTH ~ 6 FT. TRENCH WIDTH 3 FT.

GRAVEL DEPTH 3 FT. TOTAL LENGTH 150 FT.

NUMBER OF TRENCHES 2 TOTAL BOTTOM AREA 450 ϕ

SEEPAGE PITS, INSIDE DIAMETER _____ FT. DEPTH BELOW INLET 3 FT.

ABSORBENT AREA ±450 SQ. FT.

REMARKS 9/7/82 - Visual hole 13' deep. Sandy brown to 10 ft. Heavy clay to 13 ft. J.S. (See attached drawing)

6/1/83 ^{515 in} Trench dug & gravel & pipe already installed, distribution box is parged steel pipe to Mr. Boyd. OK to cover absorption trench but call for final when house sewer, electrical connection in manhole & man hole over pump pit is installed so line between pump pit and distribution box may be pressure tested J.S. NO RECORD OF FURTHER INSPECTION REQUESTS AS OF 7/95

DATE SYSTEM APPROVED 6/1/83 INSPECTOR ES/CW

INDEX AS APPROVED. (CW)

Wm. Boyd Property - Merrittville Rd.

