

MARYLAND DEPARTMENT OF THE ENVIRONMENT, WATER MANAGEMENT ADMINISTRATION
1800 Washington Blvd., Baltimore, Maryland 21230 (410) 537-3784

WATER WELL ABANDONMENT-SEALING REPORT FORM

SUBMIT COPIES OF COMPLETED FORM TO:


- * COUNTY ENVIRONMENT AGENCY (contact MDE, WMA if address needed)
- * WELL OWNER
- * MDE, WATER MANAGEMENT ADMINISTRATION, WELL PROGRAM

DATE WELL ABANDONED: 3-10-05 (month/day/year)

- PERMIT NUMBER OF ABANDONED WELL (if any) _____
- PERMIT NUMBER OF REPLACEMENT WELL _____
- PERSON ABANDONING WELL: Michael Isom
- OWNER'S NAME: Commercial Contractors
- WELL LOCATION:
 COUNTY: Howard
 NEAREST TOWN: West Friendship
 TAX MAP _____ BLOCK _____ PARCEL _____
 SUBDIVISION: _____
 SECTION: _____ LOT: _____
 NEAREST ROAD: 2785 Macclottsville Rd

WELL DRILLERS LICENSE NUMBER: 162
CIRCLE: MWD (MSD) (MGD)

SITE LOCATION MAP

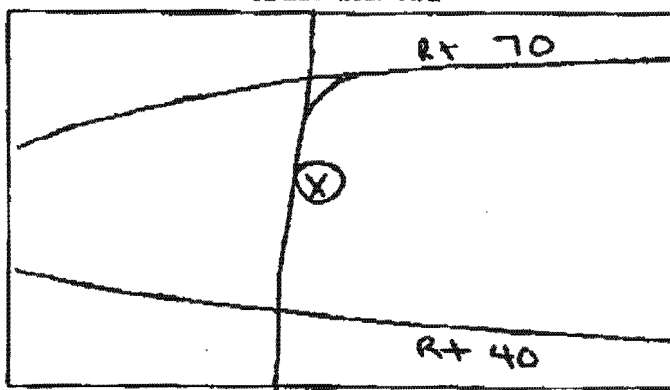

TYPE OF WELL BEING ABANDONED:

- DRILLED _____ JETTED _____
- _____ BORED/AUGERED _____ HAND DUG _____
- _____ OTHER (specify) _____

USE CODE:

- DOMESTIC _____ MUNICIPAL/PUBLIC _____
- _____ IRRIGATION _____ INDUSTRIAL _____
- _____ TEST/OBSERVATION _____ GEOTHERMAL _____

TYPE OF CASING:

- STEEL _____ PLASTIC _____
- _____ CONCRETE _____ OTHER (specify) _____

SIZE OF CASING: 6 INCHES IN DIAMETER

DEPTH OF WELL: 100 FEET DEEP

WAS ANY CASING REMOVED? YES _____ NO
if yes, length removed, in feet _____

WAS CASING RIPPED OR PERFORATED? YES _____ NO

LOG OF SEALING MATERIAL

MATERIAL	FEET	
	FROM	TO
Portland Cement	100	0
VOLUME OF MATERIAL USED		

NATURE-MASTER WELL DRILLER OR SUPERVISING SANTARIAN

162 LICENSE # MWD (MSD) (MGD) CIRCLE ONE 3-11-05 DATE

APR 828 JULY 1997

1) M(1)

Mar 11 2005 15:50 P.01

Fax:4105600784

U ELLERK MARK SUNS