



**SETBACKS:**  
 REAR PL. 10'  
 SIDE PL. 10'  
 HOUSE N/A  
 SEPTIC 20'  
 WELL 20'

DUSTIN  
 443-220-3781

**E.P.O.M** Inc.  
 P.O. BOX 8597  
 ELICOTT MD 21075  
 WWW.ElitePool.com

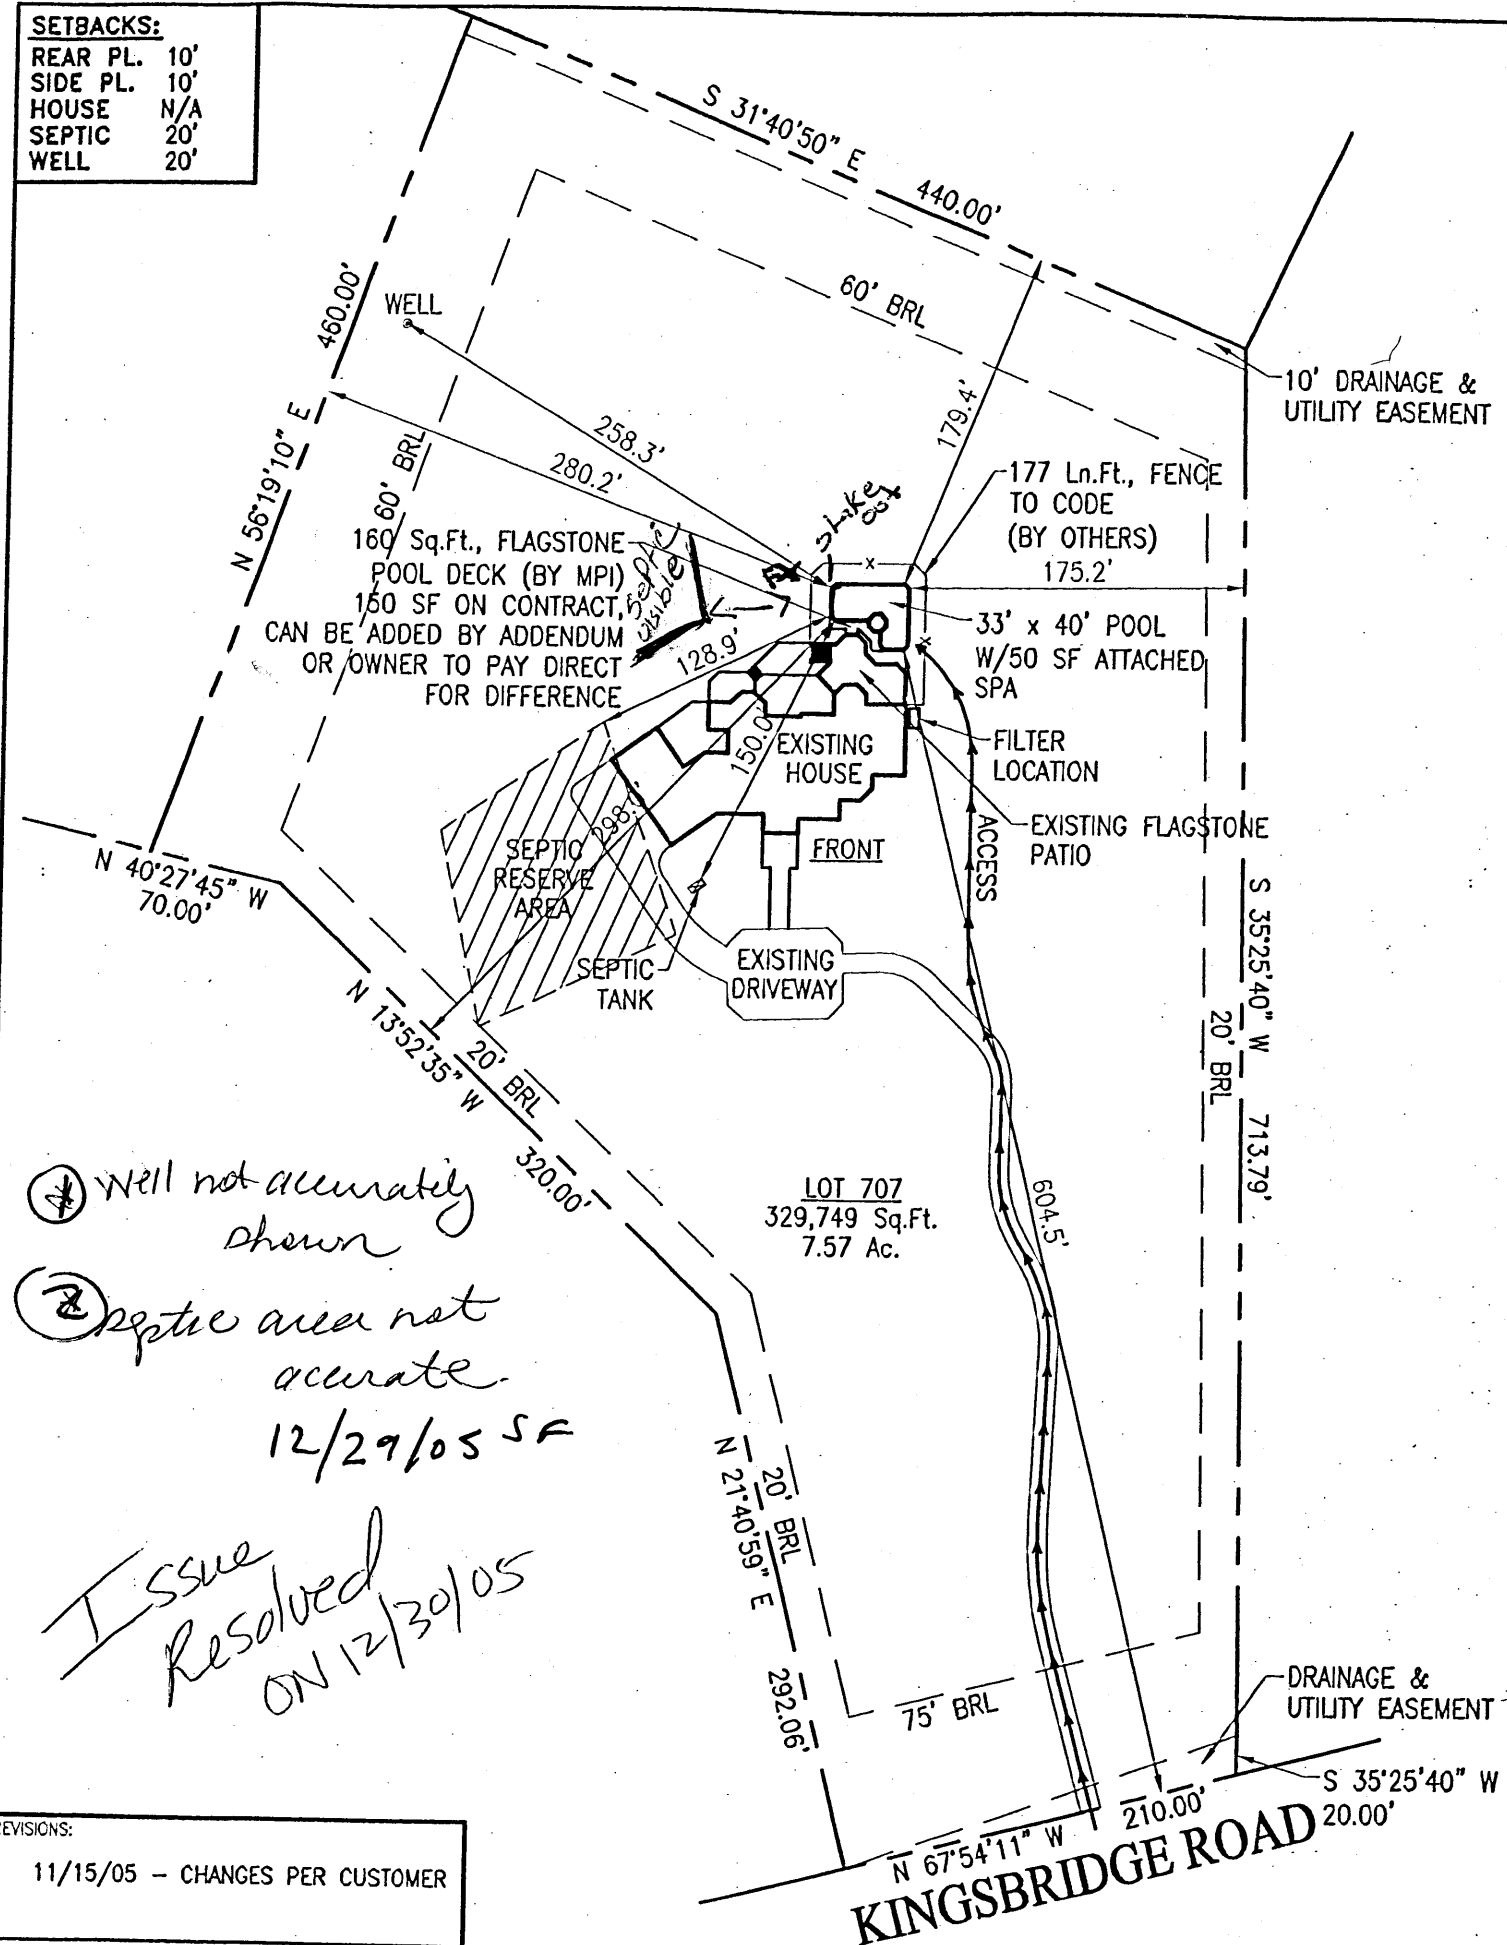

**PRIVATE WELL  
& PRIVATE SEPTIC**

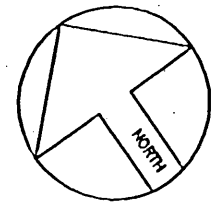

ZONE: ONE

**APPROVED**

**WALKTHRU BUILDING PERMIT**  
 BP# B0157520A# 49655  
 APP. SAN Kelce Neenan DATE: 1/3/06  
 DESC. OF WORK: large pool  
Site isp done by SANDTARIAN

**SITE PLAN** ON 12/30/05

1"=100'

**LOT 707  
BURLEIGH MANOR**

ACCOUNT #339978  
 MAP 24, GRID 13, PARCEL 766  
 ELECTION DISTRICT NO.02  
 HOWARD COUNTY, MARYLAND

**PERMIT NUMBERS**  
 POOL:  
 ELECT:  
 OTHER:

**IN-PROGRESS  
NOT FOR  
CONSTRUCTION**  
 DATE: 11-15-05

**EQUIPMENT LIST**

- DIRT/GRADING: HAUL
- SPA: 50 SF W/4 JTS, 100W LGHT, SKIM & BLWR
- RAISED BEAM: NONE
- TILE: TBD
- COPING: PA FULL RANGE FLAGSTONE -- CUT
- PLASTER: PEBBLETECH -- TAHOE BLUE
- FILTER SYS: C&C 420 SF CART. W/2HP PUMP
- CLEANING SYS: PCC-2000
- TREATMENT SYS: MINERAL SPRINGS
- CONTROL SYS: INTELLITOUCH 19+3
- HEATER: 400K BTU (NATURAL GAS)
- LIGHTS: TWO WATTS: 500 VOLTS: 120
- LOVESEAT: (3) @ 10' -- INSIDE
- AQUA BENCH: NONE
- RAIL GOODS: NONE
- DECKING: 150 Sq.Ft., FLAGSTONE
- FENCE: BY OWNER
- POOL COVER: POOL & SPATYPE: LOOP-LOC (MESH)
- CHEMICALS: \$50 CHEMICAL ALLOWANCE
- OTHER ITEMS: INITIAL WATER FILL (7 LOADS)  
(1) 54" TELESCOPIC FOUNTAIN

ELECTRIC: 200 FT.

**POOL DATA**

SIZE/SHAPE: 33' x 40' -- CUSTOM (NON-DIVING)  
 POOL AREA: 885 SPA: 50 OTHER:  
 TOTAL AREA: 935  
 PERIMETER: 148 SPA: 27  
 GALLONAGE: 27,335 DEPTH: 3'0"-6'0"-3'0"

**DIRECTIONS TO SITE**

RT.40/WEST TO L/T ON CENTENNIAL LANE. R/T ON BRECON-SHIRE RD., L/T ON KINGSBRIDGE RD.

MAP #  
**11**  
 GRID  
**E-11**

\*\*\*\*NEED TO CALL CLIENT'S CELL PHONE TO GET ACCESS THROUGH GATE\*\*\*\*  
**Victor A. & Cheryl Bracey**  
 10413 Kingsbridge Road  
 Ellicott City, Maryland 21042  
 Howard County

HOME PHONE: 410-465-1556  
 OFFICE PHONE:  
 CELLULAR PHONE: 443-745-4566

**SITE PLAN**

ZONE:  
**ONE**

LOT: 707	SUBDIVISION NAME: BURLEIGH MANOR	DISTRICT: 02	PIN # 339978
SCALE: 1"=100'	BY: J.L.R.	DATE: 10/21/05	JOB NUMBER: GS05-8620
			SHEET #: S-1

REVISIONS:  
 11/15/05 -- CHANGES PER CUSTOMER


Well not accurately shown  
 Septic area not accurate  
 12/29/05 SF  
 Issue Resolved ON 12/30/05

SITE INSPECTION SHEET

OWNER: Bracey, Victor PHONE #: 410-869-7940  
 ADDRESS: 10413 Kingsbridge Rd. CONTRACTOR: Elite Pools  
 WELL TAG #: HO-88-0750  
 SUBDIVISION: Burlough Manor LOT: 707 COUNTY #: Howard  
 PROPOSAL: \_\_\_\_\_

Verify pool location and distance from septic

LOCATION DIAGRAM

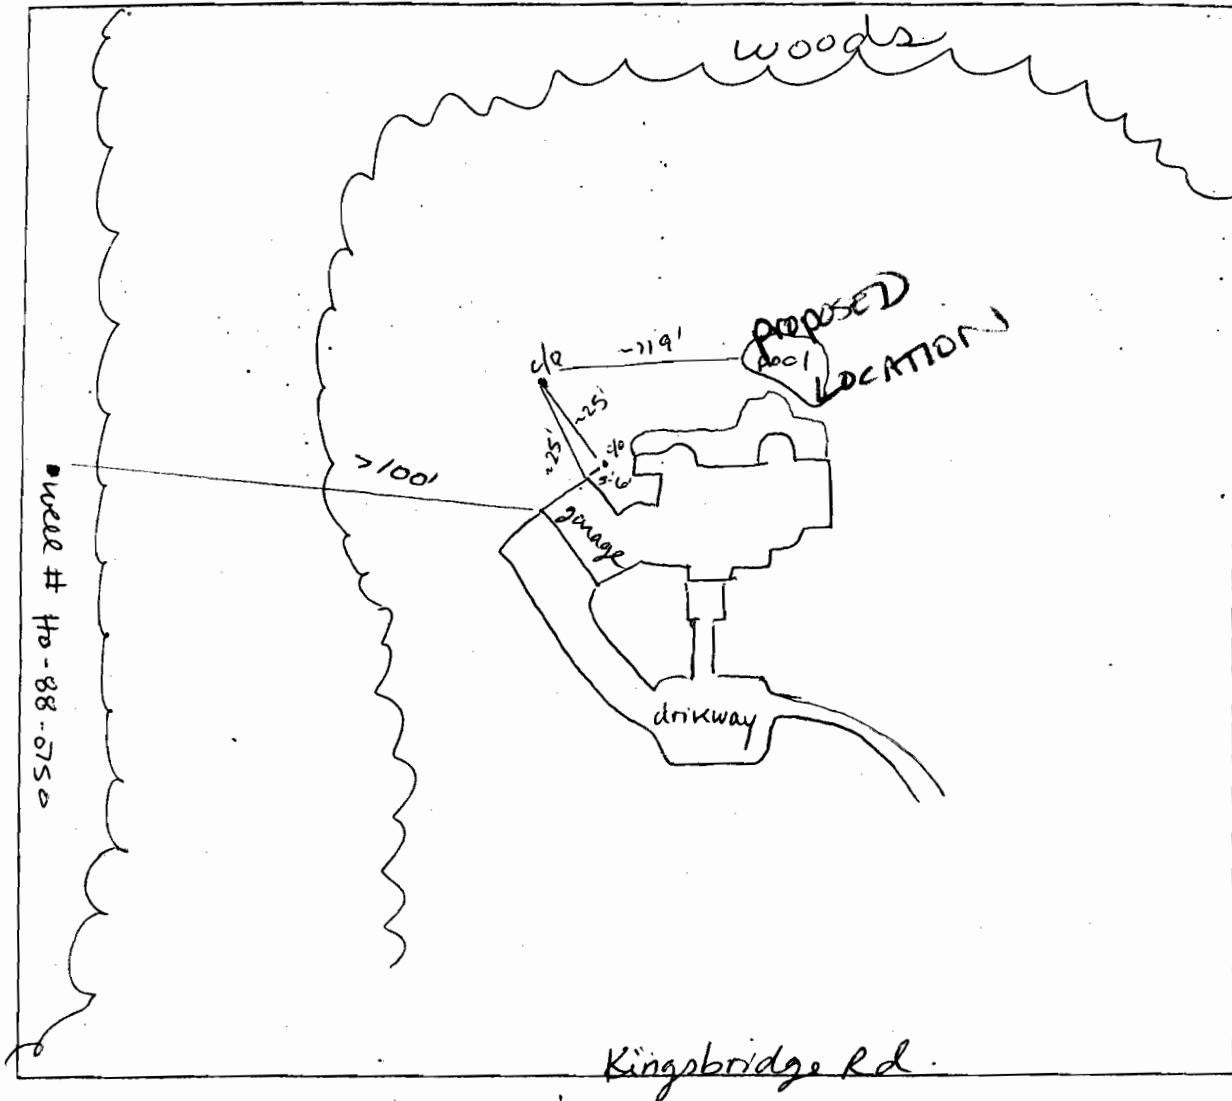

COMMENTS: Pool adequate distance away from septic and well. well located just along tree line ~ 8' above grade.  
1/3/06 KN Signs pool permit

DATE: 12/30/05

SF