


SITE INSPECTION SHEET

OWNER: Gupta PHONE #: 410-531-993
ADDRESS: 2824 Kings Gt Dr CONTRACTOR: _____
Ellicott City MD WELL TAG #: _____
SUBDIVISION: _____ LOT: _____ COUNTY #: A27244
PROPOSAL: Verifying location of septic tank and distance from
proposed deck area.

LOCATION DIAGRAM

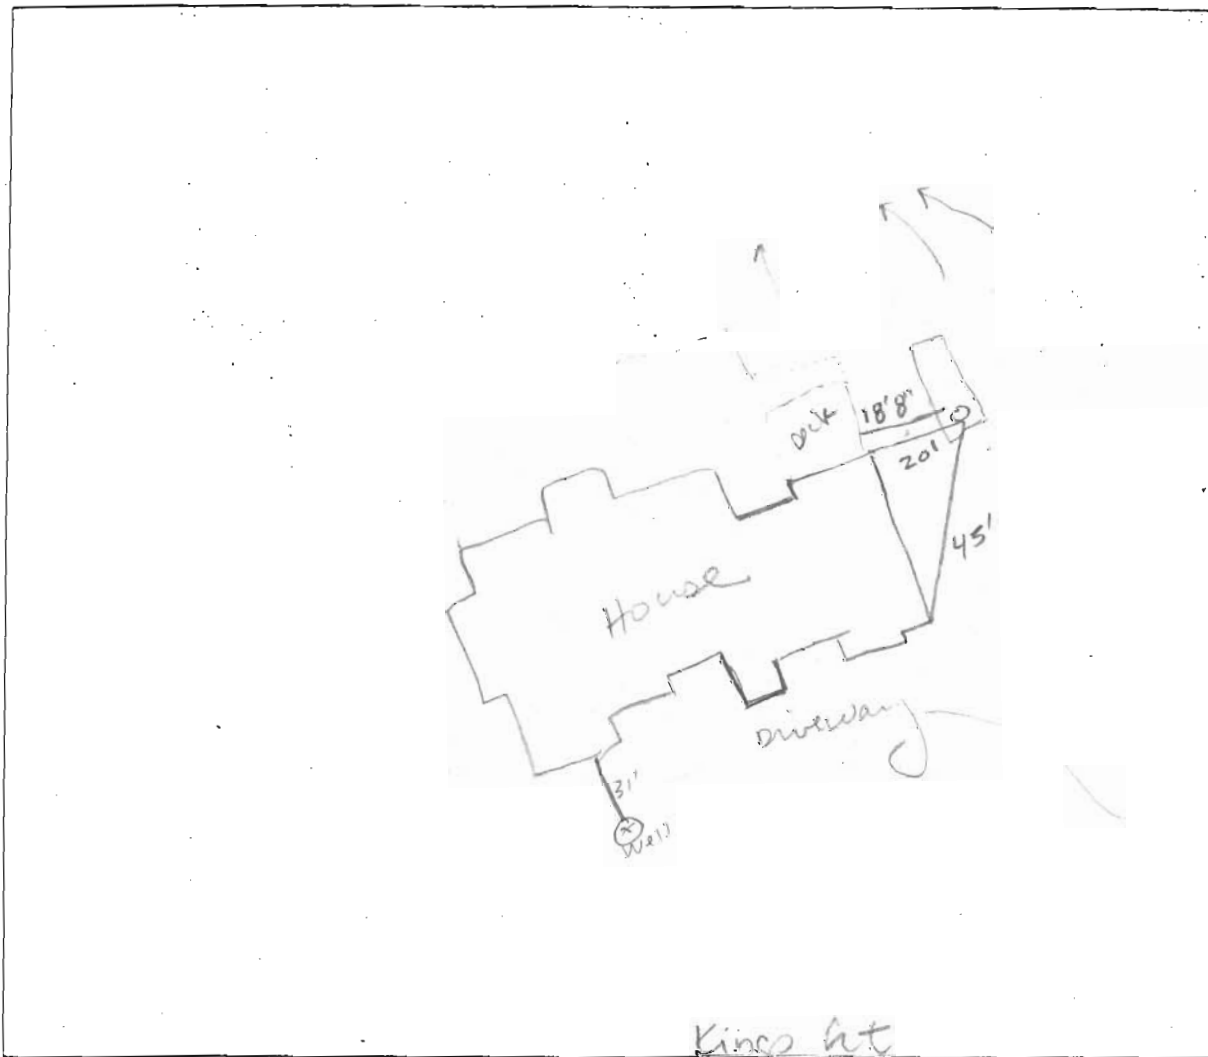

COMMENTS: Septic tank located a sufficient distance from
proposed deck area. Well found to be located as seen
on plan. Family uses public water but maintains well
of well for outdoor/garden purposes.

DATE: 5/13/05 INSPECTOR: SF


2824 Kingslet Rd

APPROVED
WALKER BUILDING PERMIT
APP# 100153126
DESC. OF WORK: 5/13/05

ACTUAL S.T. LOC

LOT 4

PROPOSED DECK 186.45 SQ. FT.
(24'9" x 71') + (6'5" x 17'0")

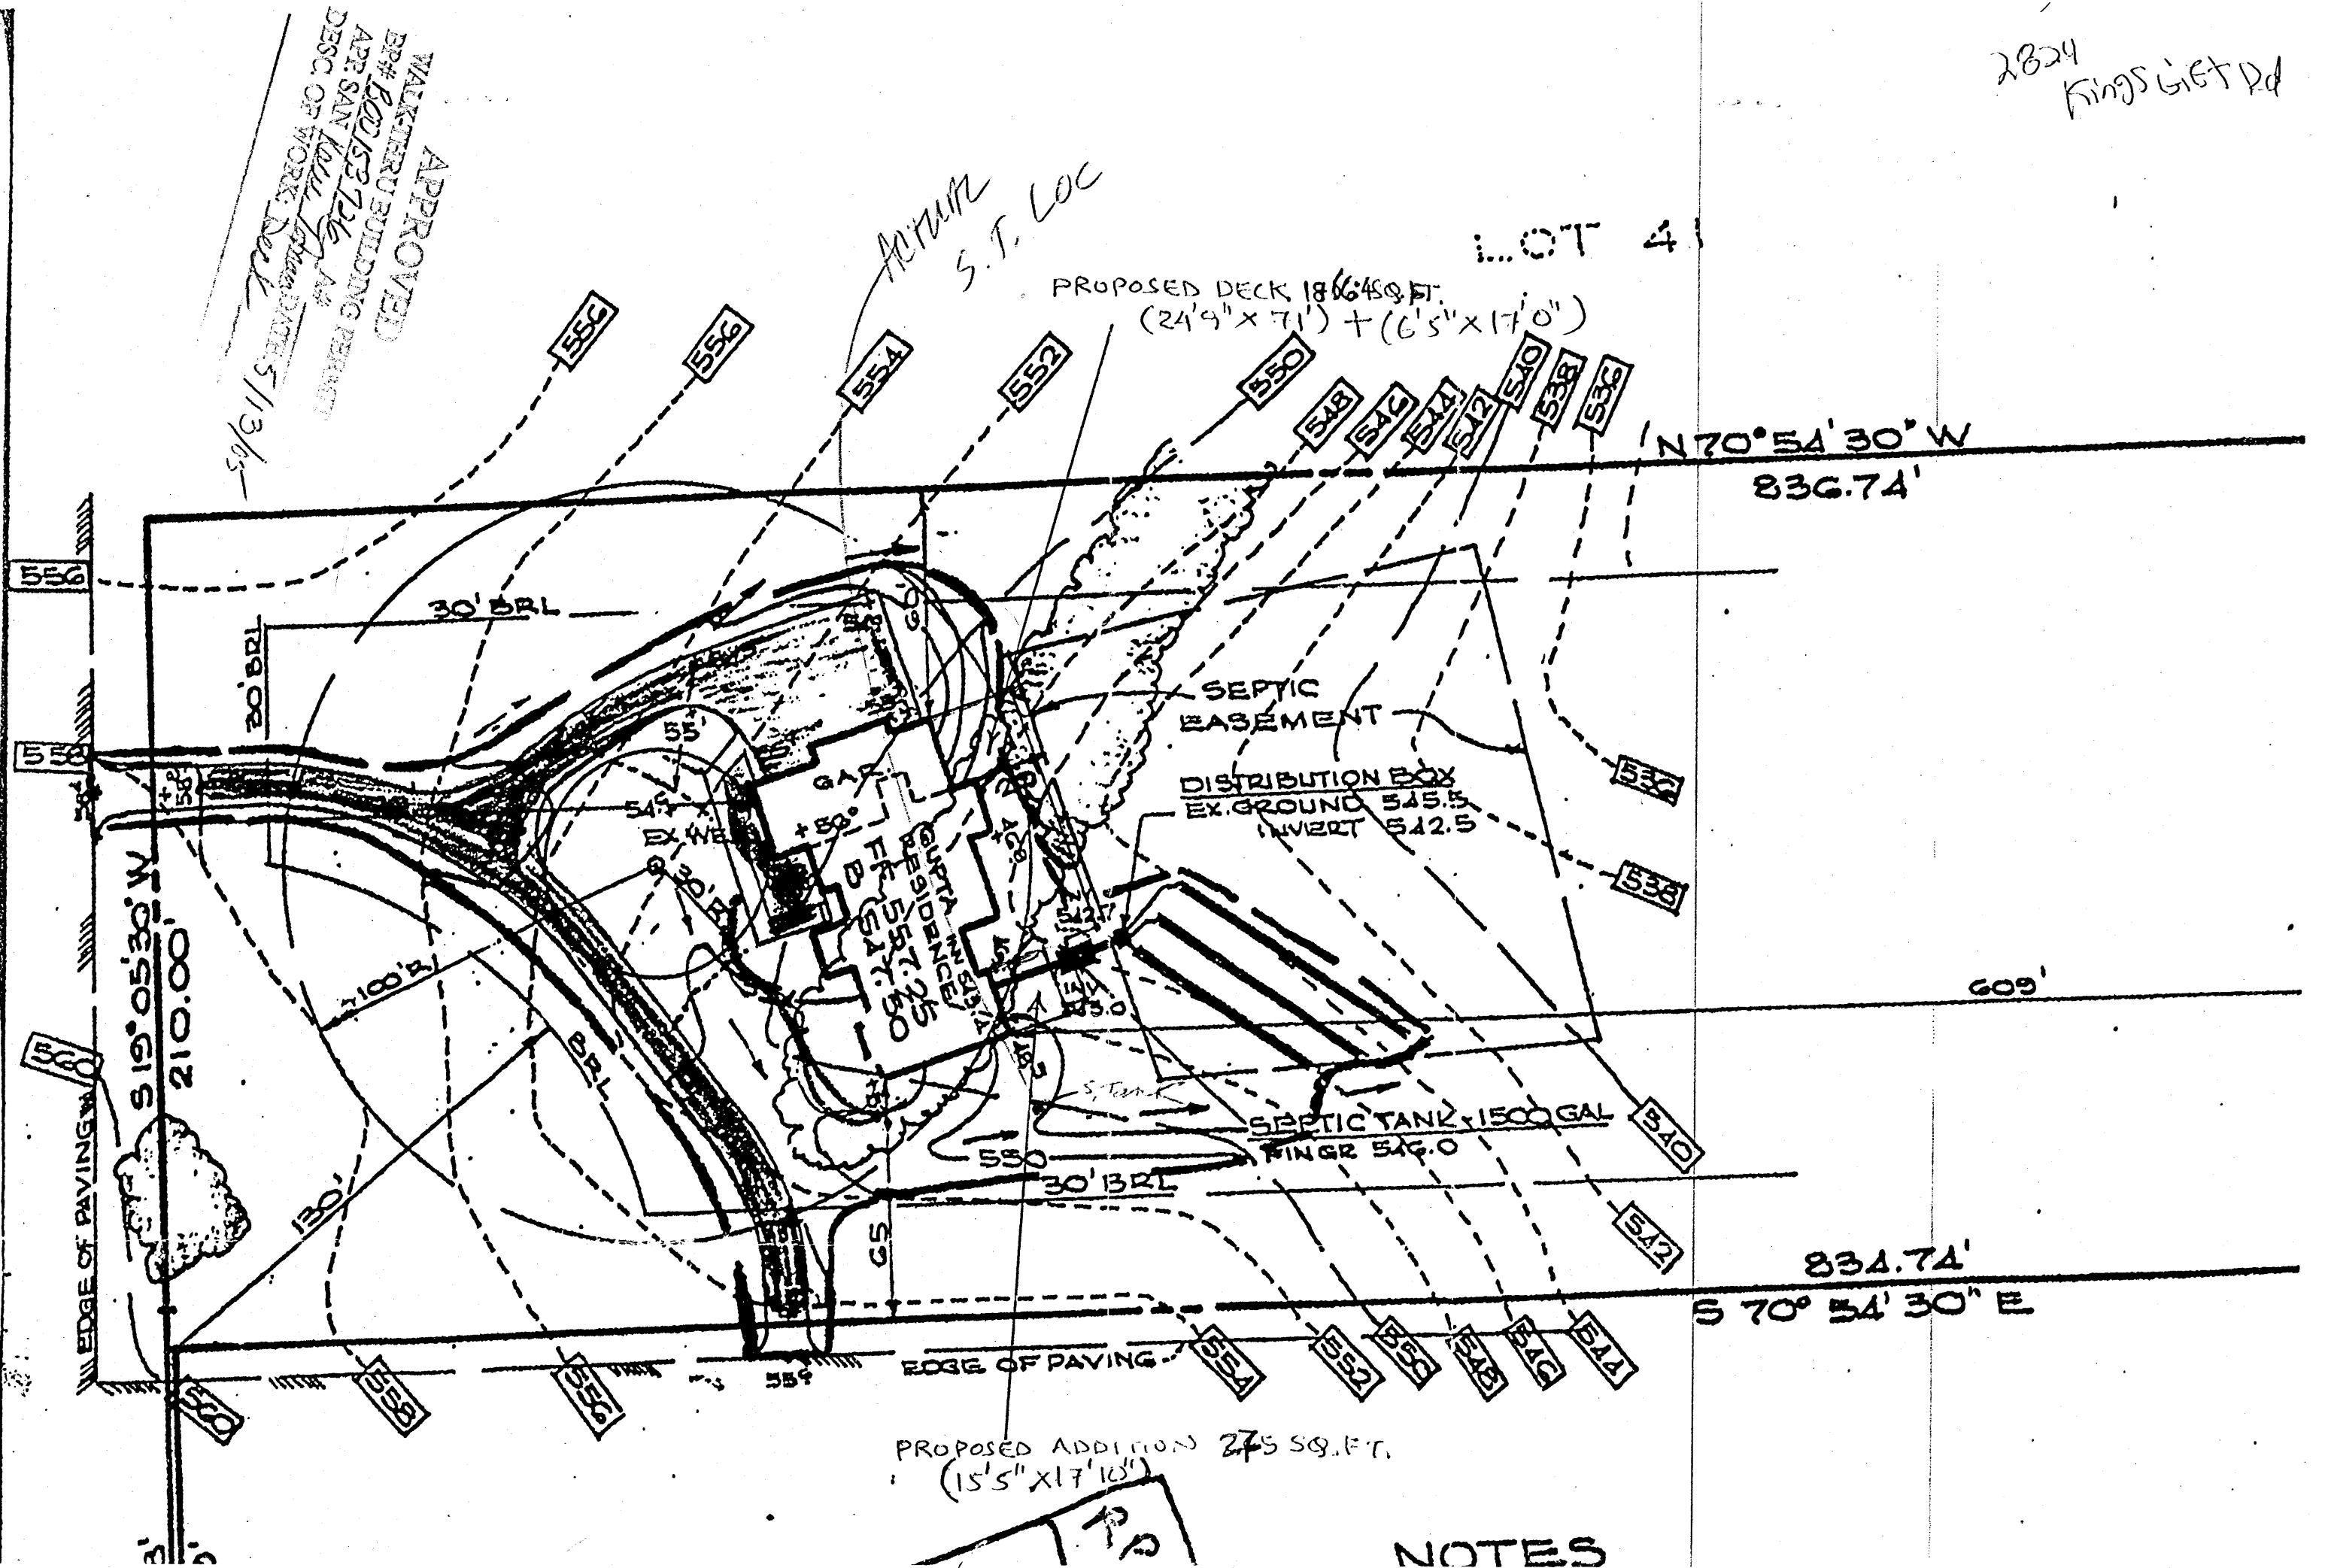

PROPOSED ADDITION 275 SQ. FT.
(15'5" x 17'10")

NOTES