

Per.

APPLICATION

SEWAGE DISPOSAL TESTING

STATE OF MARYLAND - DEPARTMENT OF HEALTH AND MENTAL HYGIENE

A 33489

P _____

HOWARD COUNTY HEALTH DEPARTMENT
ENVIRONMENTAL HEALTH SERVICES
P. O. BOX 476 ELLICOTT CITY, MARYLAND 21043
TELEPHONE: 992-2330

DISTRICT 5

DATE 1-30-84

TO: THE COUNTY HEALTH OFFICER
ELLICOTT CITY, MARYLAND

I, HEREBY, APPLY FOR THE NECESSARY TEST IN ORDER TO CONSTRUCT (OR RECONSTRUCT) A SEWAGE DISPOSAL SYSTEM.

PROPERTY OWNER ESTATE of CHARLES Ruppert ^{EXCUTOR & PARTOWNER} ANNA MAC CARTHY

ADDRESS 4100 CATHEDRAL AVE DC 20016 PHONE 202-363-2725

PROPERTY LOCATION:

SUBDIVISION Ruppert property LOT NO. 1

ROAD AND DESCRIPTION Nichols Dr. Nichols Dr

SIZE OF LOT 3 ac. 3 A. TYPE BLDG. SFD
(NUMBER OF BEDROOMS)

THE SYSTEM INSTALLED UNDER THIS APPLICATION IS ACCEPTABLE ONLY UNTIL PUBLIC FACILITIES BECOME AVAILABLE. I FULLY UNDERSTAND THE FEE CONNECTED WITH THE FILING OF THIS PERC TEST APPLICATION IS NON-REFUNDABLE UNDER ANY CIRCUMSTANCES. I ALSO AGREE TO COMPLY WITH ALL M.O.S.H.A. REQUIREMENTS IN TESTING THIS LOT. Richard W. Smith 465-0842
(SIGNATURE OF APPLICANT)

APPROVED BY _____ FOR _____ DATE _____

REJECTED BY CW FOR ANY DATE 3-9-84



HOLD PENDING FURTHER TESTS _____ DATE _____

REASONS FOR REJECTION OR HOLDING NO SUITABLE SOIL FOUND - POSSIBLY COULD BE COMBINED

WITH OTHER FAILED LOT & FURTHER TESTING WOULD BE REQUIRED. 3-9-84 CW

4-19-85 PERC UNSATISFACTORY; WATER + CLAY PROBLEMS; INSUFFICIENT AREA REMAINING TO TEST. S.A.M.

THIS IS NOT A PERMIT

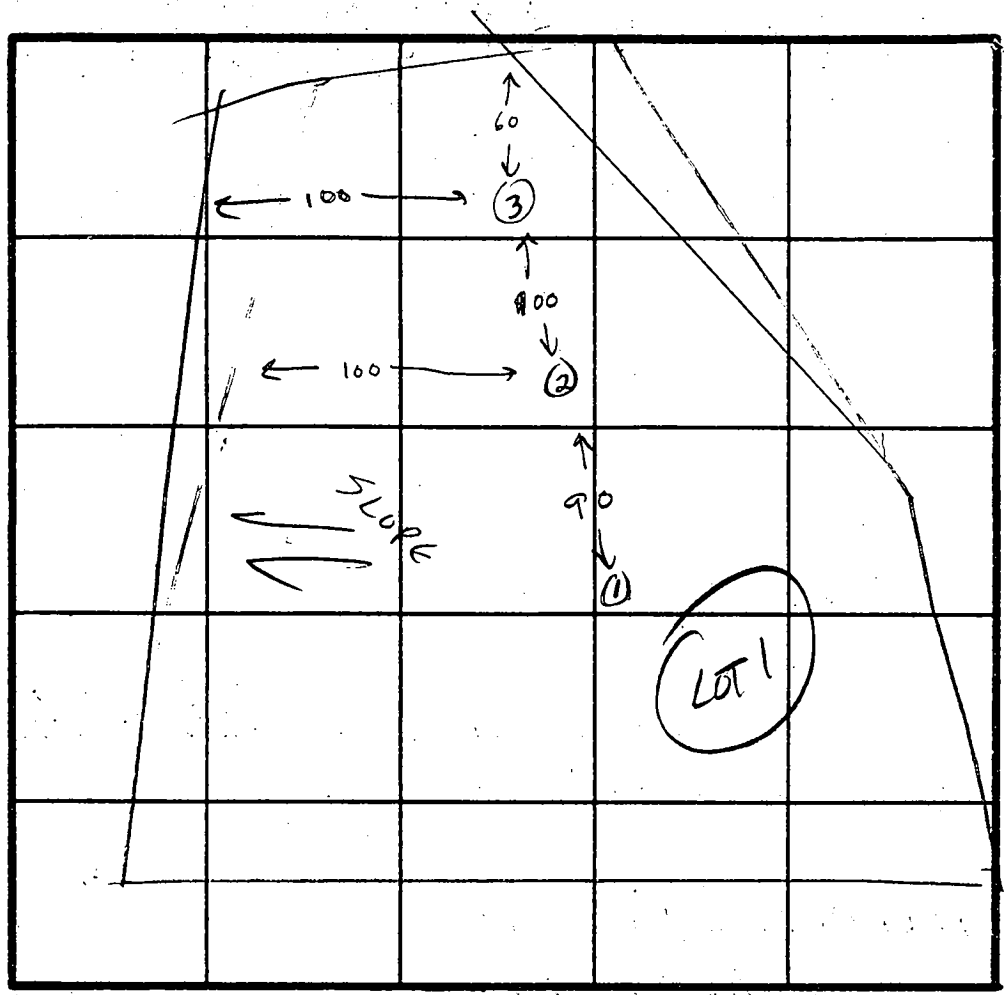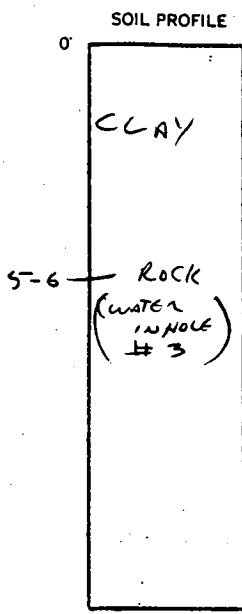

INDICATE NORTH - NAME ADJOINING ROADWAY AS BASE LINE.

DATE	TEST NO.	DEPTH	PRE-WET		TEST - 1" DROP		TIME
			START	STOP	START	STOP	
3-9-84	1.	6'	CLAY, WATER AT 6'				
3-9-84	2	6'	CLAY, ROCK AT 6'				
3-9-84	3	5'	CLAY, ROCK AT 5'				

REMARKS NOT SUITABLE AS PRESENTLY PROPOSED; POSSIBLY MAY BE COMBINED WITH LOT 48

TYPE OF SOIL CLAY, ROCK

TESTED BY William

ALSO PRESENT DEMMET

EH-12-1079

APPLICATION

SEWAGE DISPOSAL TESTING

STATE OF MARYLAND - DEPARTMENT OF HEALTH AND MENTAL HYGIENE

A 33489

P _____

HOWARD COUNTY HEALTH DEPARTMENT
ENVIRONMENTAL HEALTH SERVICES
P. O. BOX 476 ELLICOTT CITY, MARYLAND 21043
TELEPHONE: 992-2330

DISTRICT 5

DATE 1-30-84

TO: THE COUNTY HEALTH OFFICER
ELLICOTT CITY, MARYLAND

I, HEREBY, APPLY FOR THE NECESSARY TEST IN ORDER TO CONSTRUCT (OR RECONSTRUCT) A SEWAGE DISPOSAL SYSTEM.

PROPERTY OWNER ESTATE of CHARLES RUPPERT ^{EXCELLENCE & PARTNERSHIP} ANNA MACCARTHY
ADDRESS 4100 CATHEDRAL AVE DC 20016 PHONE 202-363-2725

PROPERTY LOCATION:

SUBDIVISION Ruppert property LOT NO. 1
ROAD AND DESCRIPTION Nichols Dr.

SIZE OF LOT 3 A TYPE BLDG. SFD
(NUMBER OF BEDROOMS)

THE SYSTEM INSTALLED UNDER THIS APPLICATION IS ACCEPTABLE ONLY UNTIL PUBLIC FACILITIES BECOME AVAILABLE. I FULLY UNDERSTAND THE FEE CONNECTED WITH THE FILING OF THIS PERC TEST APPLICATION IS NON-REFUNDABLE UNDER ANY CIRCUMSTANCES. I ALSO AGREE TO COMPLY WITH ALL M.O.S.H.A. REQUIREMENTS IN TESTING THIS LOT.

Richard Hammett 465-0842
(SIGNATURE OF APPLICANT)

APPROVED BY _____ FOR _____ DATE _____

REJECTED BY _____ FOR _____ DATE _____



HOLD PENDING FURTHER TESTS _____ DATE _____

REASONS FOR REJECTION OR HOLDING _____

THIS IS NOT A PERMIT

STATION

SOIL PROFILE

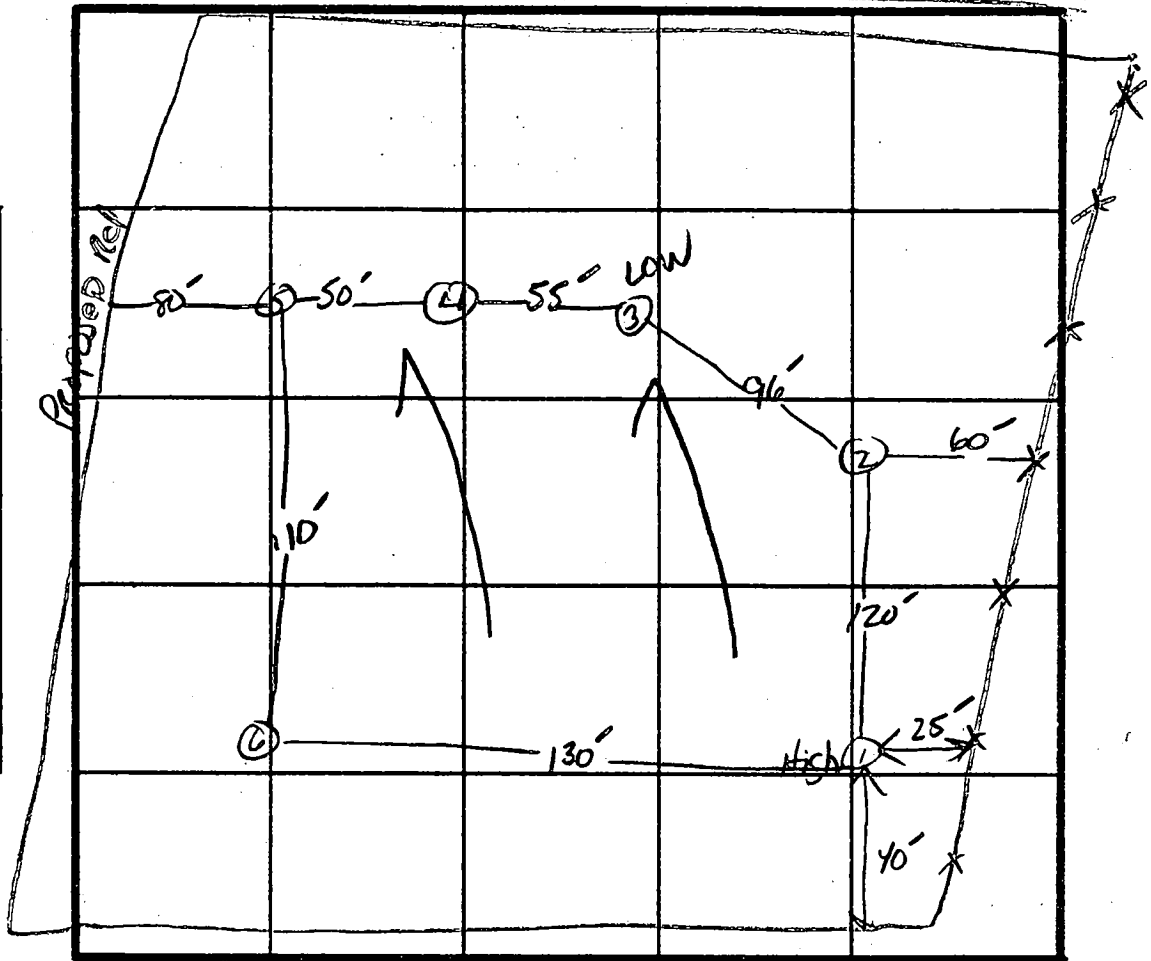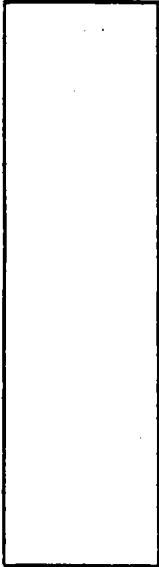

INDICATE NORTH - NAME ADJOINING ROADWAY AS BASE LINE.
Nicholes Dr.

DATE	TEST NO.	DEPTH	PRE-WET		TEST - 1" DROP		TIME
			START	STOP	START	STOP	
4/19/85	1V	WATER AT 9" CLAY 6"					
	2V	WATER AT 7" CLAY 5"					
	3V	WATER AT 3" CLAY 3"					
	4V	WATER AT 3" CLAY 3"					
	5V	WATER AT 4" CLAY 3.5"					
	6V	WATER AT 7" CLAY TO 4.5"					

REMARKS _____

TYPE OF SOIL _____

TESTED BY _____ ALSO PRESENT _____

EH-12-1079