

COUNTY #

SOIL PROFILE


0' 203
 Str Brn HL
 2' Reddish Brn
 Mic L-L (2FSbk)
 4' Reddish Brn
 Str Brn
 Mic L (Massive)
 19 1/2'

204

8" Topsoil LL
 Red-yellow
 C-CL (2-3 Sbk)
 4 1/2' Brn-red Brn
 Mic L (Massive)
 14'

202

11' Mic Brn L
 Mic Brn
 Mic L (2FSbk)
 Mic Brn
 Mic L-SL (Massive)
 7' Artificial
 Wood
 Structural
 Floor
 14'

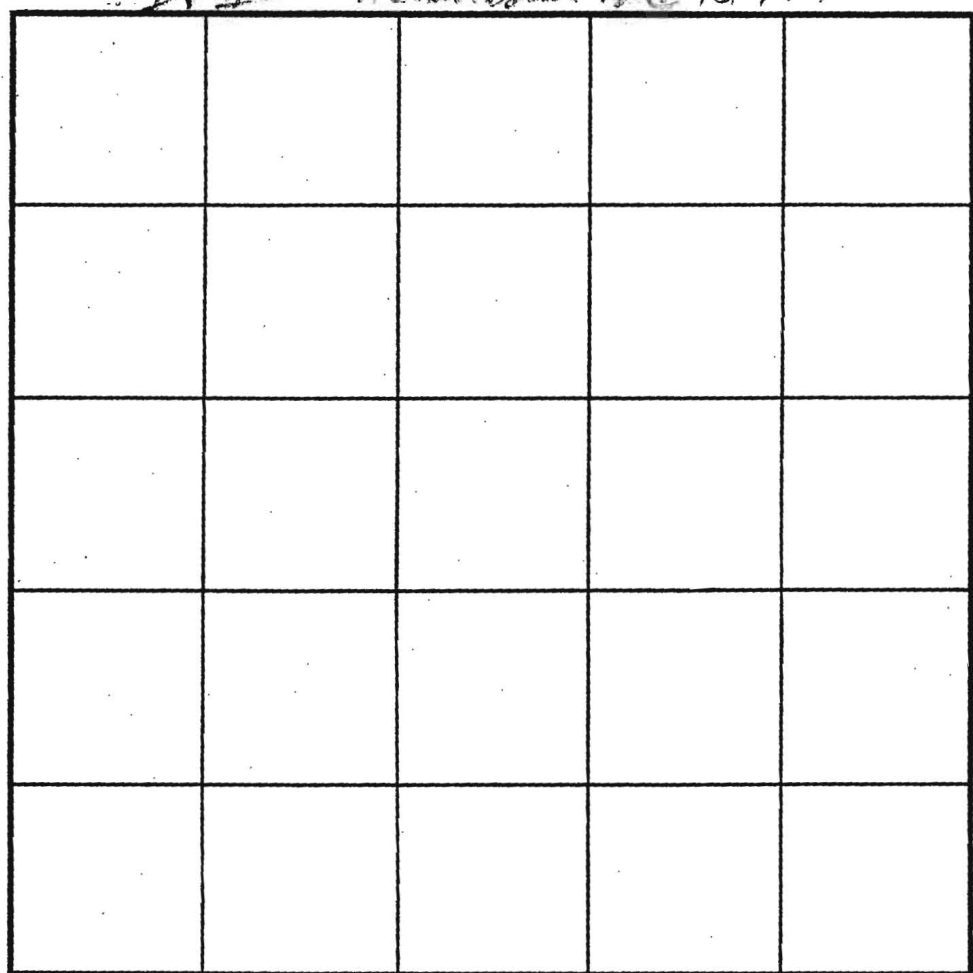

INDICATE NORTH - NAME ADJOINING ROADWAY AS BASE LINE.

SOIL PROFILE






0' 205
 10' yel Red-yel
 SCL LL
 2' Mic Brn
 Mic L (Massive)
 5 1/2' mic Brn
 Mic L (Massive)
 8 1/2' mic Brn
 Mic L (Massive)
 12' mic Brn
 Mic L (Massive)
 14'

206

4 1/2' Red Brn L
 Red L-Red
 3' Red Brn
 Mic L (Massive)
 5-6' Brn
 Mic L (Massive)
 13'

DATE	TEST NO.	DEPTH	PRE-WET		TEST - 1" DROP		TIME		
			START	STOP	START	STOP			
9/24/01	203	12 1/2'	10:51:00	10:53:40	10:53:40	10:57:40	4 min	OK	
	204	14'	11:09:40	11:11:20	11:11:20	11:15:10	4 min	OK	
	202	14'	11:19:30	Measured		11:21:40	2 min	OK	
	205	14'	11:26:00	11:28		11:30:10	2 min	X	
	201	stopped @ 8'	good Mic soils but too close to #17 to test						OK
	206	13'	11:58:40	12:00:40	12:00:40	12:06:20	5 1/2 min	OK	

REMARKS Test holes for center is in bottom of R configured SCL A's.
 TYPE OF SOIL Mixture of clays.
 TESTED BY RJP ALSO PRESENT _____
 TRENCH DESIGN DATA: AVERAGE PERCOLATION TIME _____ TRENCH WIDTH _____
 INLET DEPTH _____ MAXIMUM BOTTOM DEPTH _____ SQ. FT/BEDROOM _____

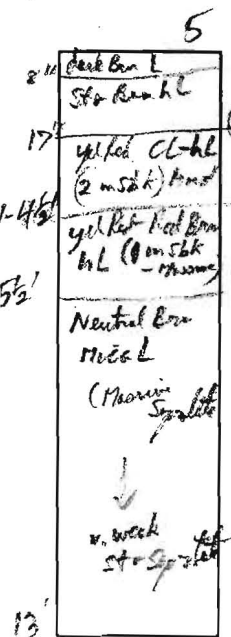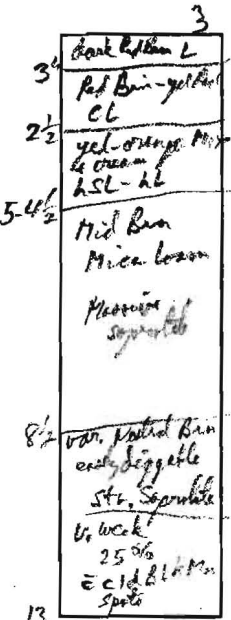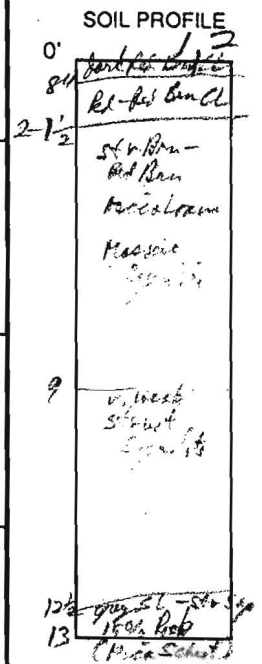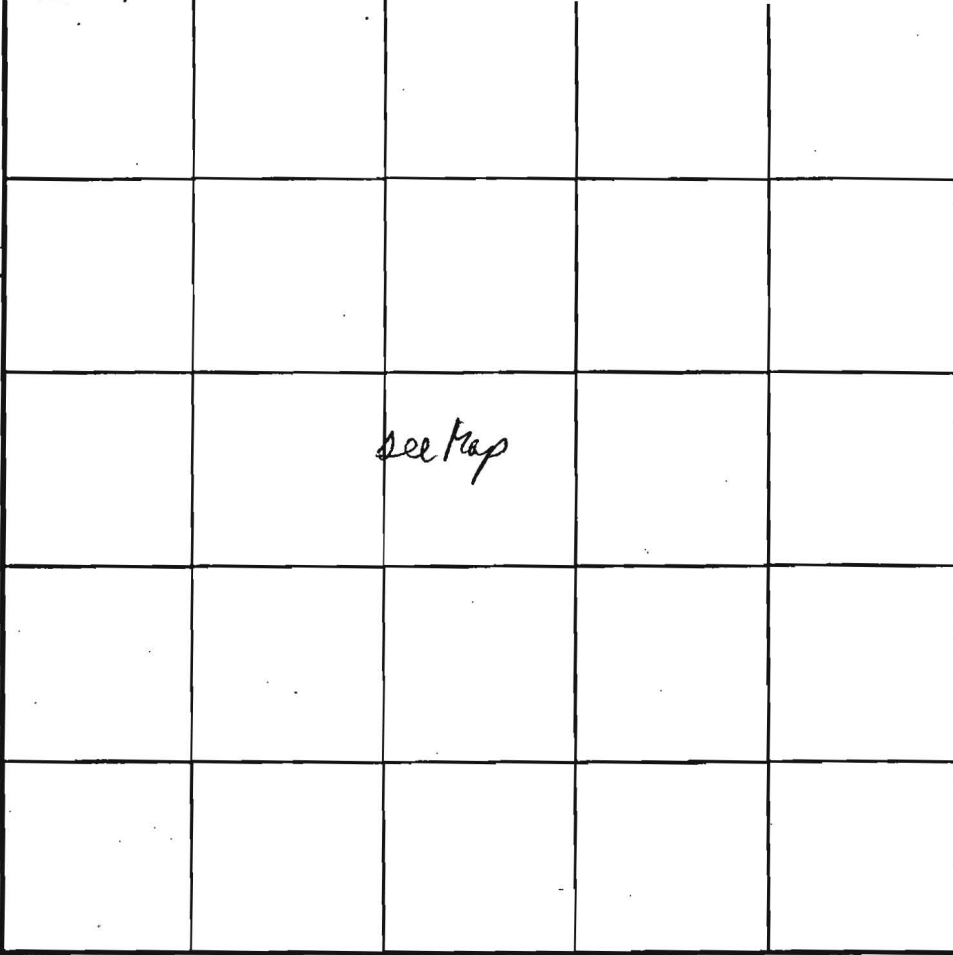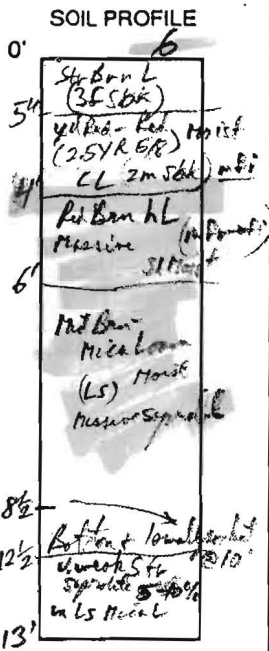

INDICATE NORTH - NAME ADJOINING ROADWAY AS BASE LINE.

DATE	TEST NO.	DEPTH	PRE-WET		TEST - 1" DROP		TIME	
			START	STOP	START	STOP		
10/16/50	6	13' 3 1/2"	1:05	1:22:00	1:27:00	1:40	20 min	OK
	3	13' 3'	1:15:00	1:22:00	1:22:00	1:39	17 min	OK
	5	13' 4 1/2"	1:26:00	1:36:00	1:36:00	1:53:00	17 min	OK
	2	13' 3'	1:43:00	1:45	1:45	1:48:00	3 min	OK
	1	13' 3'	1:57:30	2:03:00	2:03:00	2:17:00	14 min	OK


REMARKS _____

TYPE OF SOIL Shandy

TESTED BY Phillips ALSO PRESENT _____

TRENCH DESIGN DATA: AVERAGE PERCOLATION TIME _____ TRENCH WIDTH _____

INLET DEPTH _____ MAXIMUM BOTTOM DEPTH _____ SQ. FT/BEDROOM _____

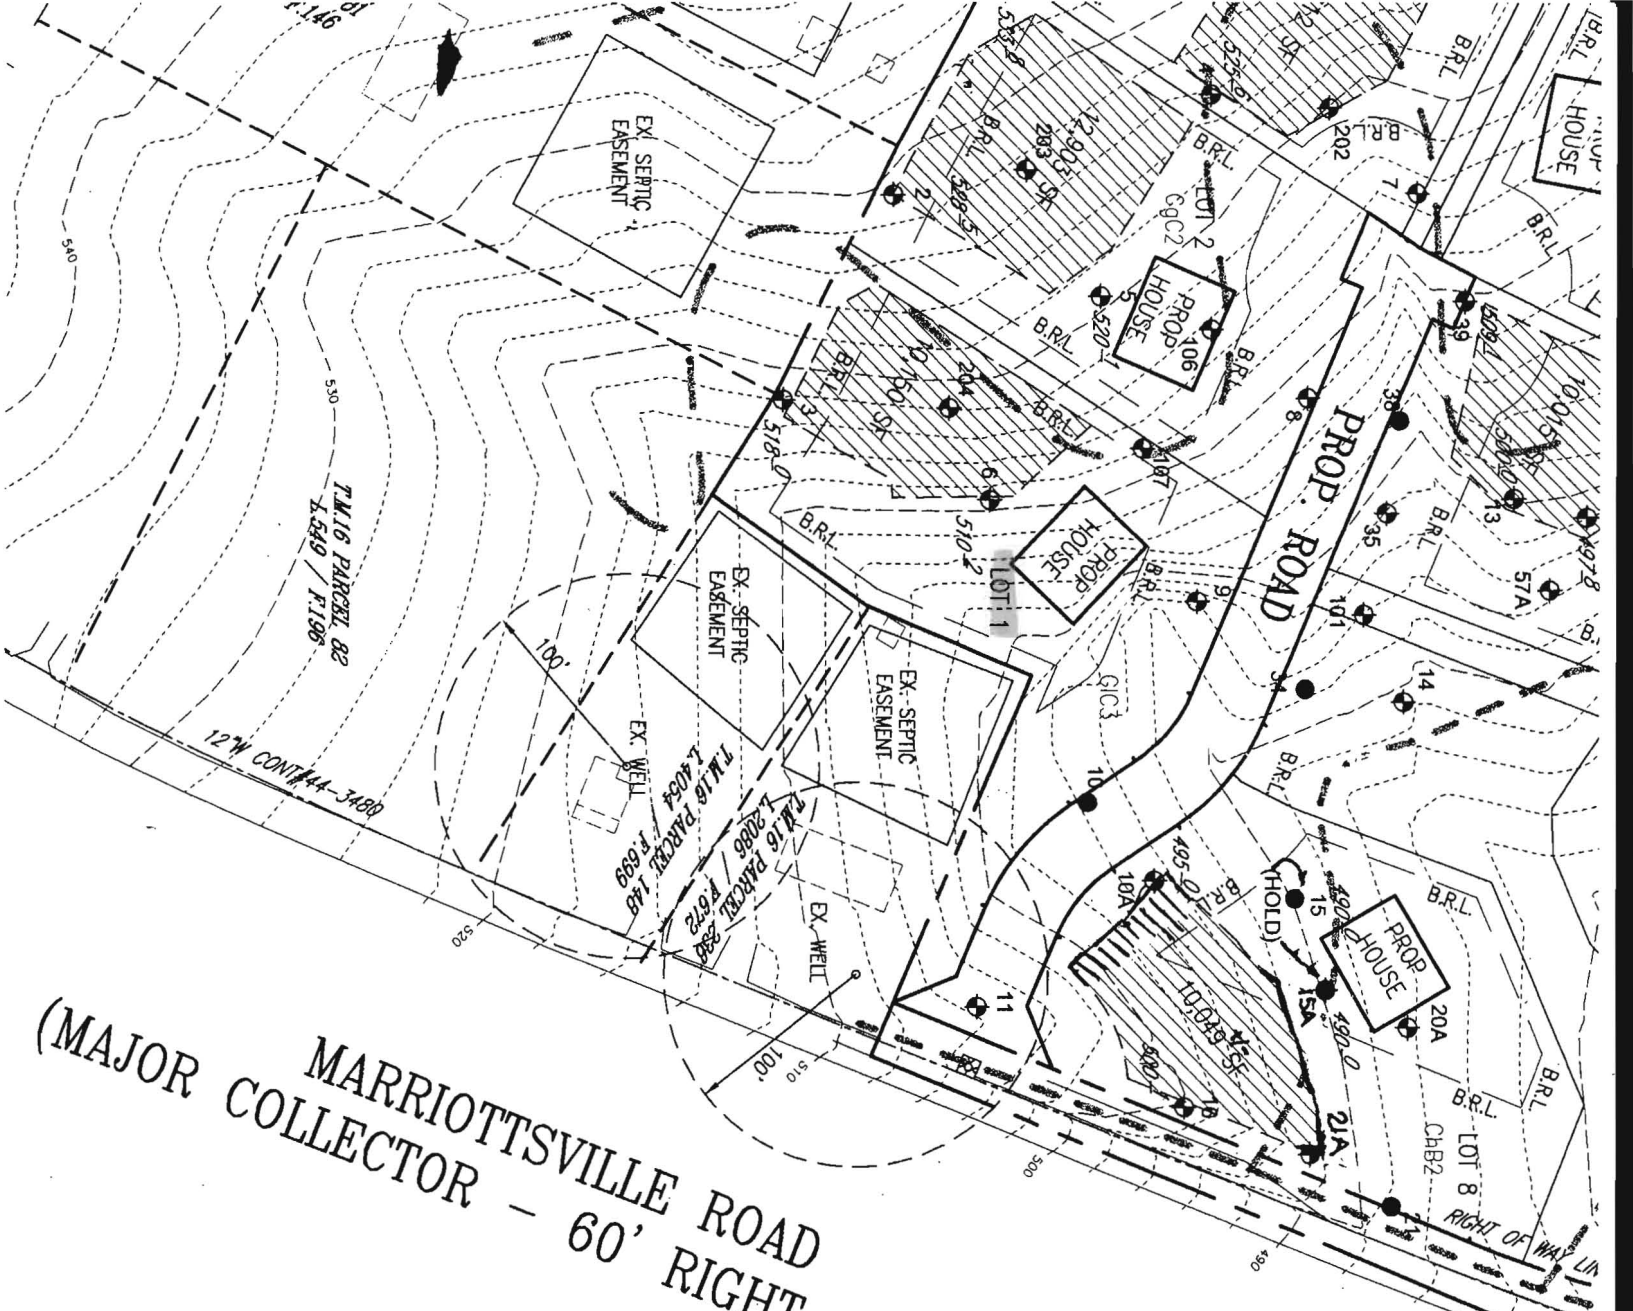

MARRIOTTSVILLE ROAD
 (MAJOR COLLECTOR - 60' RIGHT-OF-WAY)

perc cert signed
 11-20-02