

Pre.

APPLICATION

SEWAGE DISPOSAL TESTING

STATE OF MARYLAND - DEPARTMENT OF HEALTH AND MENTAL HYGIENE

A 33535
P _____

HOWARD COUNTY HEALTH DEPARTMENT
ENVIRONMENTAL HEALTH SERVICES

P. O. BOX 476 ELLICOTT CITY, MARYLAND 21043
TELEPHONE: 992-2330

DISTRICT _____

DATE 1-30-84

TO: THE COUNTY HEALTH OFFICER
ELLICOTT CITY, MARYLAND

I, HEREBY, APPLY FOR THE NECESSARY TEST IN ORDER TO CONSTRUCT (OR RECONSTRUCT) A SEWAGE DISPOSAL SYSTEM.

PROPERTY OWNER ANNA MacCortney Dennis MATHEW

ADDRESS 4100 Cathedral Ave DC 20016 PHONE 202-363-2725

PROPERTY LOCATION: BRIGHTON PINES I
SUBDIVISION Propert Prop LOT NO. 21 46

ROAD AND DESCRIPTION NICHOLS DR. (13713 Lakeside Drive)

SIZE OF LOT 3A **BLDG. PERMIT 5101**
AND RETURNED 8-31-98
Serial # 610113828
4 Bdrms. TYPE BLDG. S.F.D.
(NUMBER OF BEDROOMS)

THE SYSTEM INSTALLED UNDER THIS APPLICATION IS ACCEPTABLE ONLY UNTIL PUBLIC FACILITIES BECOME AVAILABLE. I FULLY UNDERSTAND THE FEE CONNECTED WITH THE FILING OF THIS PERC TEST APPLICATION IS NON-REFUNDABLE UNDER ANY CIRCUMSTANCES. I ALSO AGREE TO COMPLY WITH ALL M.O.S.H.A. REQUIREMENTS IN TESTING THIS LOT.

Richard J. ...
(SIGNATURE OF APPLICANT) 465-0842


APPROVED BY C. Wilson FOR TRENCHES DATE 2-8-84

REJECTED BY _____ FOR _____ DATE _____

HOLD PENDING FURTHER TESTS _____ DATE _____

REASONS FOR REJECTION OR HOLDING _____

THIS IS NOT A PERMIT

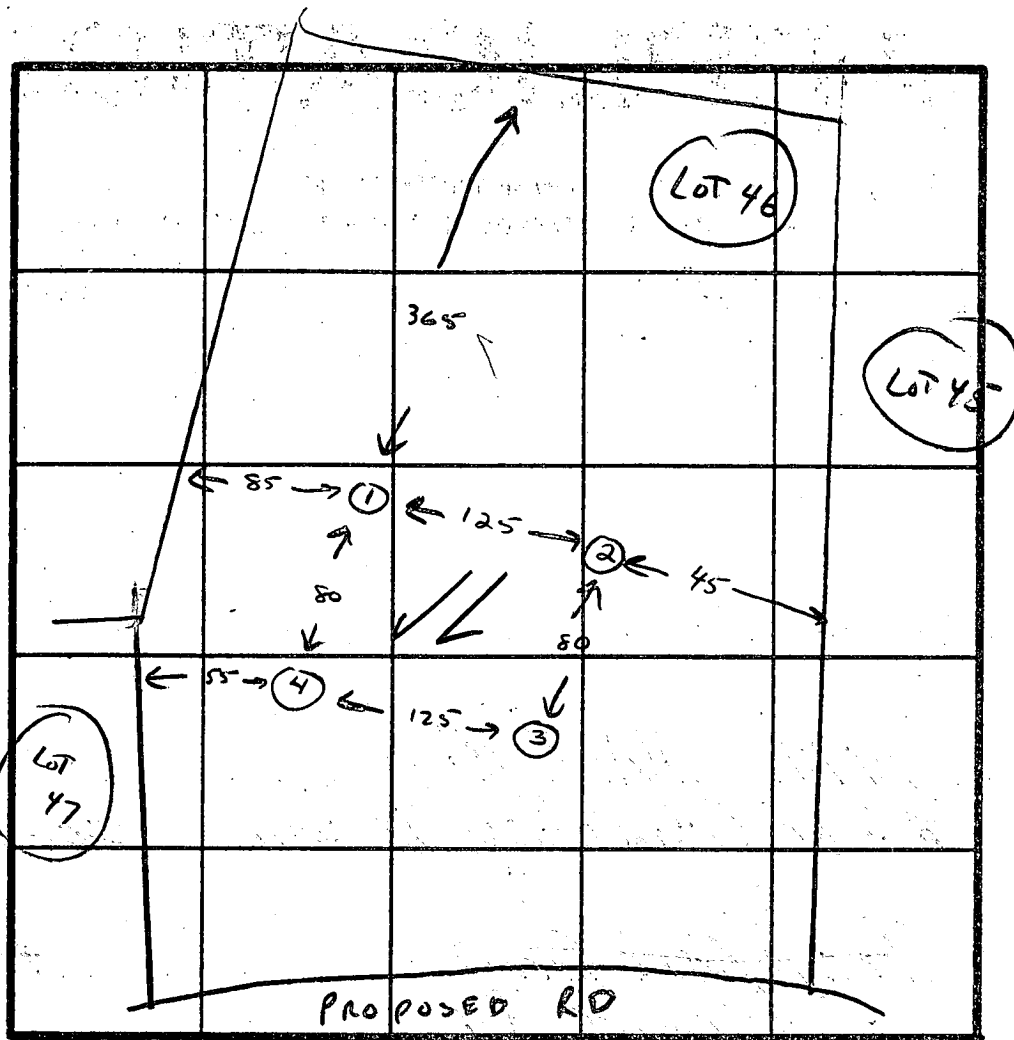

DATE	TEST NO.	DEPTH	PRE-WET		TEST - 1" DROP		TIME
			START	STOP	START	STOP	
2-7-84	1	4	10:59	11:01	11:01	11:03	2 MIN
		8	10:59	11:01	11:01	11:03	2 MIN
		12	SANDY				
2-7-84	2	4	10:52	10:55	10:55	11:02	7
		8	10:52	10:54	10:54	10:57	3 MIN
		12	SANDY				
2-7-84	3	4 1/2	11:04	11:15	11:15	11:28	13 MIN
		8	11:05	11:09	11:09	11:17	9 MIN
		12	SANDY				
2-7-84	4	12	VERY SANDY BELOW 4'				

REMARKS PERC FIELD SAME AS PLAT

TYPE OF SOIL 3-4' CLAY THEN SAND & MICA

TESTED BY C. Williams

ALSO PRESENT DOMMIT, CISSEC