

LAYOUT _____ INSP 4 _____
INSP 2 _____ INSP 5 _____
INSP 3 _____ INSP 6 _____

ISSUE DATE: 1/17/07

APPROVAL DATE: _____

PERMIT

P 526188

A 33535

ON-SITE SEWAGE DISPOSAL SYSTEM HOWARD COUNTY HEALTH DEPARTMENT BUREAU OF ENVIRONMENTAL HEALTH

Dennis Matthey IS PERMITTED TO INSTALL ALTER

ADDRESS: 13713 Lake^{side} Dr. PHONE NUMBER: (443)375-7983

SUBDIVISION: Brighton Pines LOT NUMBER: 21

ADDRESS: 13713 Lake^{side} Dr. PROPERTY OWNER: Dennis Matthey

SEPTIC TANK CAPACITY (GALLONS): Existing OUTLET BAFFLE FILTER REQUIRED

PUMP CHAMBER CAPACITY (GALLONS): N/A COMPARTMENTED TANK REQUIRED

NUMBER OF BEDROOMS: 1

SQUARE FEET PER BEDROOM: 1

LINEAR FEET OF TRENCH REQUIRED: 1

TRENCHES:	Trench to be _____ feet wide. Inlet _____ feet below original grade. Bottom maximum depth _____ feet below original grade. Effective area begins at _____ feet below original grade. _____ feet of stone below distribution pipe.
LOCATION:	Install external plumbing for Water and Sewer hook-ups to from the existing house to the new detached garage to allow hand sink and possible future bathroom.
NOTES:	Water line shall be fully sleeved and sealed where within 10 feet of Sewer line. It is preferred that the water line be plumbed at a depth 1 foot shallower than the sewer line. Contractor responsible for open trench inspection at the time of installation.

PLANS APPROVED: Gabriel A. Creighton DATE: 1/17/07

- NOTE: PERMIT VOID AFTER 2 YEARS
- NOTE: CONTRACTOR RESPONSIBLE FOR SCHEDULING A PRE-CONSTRUCTION INSPECTION FOR ALL INSTALLATIONS
- NOTE: WATERTIGHT SEPTIC TANKS REQUIRED
- NOTE: ALL PARTS OF SEPTIC SYSTEM SHALL BE 100 FEET FROM ANY WATER WELL
- NOTE: MANHOLE RISERS REQUIRED ON ALL SEPTIC TANKS AND PUMP CHAMBERS UNLESS SPECIFICALLY AUTHORIZED


**NEITHER THE HOWARD COUNTY COUNCIL NOR THE HEALTH DEPARTMENT IS
RESPONSIBLE FOR THE SUCCESSFUL OPERATION OF ANY SYSTEM
PERMITTEE RESPONSIBLE FOR OBTAINING FINAL APPROVAL ON THIS PERMIT
CALL 410-313-~~2640~~ FOR INSPECTION OF SEPTIC SYSTEM**

1771

[Handwritten signature]

[Handwritten signature]

NOT TO SCALE

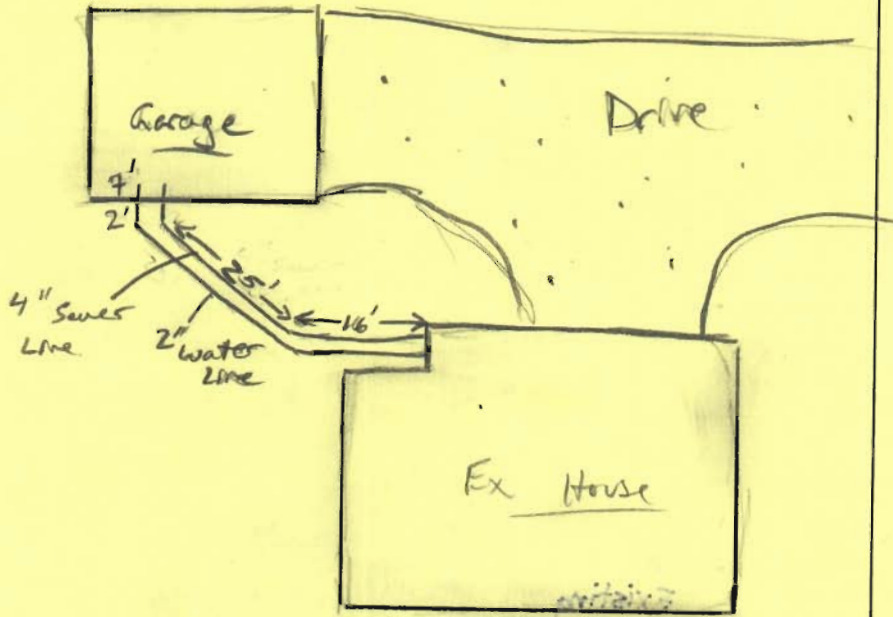

TRENCH/DRAINFIELD DATA

WIDTH	INLET	BOTTOM
_____	_____	_____
NUMBER OF TRENCHES _____		
TOTAL LENGTH _____		
ABSORPTION AREA _____		
DISTRIBUTION BOX LEVEL _____		
DISTRIBUTION BOX BAFFLE _____		
DISTRIBUTION BOX PORT _____		

SEPTIC TANK DATA

SEPTIC TANK 1 LEVEL _____

CAPACITY _____ GAL

SEAM LOC _____

TANK LID DEPTH _____

BAFFLES _____

BAFFLE FILTER _____

MANHOLE LOC _____

6" PORT LOC _____

WATERTIGHT TEST _____

SEPTIC TANK 2 LEVEL _____

CAPACITY _____ GAL

SEAM LOC _____

TANK LID DEPTH _____

BAFFLES _____

BAFFLE FILTER _____

MANHOLE LOC _____

6" PORT LOC _____

WATERTIGHT TEST _____

PRE-CONSTRUCTION _____

INSTALLATION 1/30/07 Stubbed sewer and water line connection only below grade into garage. Nothing else completed. (KW)

4/10/07 Water and sewer line installed to garage and house. OK to cover (KW)

FINAL INSPECTOR

John A. G... for Kevin Wolf

DATE OF APPROVAL

4/10/2007