

PUB. SEWER STATUS VERIFIED BY _____

ISSUE DATE: 11/22/11

PERMIT

P 536042

APPROVAL DATE: 12/5/2011

A REPAIR

Septic Repair 4337026

**ON-SITE SEWAGE DISPOSAL SYSTEM
HOWARD COUNTY HEALTH DEPARTMENT
BUREAU OF ENVIRONMENTAL HEALTH**

J.M. Contracting LLC. IS PERMITTED TO INSTALL ALTER

ADDRESS: 425 Obrecht Road Sykesville, MD 21784 PHONE NUMBER: 443-277-7526

SUBDIVISION: Warfield Estates LOT NUMBER: 27

ADDRESS: 14597 MacClintock Drive PROPERTY OWNER: Fred Keville

SEPTIC TANK CAPACITY (GALLONS): N/A

Two 86' Trenches

PUMP CHAMBER CAPACITY (GALLONS): _____

3' Wide

NUMBER OF BEDROOMS: _____

Inlet 5'

SQUARE FEET OF HOUSE: _____

Bottom 7'

LINEAR FEET OF TRENCH REQUIRED: 172'

TRENCHES:	
LOCATION:	
PURPOSE:	


PLANS APPROVED: _____ DATE: _____

- NOTE: PERMIT VOID AFTER 2 YEARS
- NOTE: CONTRACTOR RESPONSIBLE FOR SCHEDULING A PRE-CONSTRUCTION INSPECTION FOR ALL INSTALLATIONS
- NOTE: WATERTIGHT SEPTIC TANKS REQUIRED
- NOTE: ALL PARTS OF SEPTIC SYSTEM SHALL BE 100 FEET FROM ANY WATER WELL
- NOTE: MANHOLE RISERS REQUIRED ON ALL SEPTIC TANKS AND PUMP CHAMBERS

**NEITHER THE HOWARD COUNTY COUNCIL OR THE HEALTH DEPARTMENT IS
RESPONSIBLE FOR THE SUCCESSFUL OPERATION OF ANY SYSTEM
PERMITTEE RESPONSIBLE FOR OBTAINING FINAL APPROVAL ON THIS PERMIT
CALL 410-313-1771 FOR INSPECTION OF SEPTIC SYSTEM**

HO-73-3141

NOT TO SCALE

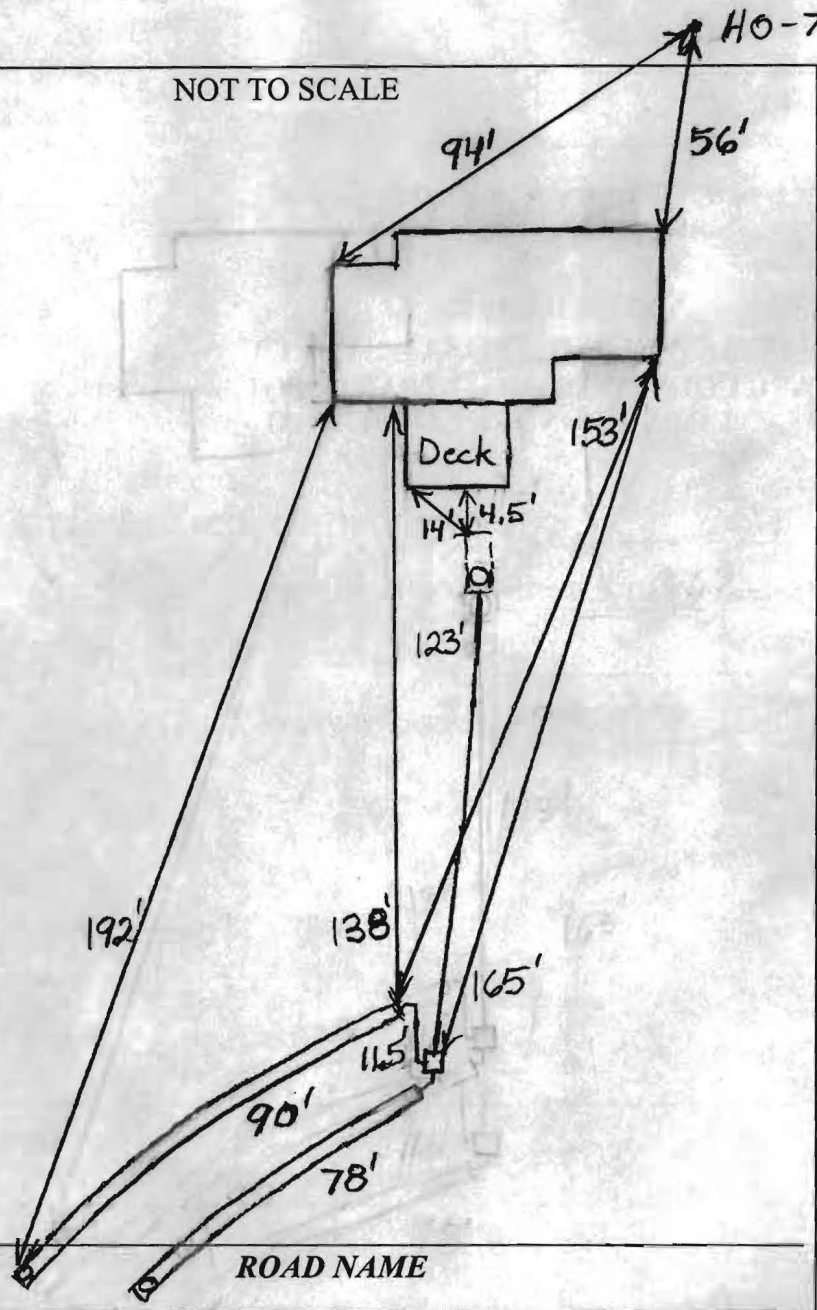

TRENCH/DRAINFIELD DATA		
WIDTH	INLET	BOTTOM
3'	4.5'	7'
NUMBER OF TRENCHES		2
TOTAL LENGTH		168'
ABSORPTION AREA		504 + Sidewall
DISTRIBUTION BOX LEVEL		Levelers
DISTRIBUTION BOX BAFFLE		Yes
DISTRIBUTION BOX PORT		No

SEPTIC TANK DATA	
SEPTIC TANK 1 LEVEL	_____
MANUFACTURER	_____
CAPACITY	_____ GAL
SEAM LOC	Midseam
TANK LID DEPTH	3-3.5'
BAFFLES	_____
BAFFLE FILTER	No
MANHOLE LOC	Rear
6" PORT LOC	_____
WATERTIGHT TEST	No
SLOTTED	No
DATE ON LID	No
PUMP/SEPTIC TANK LEVEL N/A	
MANUFACTURER _____	
CAPACITY _____ GAL	
SEAM LOC _____	
TANK LID DEPTH _____	
BAFFLES _____	
BAFFLE FILTER _____	
MANHOLE LOC _____	
6" PORT LOC _____	
WATERTIGHT TEST _____	
SLOTTED _____	
DATE ON LID _____	

PRE-CONSTRUCTION:

12/1/2011 Partial layout done, (BB)

12/5/2011 Laid out trenches. Started getting measurements, (BB)

INSTALLATION: 12/5/2011 System finished. O.K. to backfill (BB)

FINAL INSPECTOR B. Baker

DATE OF APPROVAL 12/5/2011