

# PERMIT

SEWAGE DISPOSAL SYSTEM

MARYLAND STATE DEPARTMENT OF HEALTH\*

HOWARD COUNTY

ELLICOTT CITY

DISTRICT 5th

DATE 12-2-80

**INDEXED**

4/1/81  
P 31057  
A 30742

Dale Maisel,

IS PERMITTED TO INSTALL  ALTER

5/31/83 now 4349 Maisel Farm Lane

ADDRESS 12789 Folly Quarter Rd, Ellicott, City, Md. PHONE ~~XXXXXXXX~~ 531-5252

SUBDIVISION \_\_\_\_\_ ROAD 12789 Folly Quarter Rd LOT \_\_\_\_\_

PROPERTY OWNER Dale Maisel

ADDRESS 12789 Folly Quarter (Follow signs to Stevely Country School, go thru school grounds to Clearly Driveway then bear left on gravel drive to house)

SPECIFICATIONS **4 Bedrooms**

SEPTIC TANK CAPACITY 1250 GALLONS

DRAIN FIELD \_\_\_\_\_ DEPTH \_\_\_\_\_ FEET, BOTTOM AREA \_\_\_\_\_ SQ. FT.

DEEP TRENCH \_\_\_\_\_ DEPTH \_\_\_\_\_ FEET, BOTTOM AREA \_\_\_\_\_ SQ. FT.

dry well SEEPAGE PITS  ABSORBENT SIDE-WALL AREA 150 SQ. FT. per bedroom

INLET PIPE 2 1/2 FT. BELOW ORIGINAL GRADE. MAXIMUM DEPTH 8 1/2 FT. BELOW ORIGINAL GRADE

EFFECTIVE DEPTH AT \_\_\_\_\_ FT. BELOW ORIGINAL GRADE.

LOCATE DISPOSAL AREA \_\_\_\_\_ FT. FROM \_\_\_\_\_ LOT LINE AND \_\_\_\_\_ FT. FROM \_\_\_\_\_ LOT LINE AS SEEN WHEN FACING LOT FROM



Location: Dry well 90' from right rear corner of existing frame house to back of lot. (Wooded area) Dry well and/or trenches. If trenches used need: (1) 2 inspections of trench before and after stone installed required. (2) Run trenches on contour. (3) 5' earth buffer needed between dry well and trench.

PLANS APPROVED BY Charles B. Streaker DATE 7-2-80

COVER NO WORK UNTIL INSPECTED AND APPROVED.

NEITHER THE HOWARD COUNTY COUNCIL NOR THE HEALTH DEPARTMENT IS RESPONSIBLE FOR THE SUCCESSFUL OPERATION OF ANY SYSTEM.

NOTE: IF TRENCH IS USED CALL FOR INSPECTION BEFORE PLACING GRAVEL IN TRENCH.

NOTE: NO DRY WELL SHALL EXCEED 15 FOOT IN DIAMETER.


NOTE: ALL PIPE FROM HOUSE TO DISPOSAL AREA MUST BE CAST IRON.

PERMIT VOID AFTER THREE YEARS.

NOTE: INSTALL STAND PIPE ON SEPTIC TANK AND DRY WELL. STAND PIPES MUST BE 6 INCHES IN DIAMETER. CAST IRON, CONCRETE OR TERRAZO ACCEPTED.

**\*INSTALLER IS RESPONSIBLE FOR OBTAINING FINAL APPROVAL ON THIS PERMIT.**

A 30742  
4/1/81

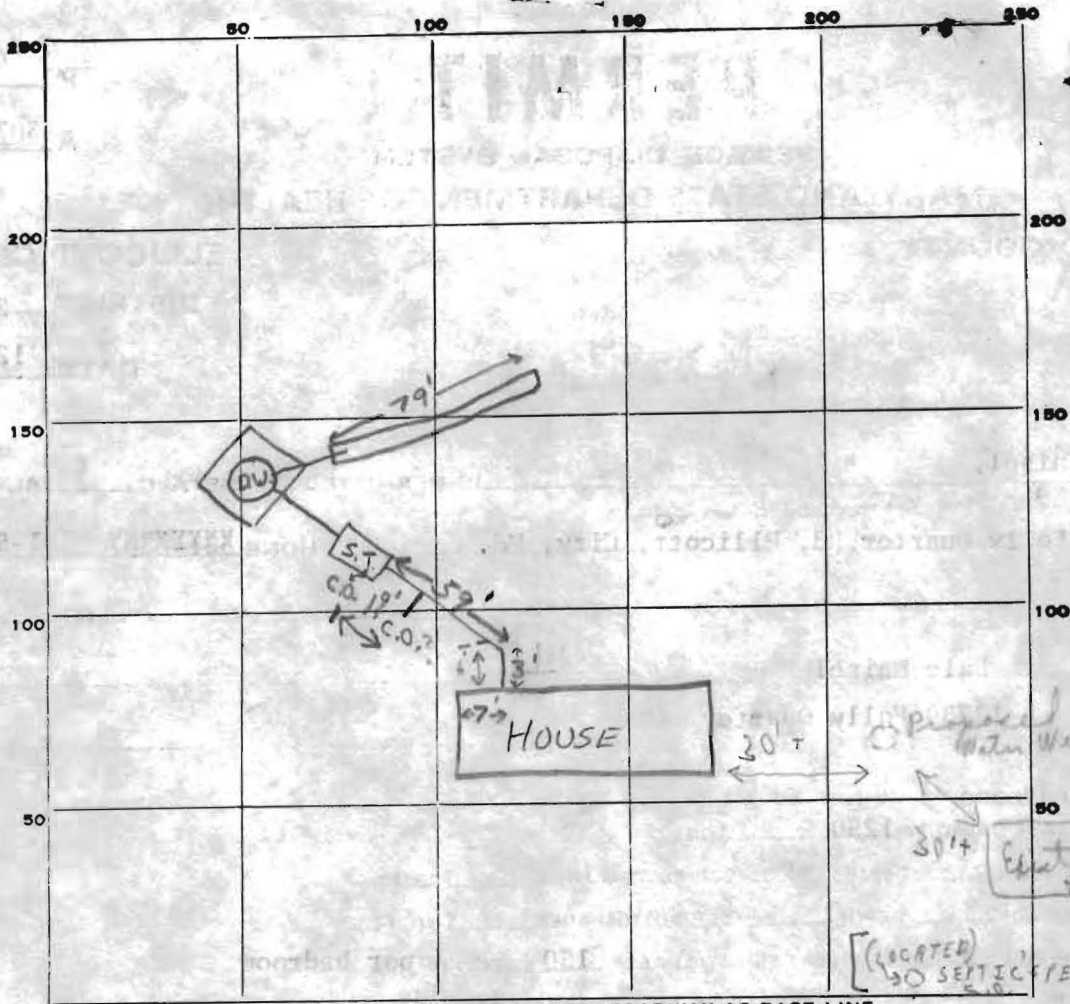

INDICATE NORTH. - NAME ADJOINING ROADWAY AS BASE LINE.

PERMIT CARD  on file near S. Tank

C.I.	C.I.	C.I.
S.T.	D.W.	C.O.
<input checked="" type="checkbox"/>	<input checked="" type="checkbox"/>	<input checked="" type="checkbox"/>

SEPTIC TANK, LEVEL

DISTRIBUTION BOX, LEVEL na

TILE FIELD, DEPTH 8 1/2 - 9 FT. TRENCH WIDTH 2 FT.

GRAVEL DEPTH 5 FT. TOTAL LENGTH 79 FT. 395

NUMBER OF TRENCHES 1 1/2 SIDEWALL  
TOTAL BOTTOM AREA

SEEPAGE PITS, INSIDE DIAMETER 50 FT. DEPTH BELOW INLET ~6 FT. 300# in D.W.

Total ABSORBENT AREA 695 SQ. FT.

REMARKS 3/31/81 Install cleanout to grade in house sewer line between house and septic tank, O.K. to cover work from house to beginning of trench. Install gravel & pipe in trench. Call for first inspection before covering trench & S.  
4/1/81 PAPER ON TRENCH TO 3 1/2' OF GRADE & C.O. PLUG, IN LINE, VISIBLE 19' FROM SEPTIC TANK'S CLEANOUT.

C.B.D.

DATE SYSTEM APPROVED 4/1/81 INSPECTOR C.B. Stueker

George Richardson  
septic installer

Proposed Water Well

Electric Stone + Gravel Trench

(LOCATED) 30 SEPTIC TANK PER MR. MAISEL 4/1/81

FIND OUT WHERE SETTLE IS  
ON LOT 4

WHAT LOT DO RECORDS

A 31057 GO TO

7/27/98

House beside

stone house

Lot 5

**HATFIELD'S EQUIPMENT AND  
DEDICATION SERVICES, INC.**

**(301) 854-6172**


**13785 Burnt Woods Road  
Glenelg, Maryland 21737**

**Fax (410) 489-4905**

Howard County Health Department  
Attention: Stuart

The septic abandonment has been completed on 6/30/05 for 12789 Folly Quarter Road. Glenelg Manor Farms, Ellicott City. The house is ready for the demo permit. Please send permit to Tracy Griffin c/o Heritage Realty. 3060 Washington Road (Route 97) Suite 220 Glenwood, MD 21738.

Thank You

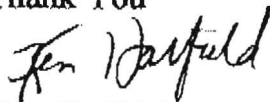  
Ken Hatfield.  
7/1/05

HOUSE

FIRST FLOOR ELEV. 546.5  
 BASEMENT ELEV. 536.5  
 INVERT @ HOUSE 536.89

SEPTIC TANK:  
 EXISTING GRADE 541.0  
 PROPOSED GRADE 541.0  
 INVERT OF TANK 536.87

DRYWELL:  
 EXISTING GRADE 538.0  
 PROPOSED GRADE 538.0  
 DRYWELL INVERT 535.70



VICINITY Map  
 SCALE 1"=2,000'



GH  
 DA  
 To  
 D  
 SW  
 Ho  
 Sea